
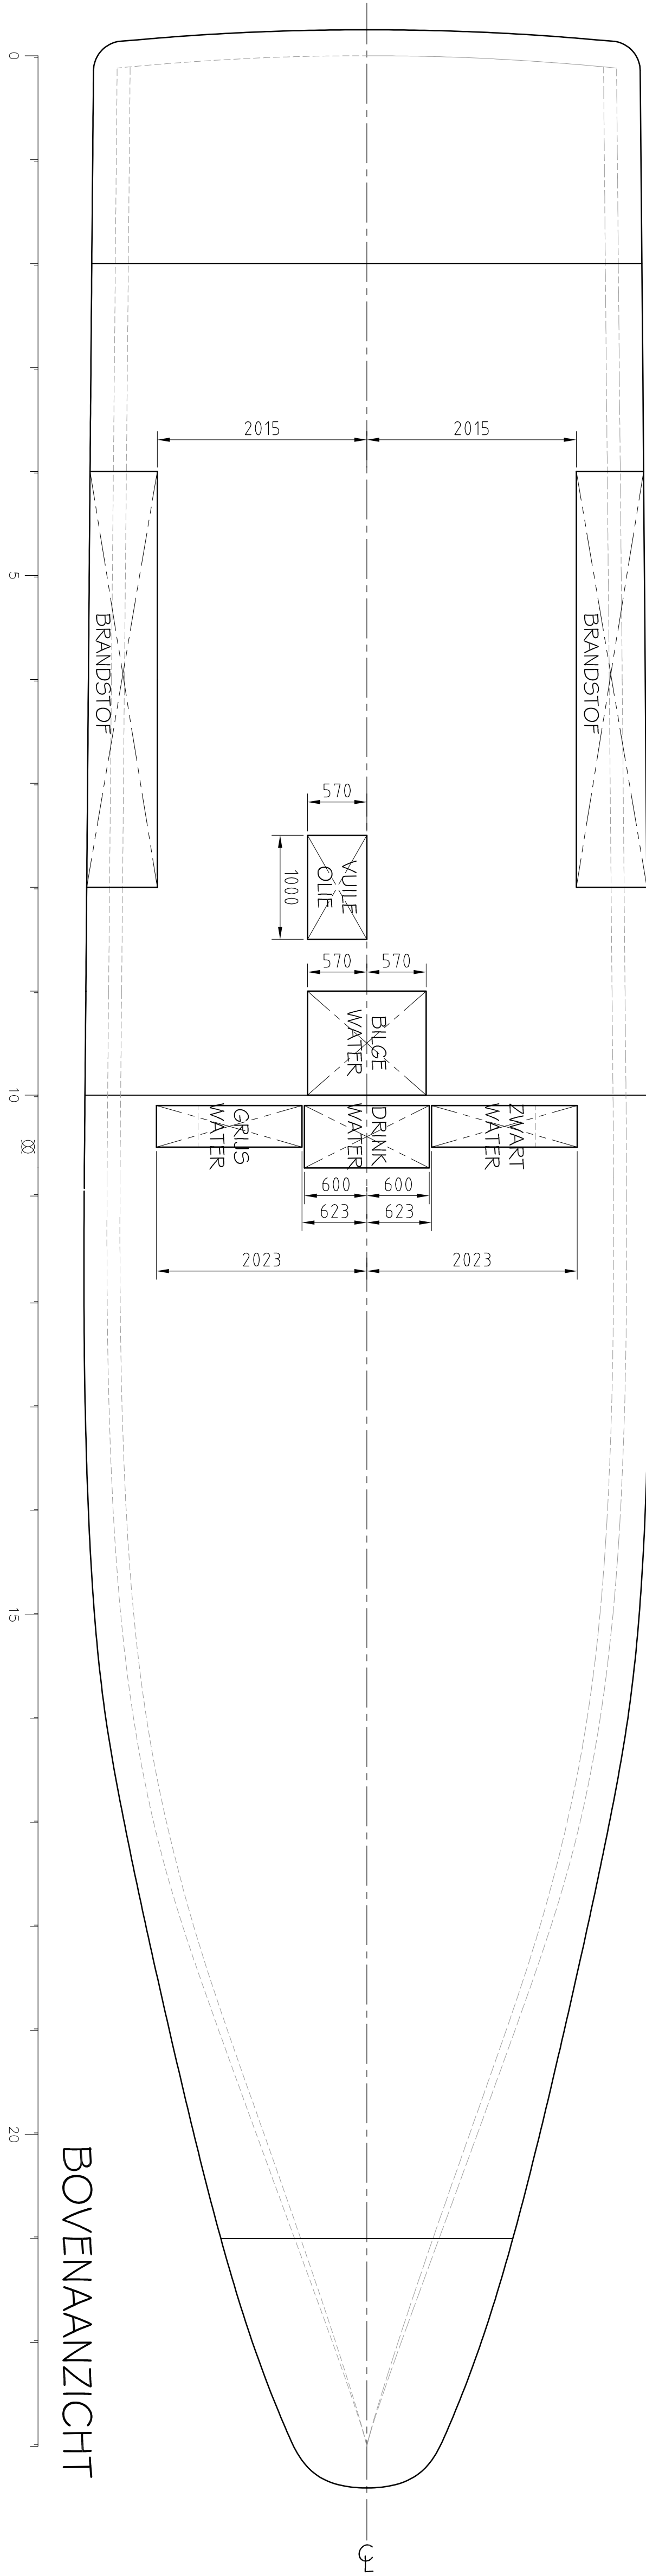


TANK	SPANT	INHOUUD
BRANDSTOF TANK	4-8 SB	3250 LITER
BRANDSTOF TANK	4-8 BB	3250 LITER
VUILE OIL TANK	7½-8½ SB	180 LITER
BILGE WATER TANK	9-10	400 LITER
ZWART WATER TANK	10-11 BB	336 LITER
GRIS WATER TANK	10-11 SB	336 LITER
DRINK WATER TANK	10-11	800 LITER

D				
C				
B	PS	30-12-2008		AS BUILT
A	PS	02-10-2007		LOSSE TANKS VERANDERD
O	PS	05-09-2007		INITIAL ISSUE
rev	drawn	date	checked	date
				description

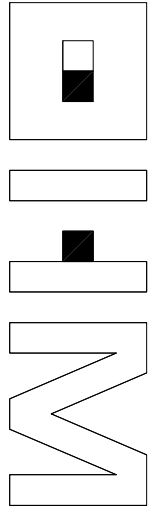

De Haas Maassluis BV
Govert Van Wijnkade 1 - Postbus 2 - 3144 ED - Maassluis
www.dehaasmaassluis.nl
info@dehaasmaassluis.nl
Telefoon: 010-59 135 11 - Fax: 010-59 175 54

AS BUILT

project	RIJKSWATERSTAAT		
subject	TANKENPLAN		
scale	1:40	project id	P070183
		drawing id	P070183-000-003