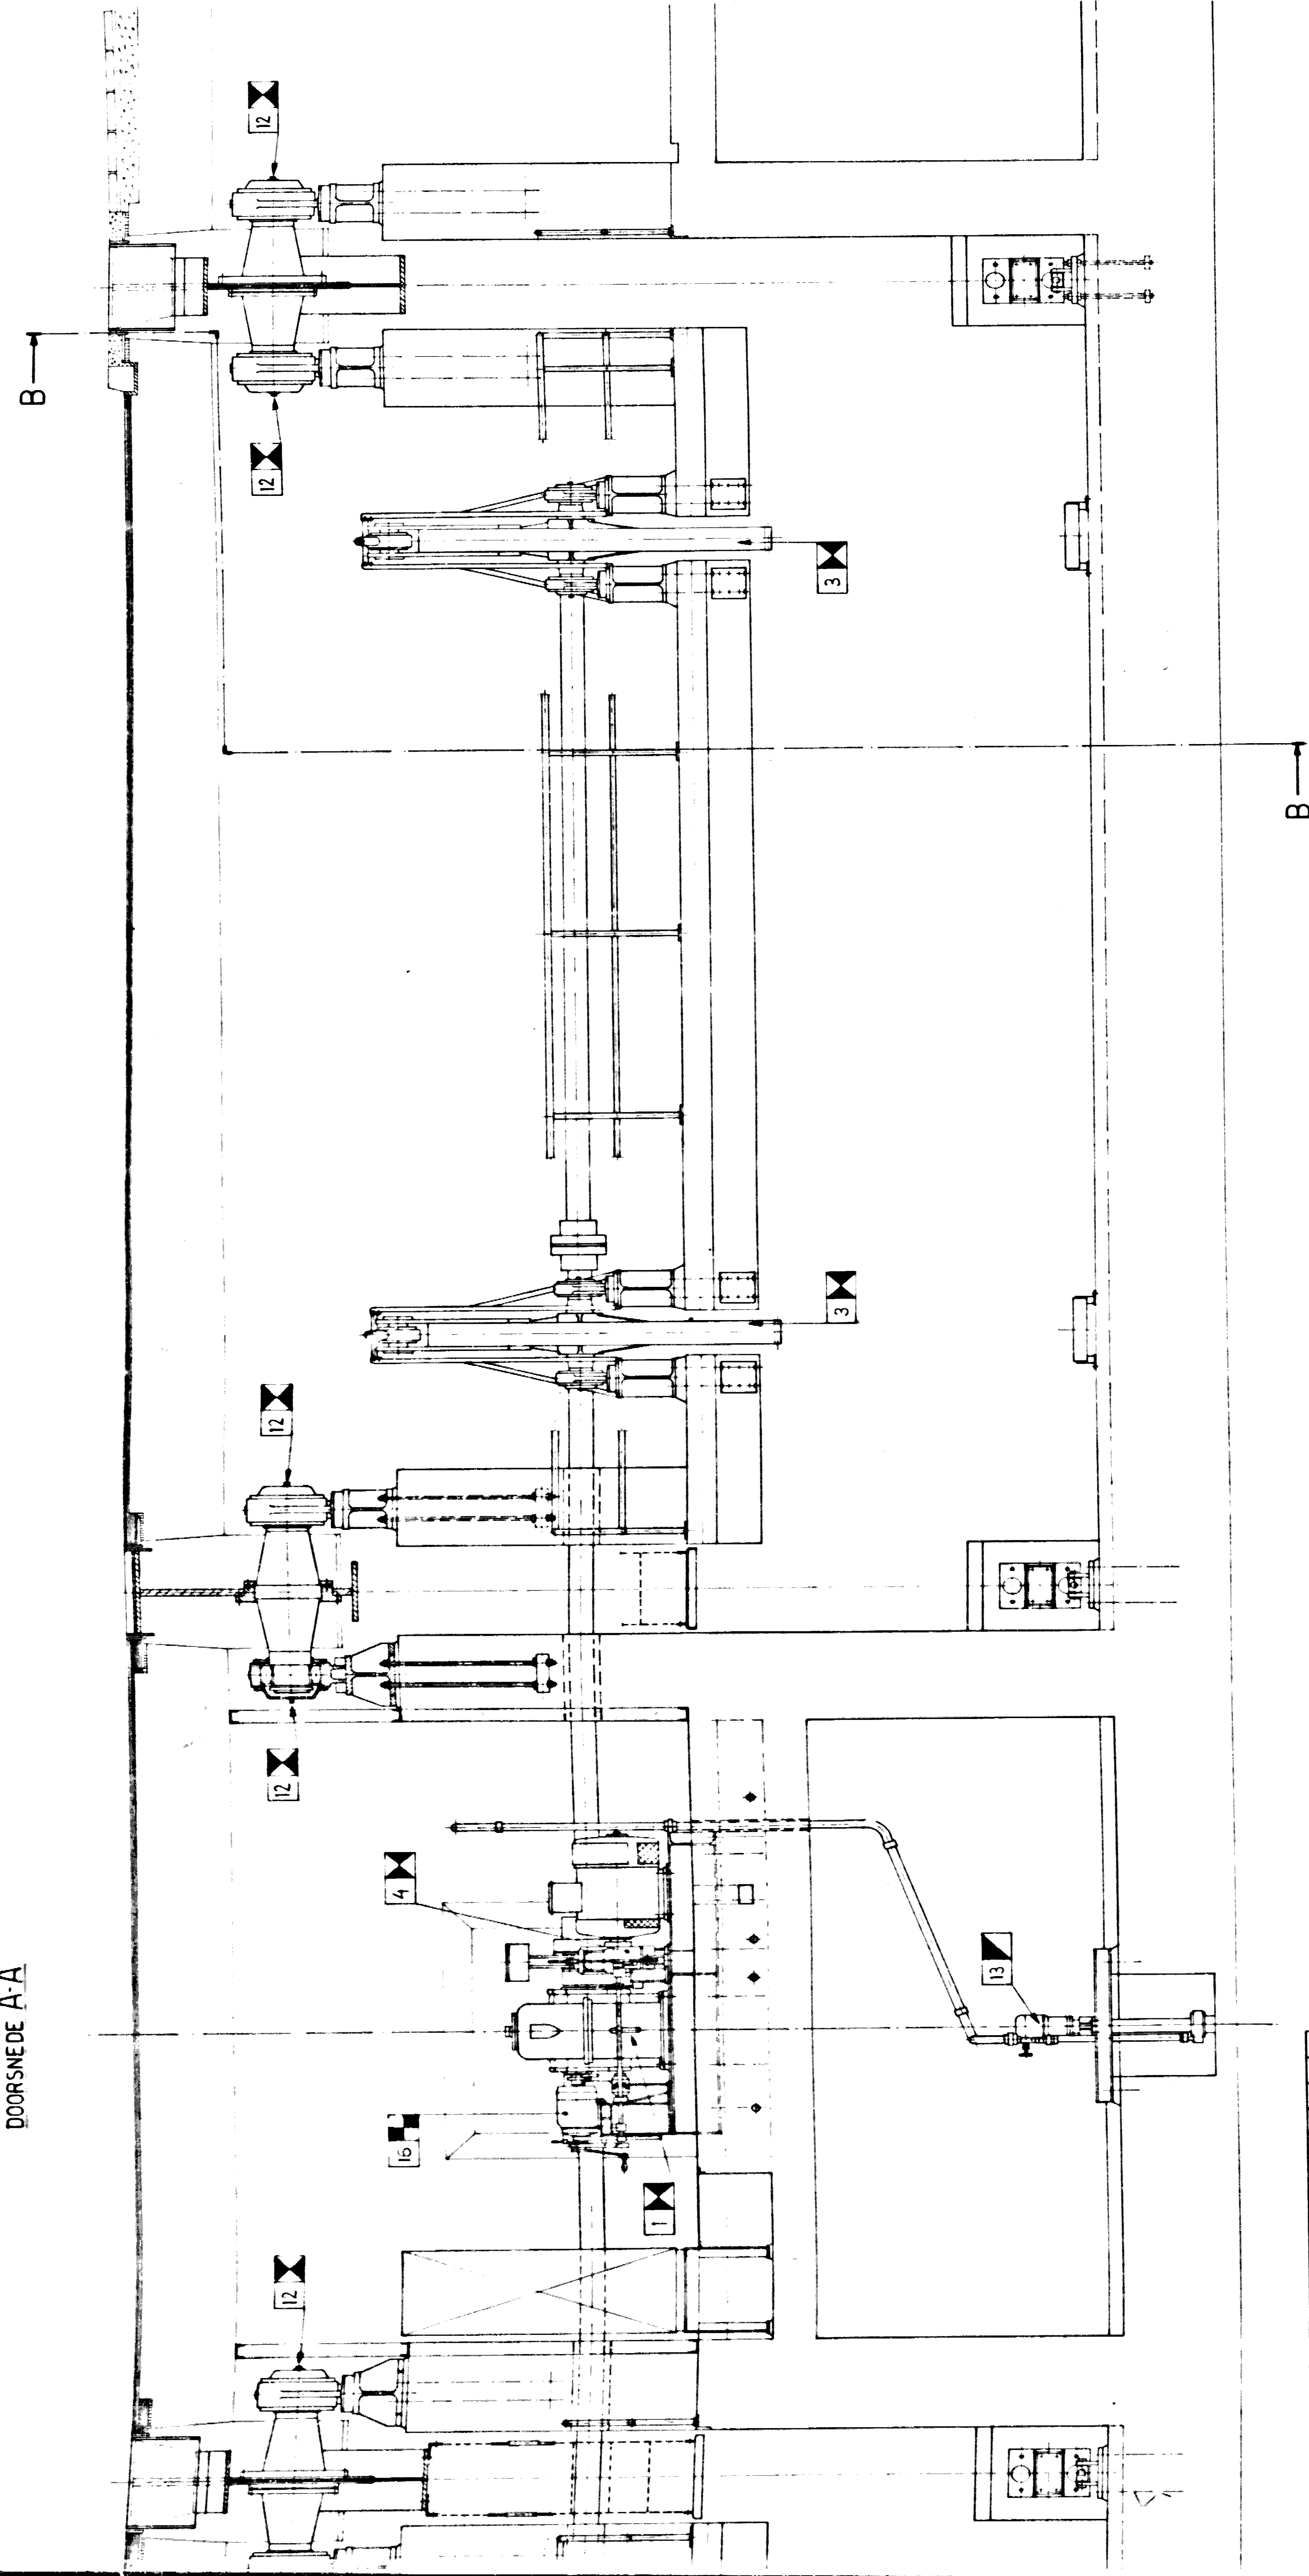
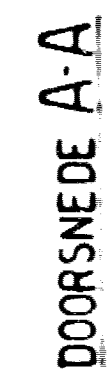
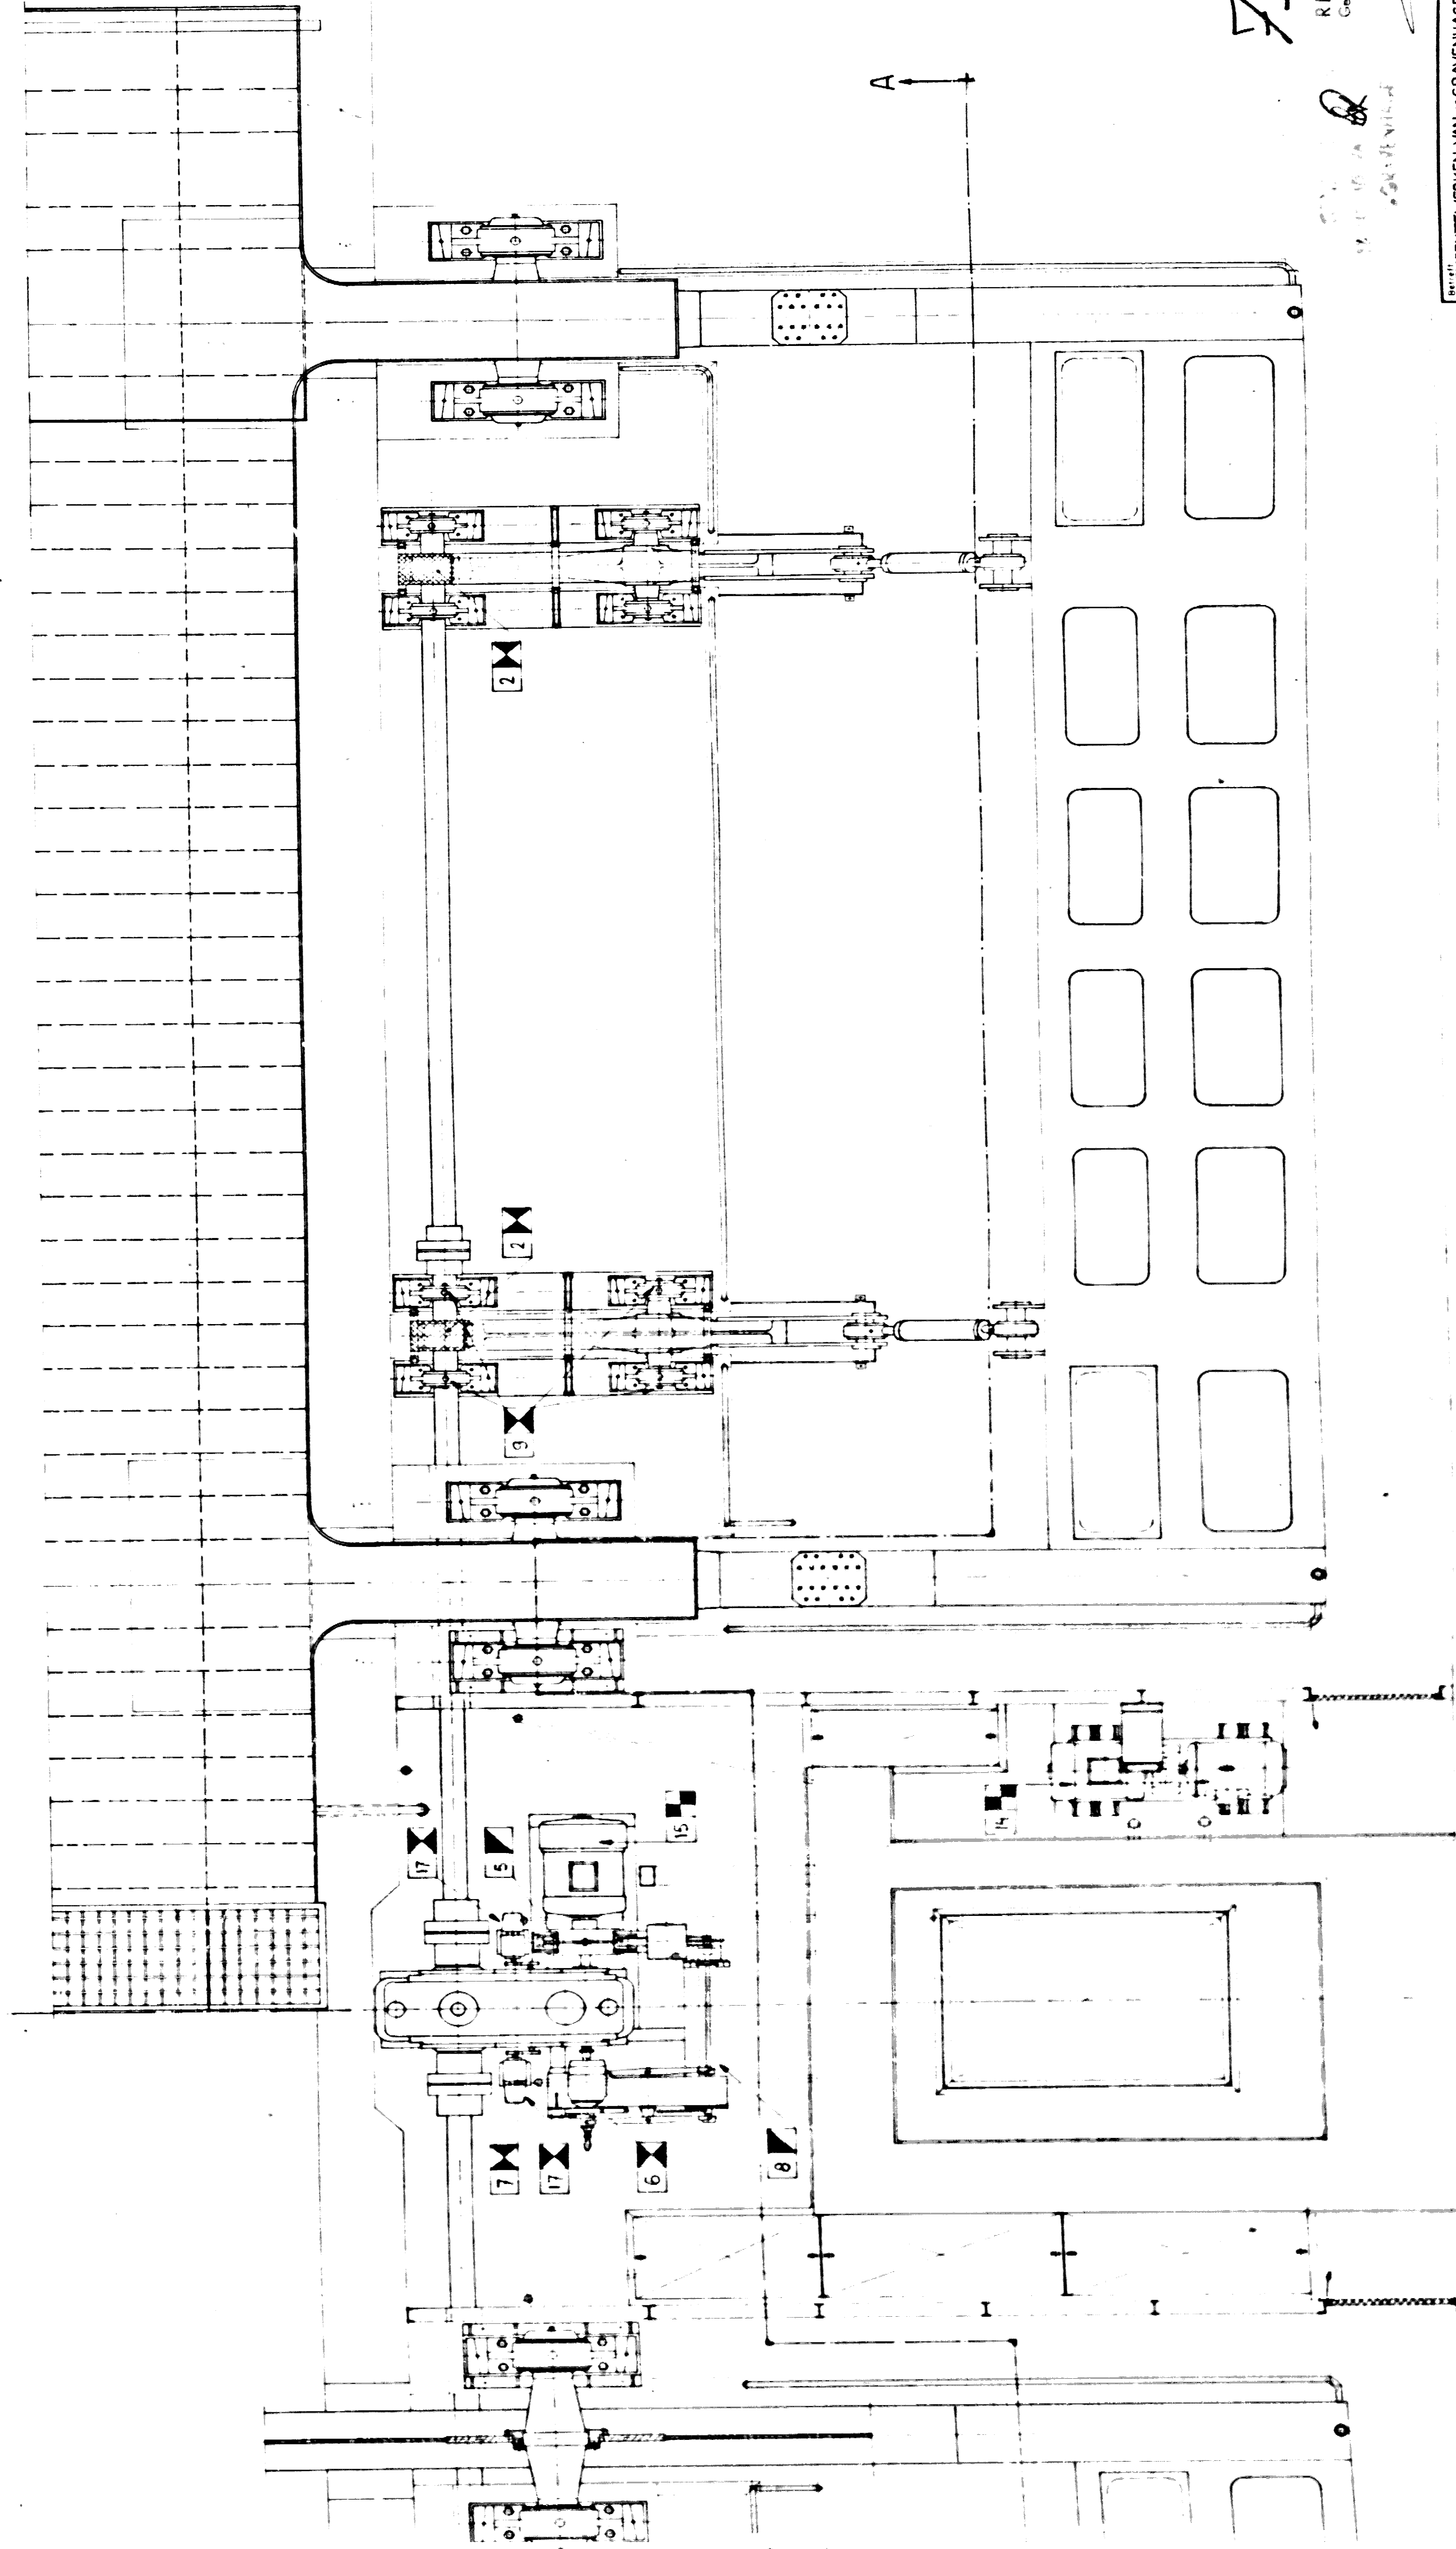


[illegible]

73-2261

REVISIETEKENING

Gezlen de Hoofding:

[illegible]

or your people