




Dwarsdoorsnede (1:200)

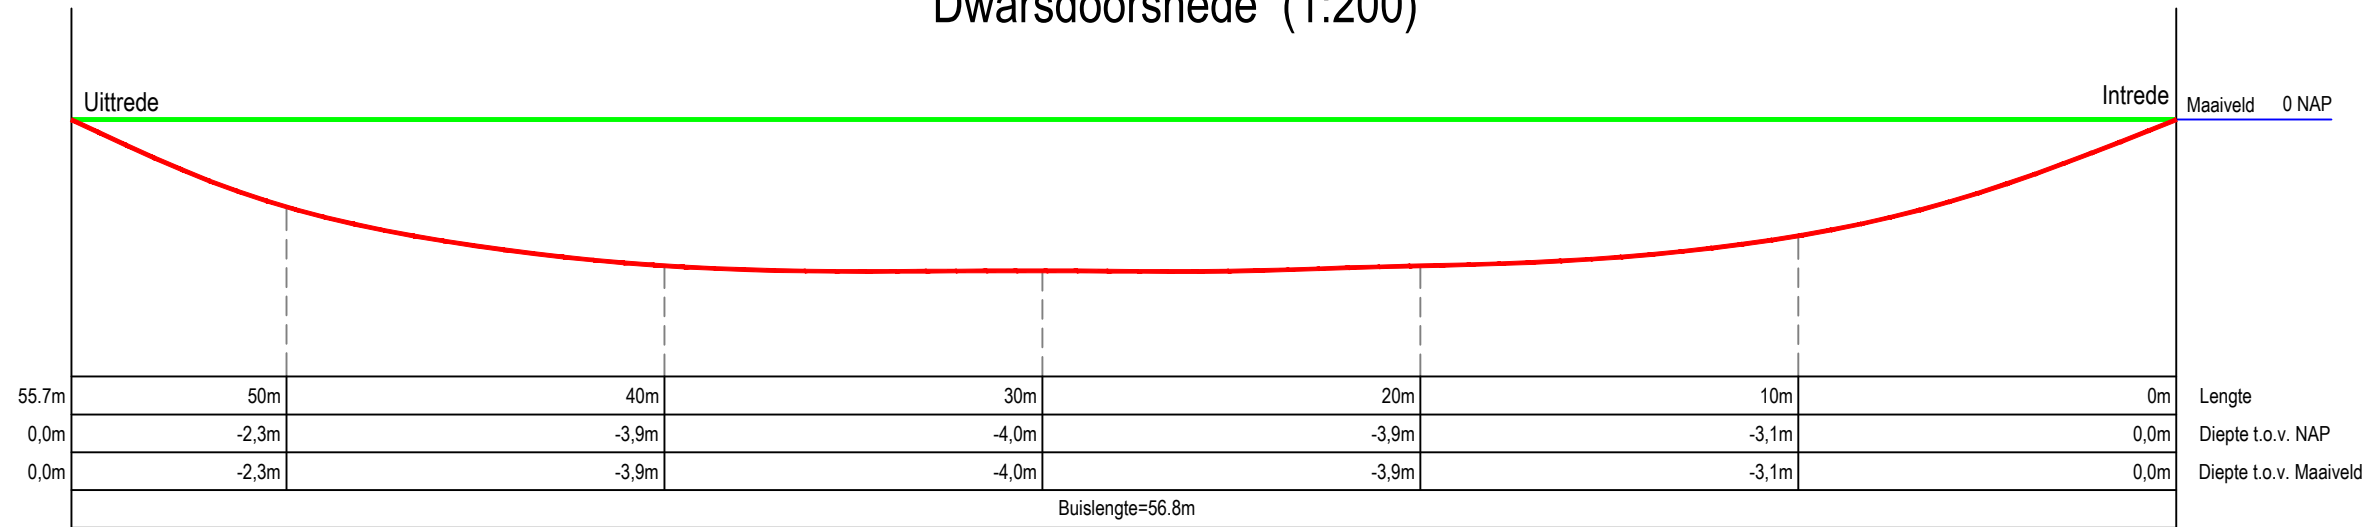

Dwarsdoorsnede buis 1:5
3x Ø160 SDR11

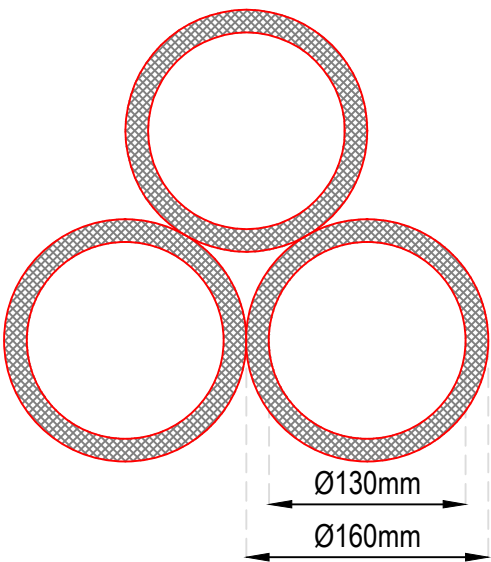

Bovenaanzicht 1:500

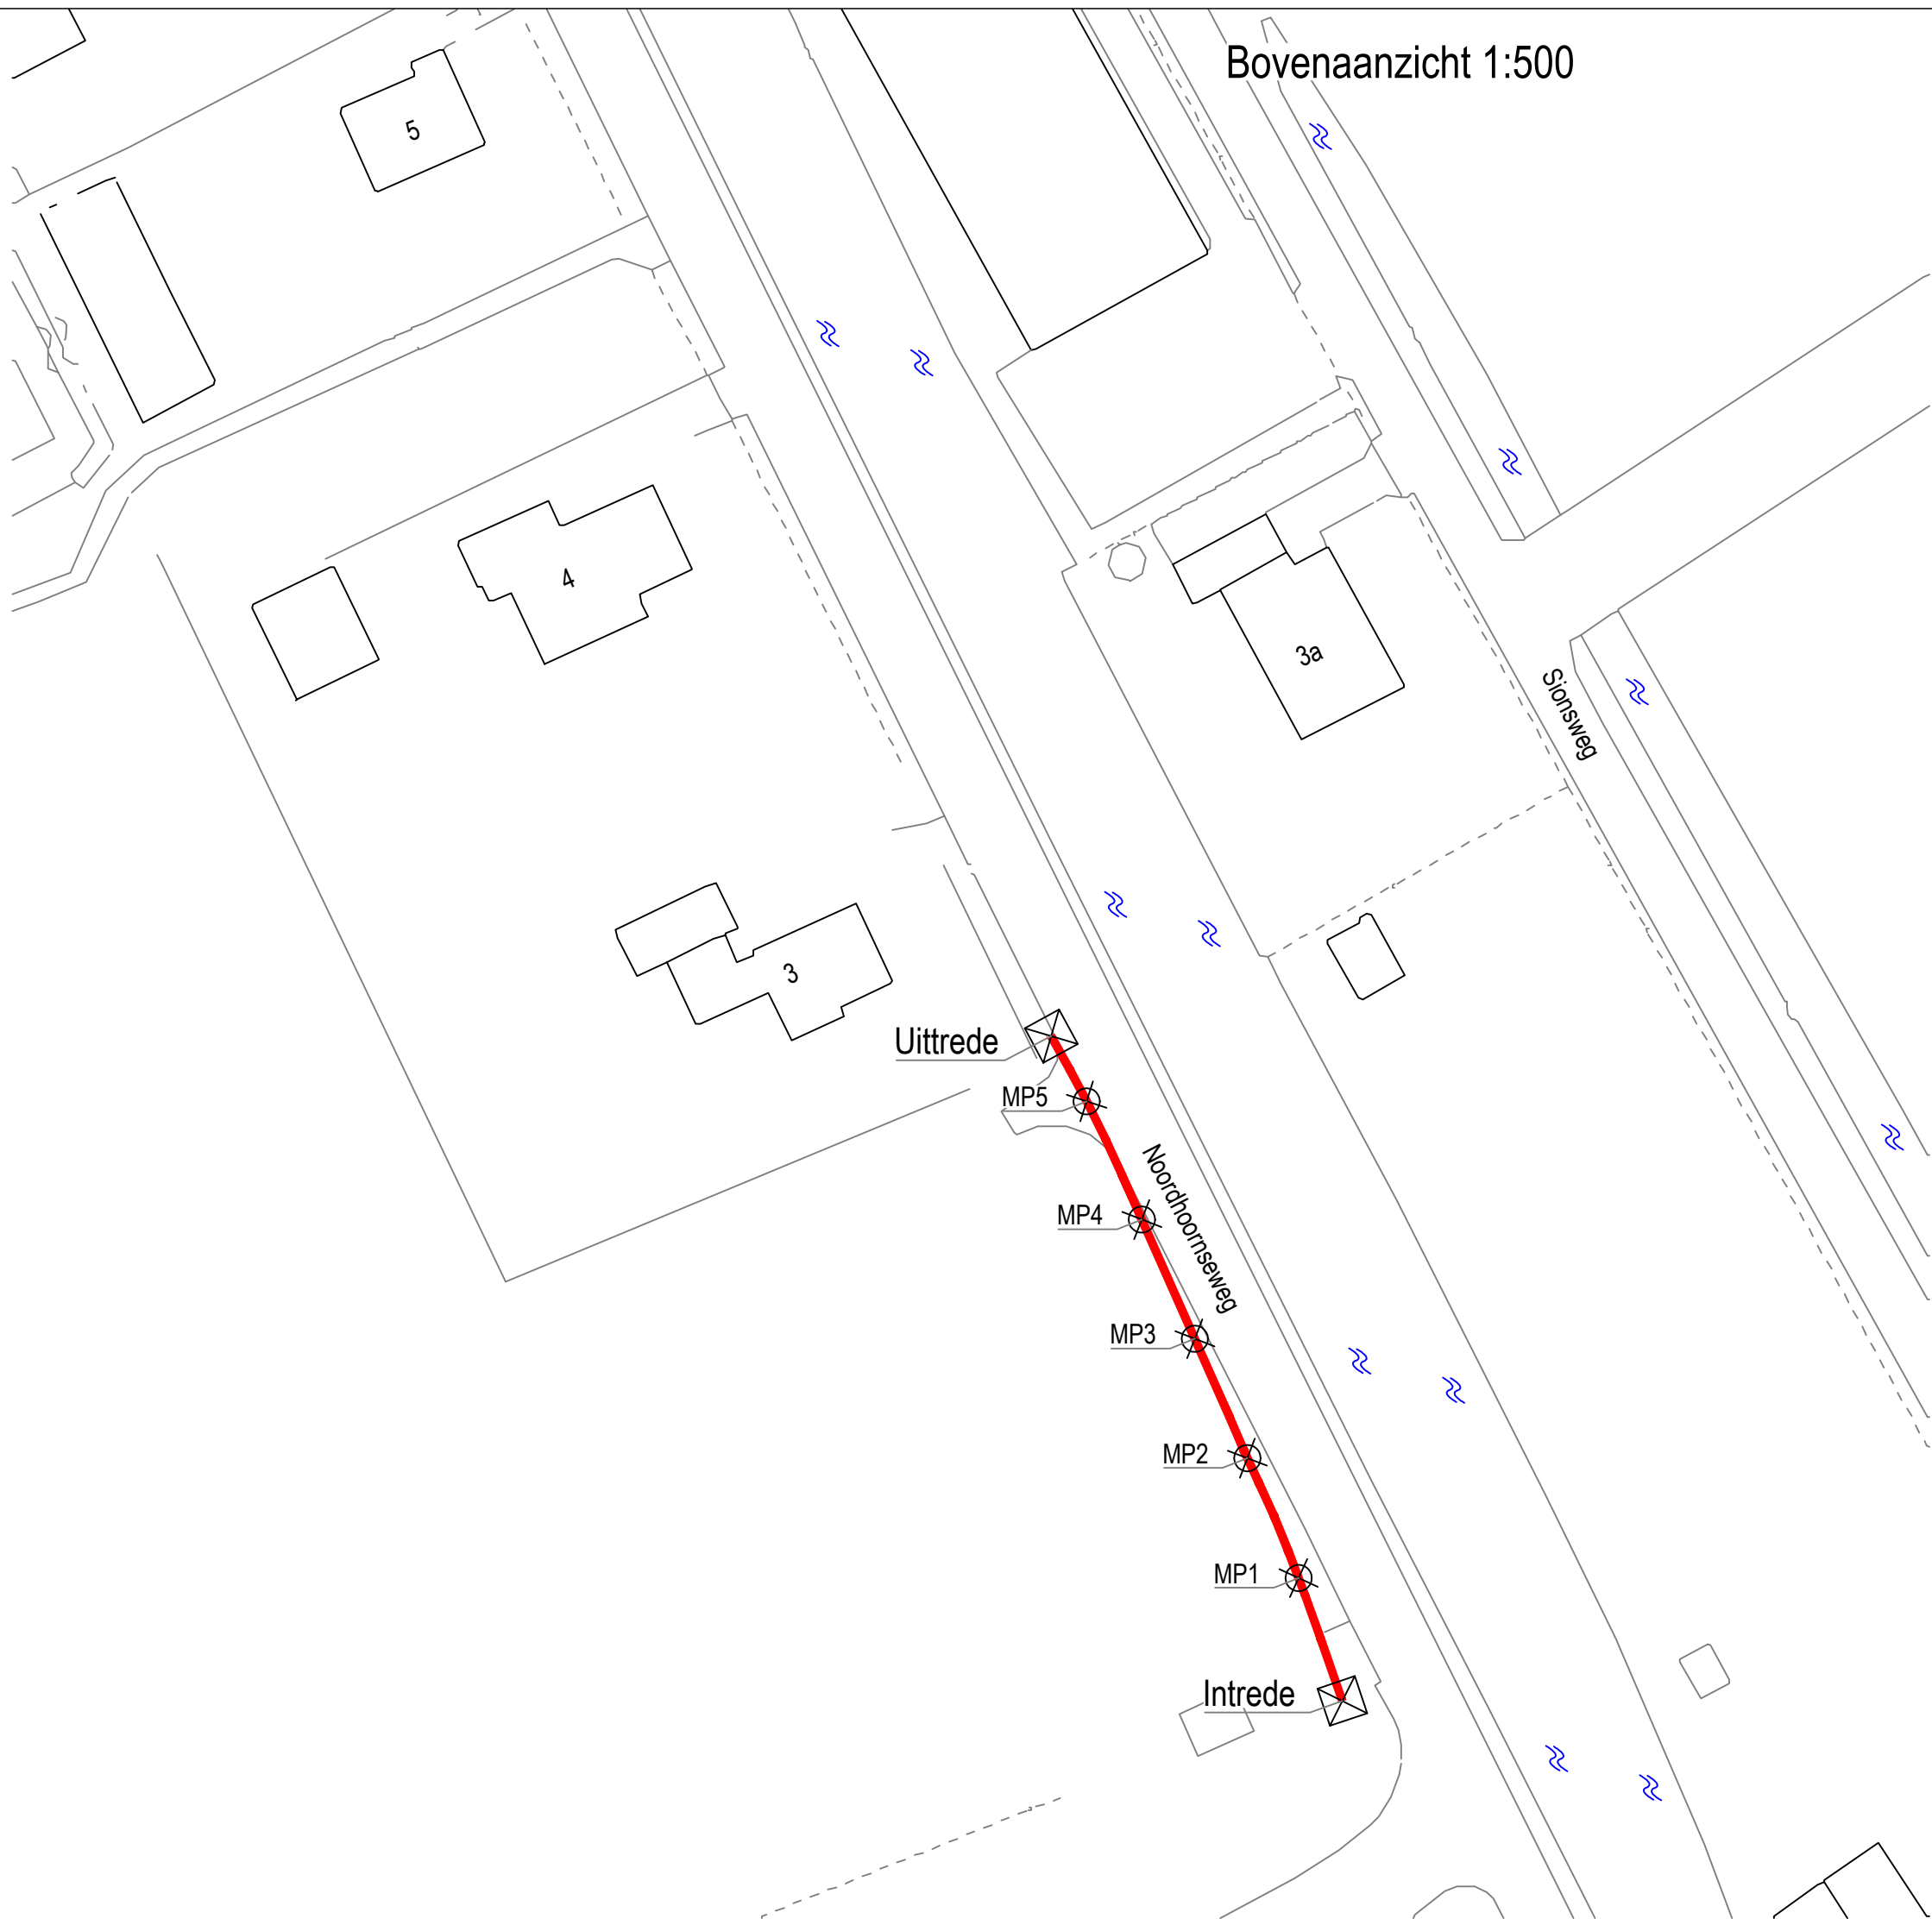

2278

P10

COÖRDINATEN BORING

	X	Y
Intrede	82091.96	447730.69
MeetPunt 1 (MP1)	82088.61	447740.11
MeetPunt 2 (MP2)	82084.68	447749.31
MeetPunt 3 (MP3)	82080.65	447758.46
MeetPunt 4 (MP4)	82076.59	447767.60
MeetPunt 5 (MP5)	82072.36	447776.66
Uittrede	82069.65	447781.66

AS BUILT

- berm / groenstrook / bossage
- asfalt / beton
- klinkers / tegels / voetpad
- fietspad



- bebouwing
- water
- gestuurde boring
- zichtlijn

Welvreugd Drilling B.V.
Burgerweg 5, 3155 DA Maasland

Telefoon : 010-5918247
Fax : 010-5926183
Autotelef. : 06-53134432
E-mail : info@welvreugd.nl

Den Hoorn

Noordhoornseweg nr 3

buis	datum boring	formaat	schaal	getekend	tekeningnummer
3xØ160 SDR11	11-07-2016	A2	1:5/200/500	PB	160711a