


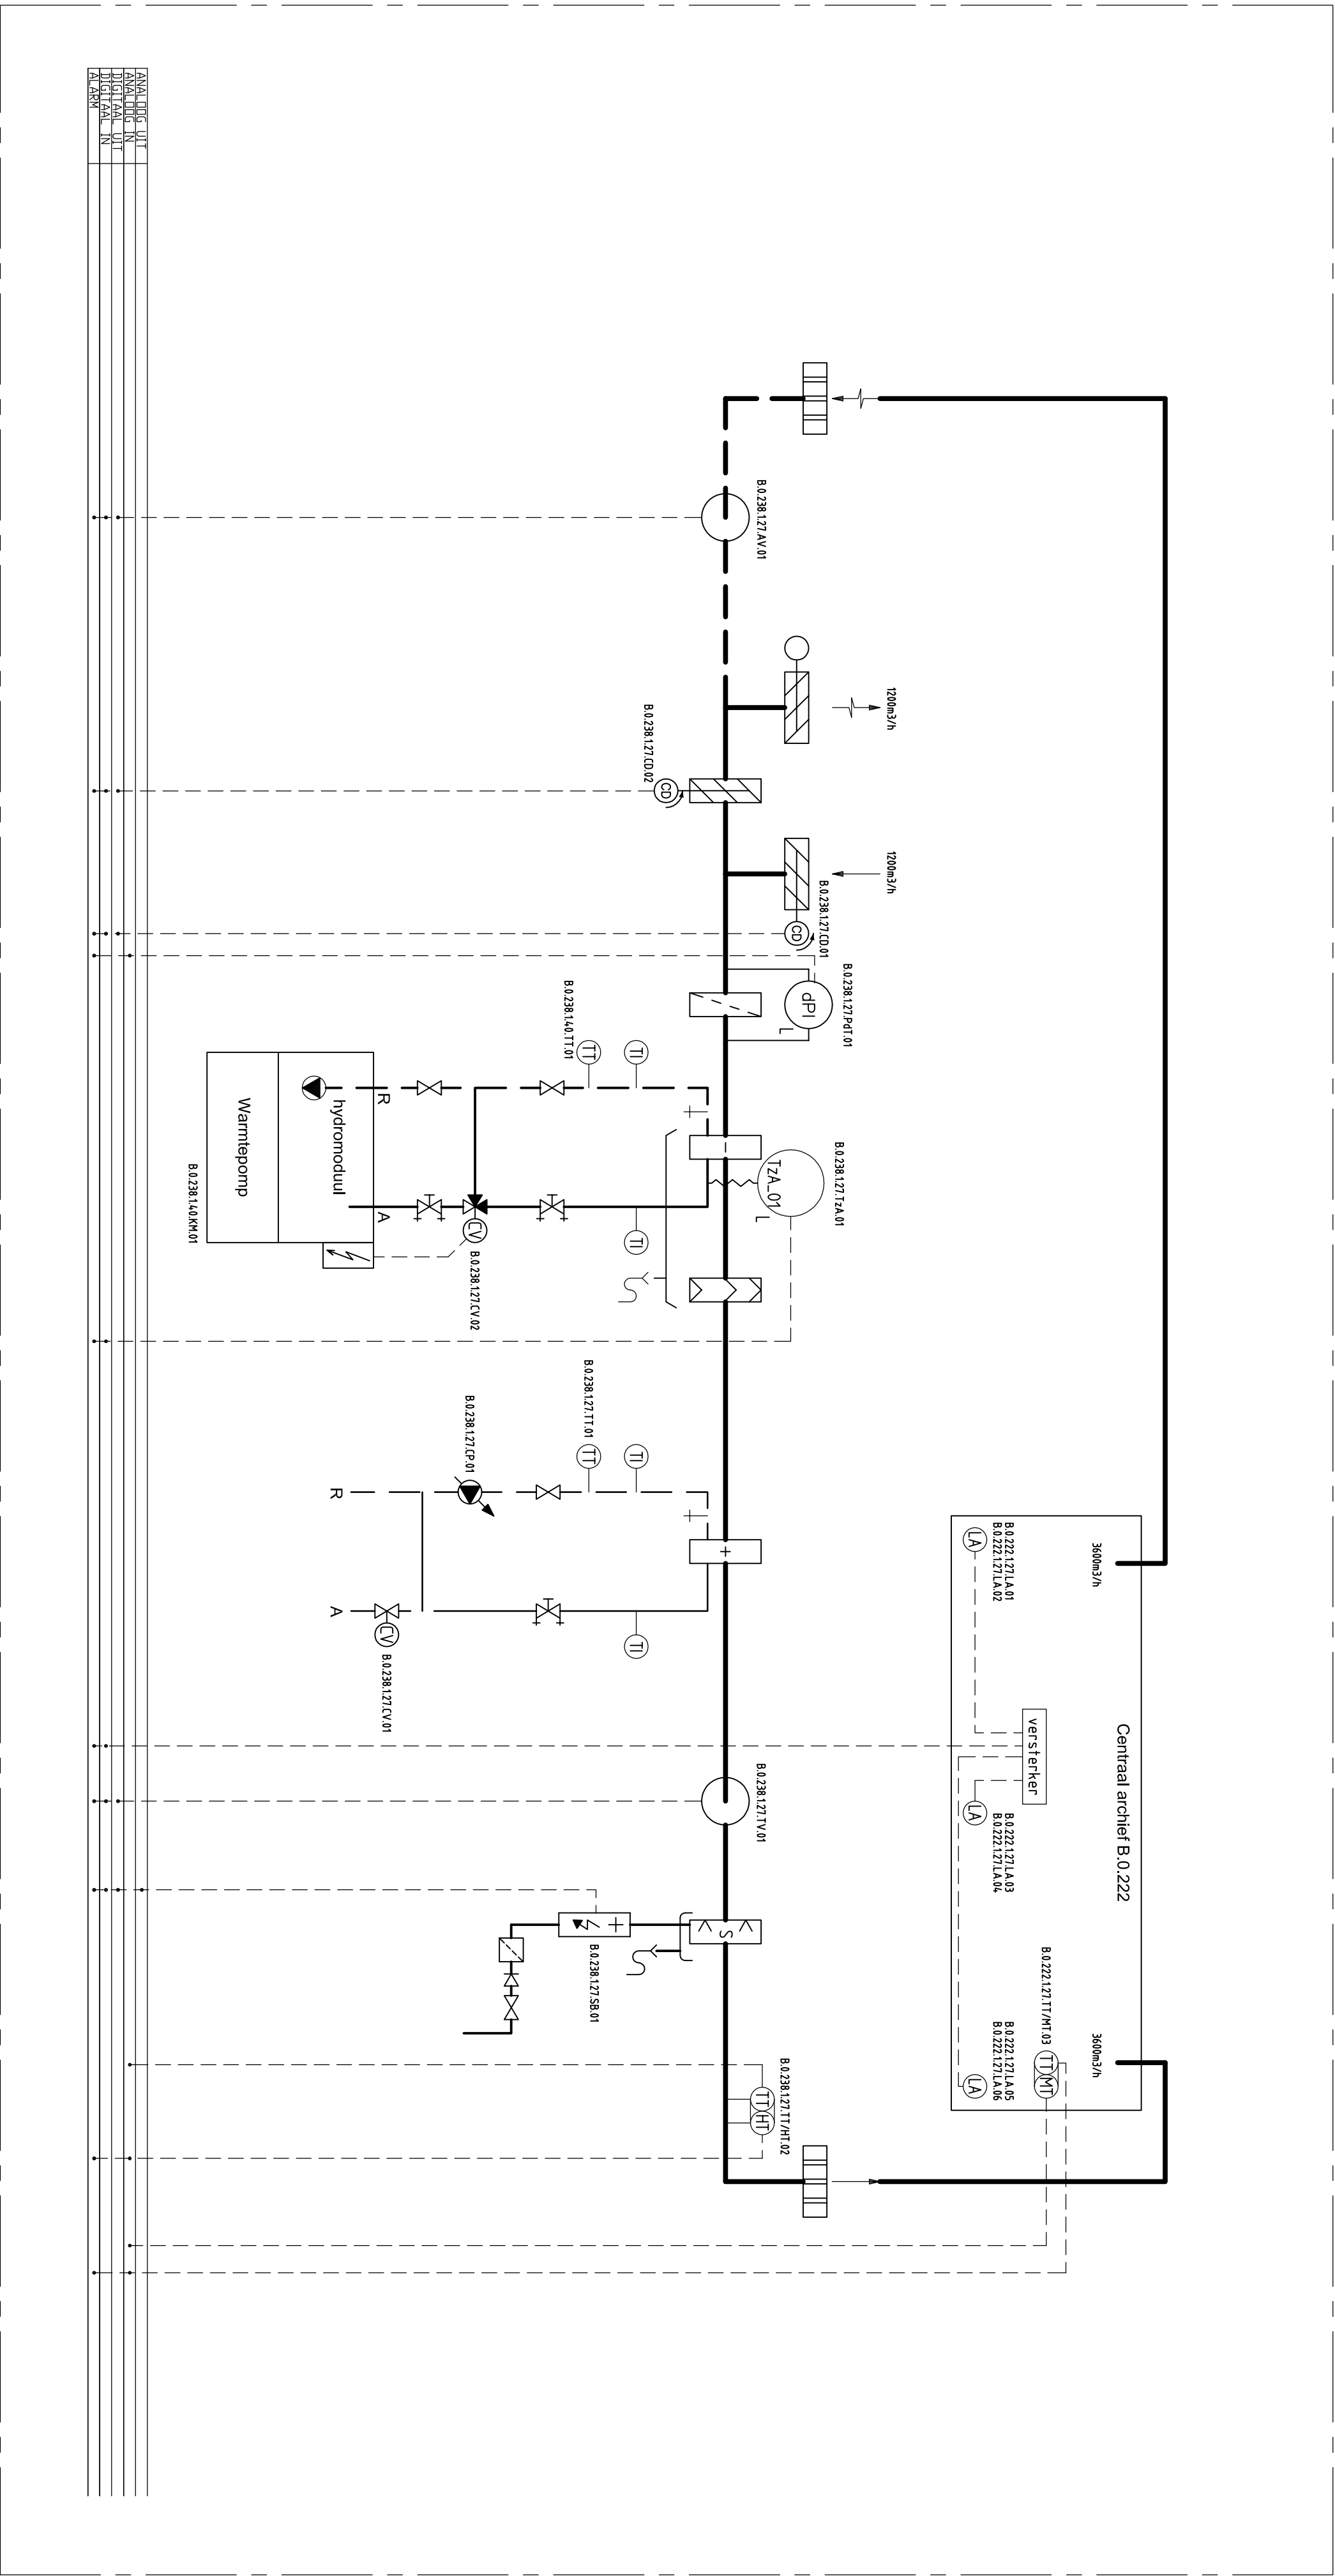

- | | | |
|----------------|--------------|--|
| A ² | Projectnr. : | |
| | 160 308 | |