


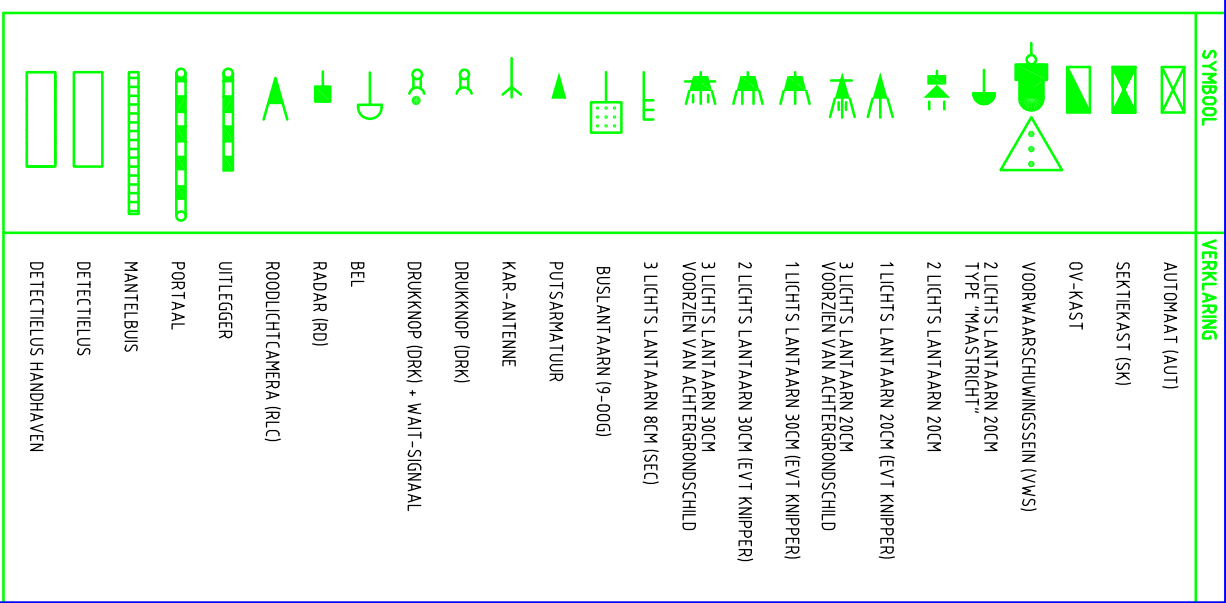

| Van                | Naar            | Doorsnede     |
|--------------------|-----------------|---------------|
| Automaat FR94-0458 | Lus DS46.2      | UXL 2x15      |
| Automaat FR94-0458 | Lnt 03.1        | EO-YMKas 4x15 |
| Automaat FR94-0458 | Lnt 02.1        | EO-YMKas 4x15 |
| Automaat FR94-0458 | Lus 002.1+D03.1 | UXL 4x15      |
| Automaat FR94-0458 | Lnt 05.1+46.1   | EO-YMKas 8x15 |
| Automaat FR94-0458 | Lnt 23.1+sec    | EO-YMKas 8x15 |
| Automaat FR94-0458 | Lus D23.1       | UXL 2x15      |
| Automaat FR94-0458 | CBP 23.0        | UXL 4x15      |
| Automaat FR94-0458 | Lus D05.1       | UXL 2x15      |
| Automaat FR94-0458 | Lus DS46.1      | UXL 2x15      |
| Automaat FR94-0458 | Lnt 24.1+sec    | EO-YMKas 8x15 |
| Automaat FR94-0458 | Lus D24.1       | UXL 2x15      |
| Automaat FR94-0458 | CBP 24.0        | UXL 4x15      |
| Automaat FR94-0458 | Lus DS47.2      | UXL 2x15      |
| Automaat FR94-0458 | Lnt 07.1+47.1   | EO-YMKas 8x15 |
| Automaat FR94-0458 | Lus 007.1+D08.1 | UXL 4x15      |
| Automaat FR94-0458 | Lus DS47.1      | UXL 2x15      |
| Automaat FR94-0458 | Lnt 08.1        | EO-YMKas 4x15 |

|                                             |                 |      |                                                                                                                                                                                              |                    |            |        |         |
|---------------------------------------------|-----------------|------|----------------------------------------------------------------------------------------------------------------------------------------------------------------------------------------------|--------------------|------------|--------|---------|
| Spike<br>Baljuwlaan / Hoorbaan<br>FR94-0458 | REVISIETEKENING | K458 | <br><br>Aantal bladen: | Naam               | Datum      | Versie | Formaat |
|                                             |                 |      |                                                                                                                                                                                              | Getekend: M.Schuur | 23-11-2010 | 0      | A2      |
|                                             |                 |      | Uitgave                                                                                                                                                                                      | Schaal             |            |        |         |
|                                             |                 |      |                                                                                                                                                                                              | 1:500              |            |        |         |