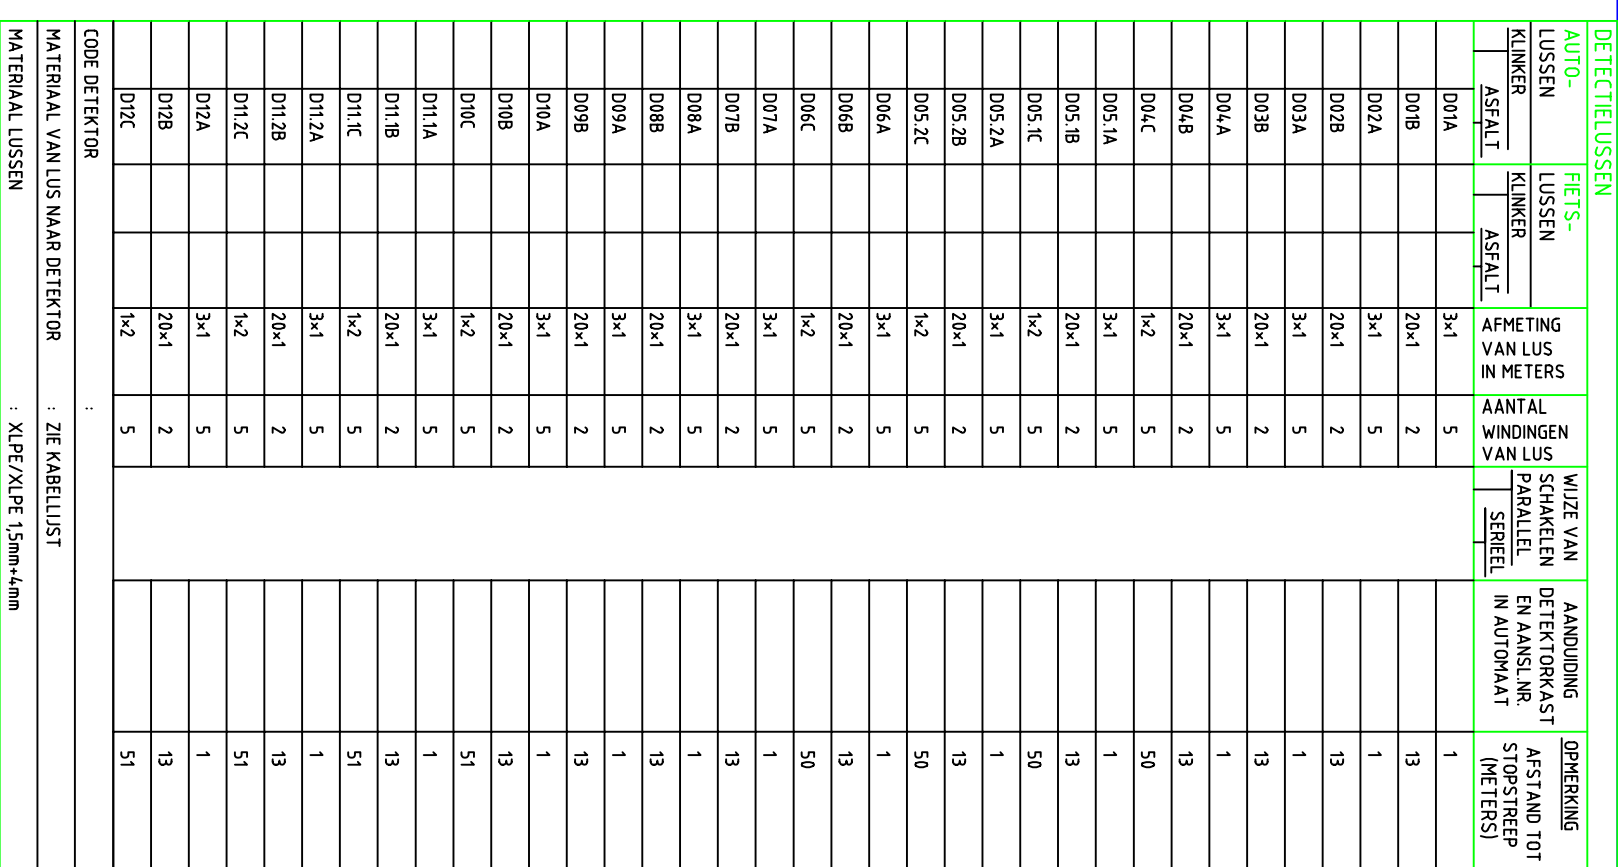
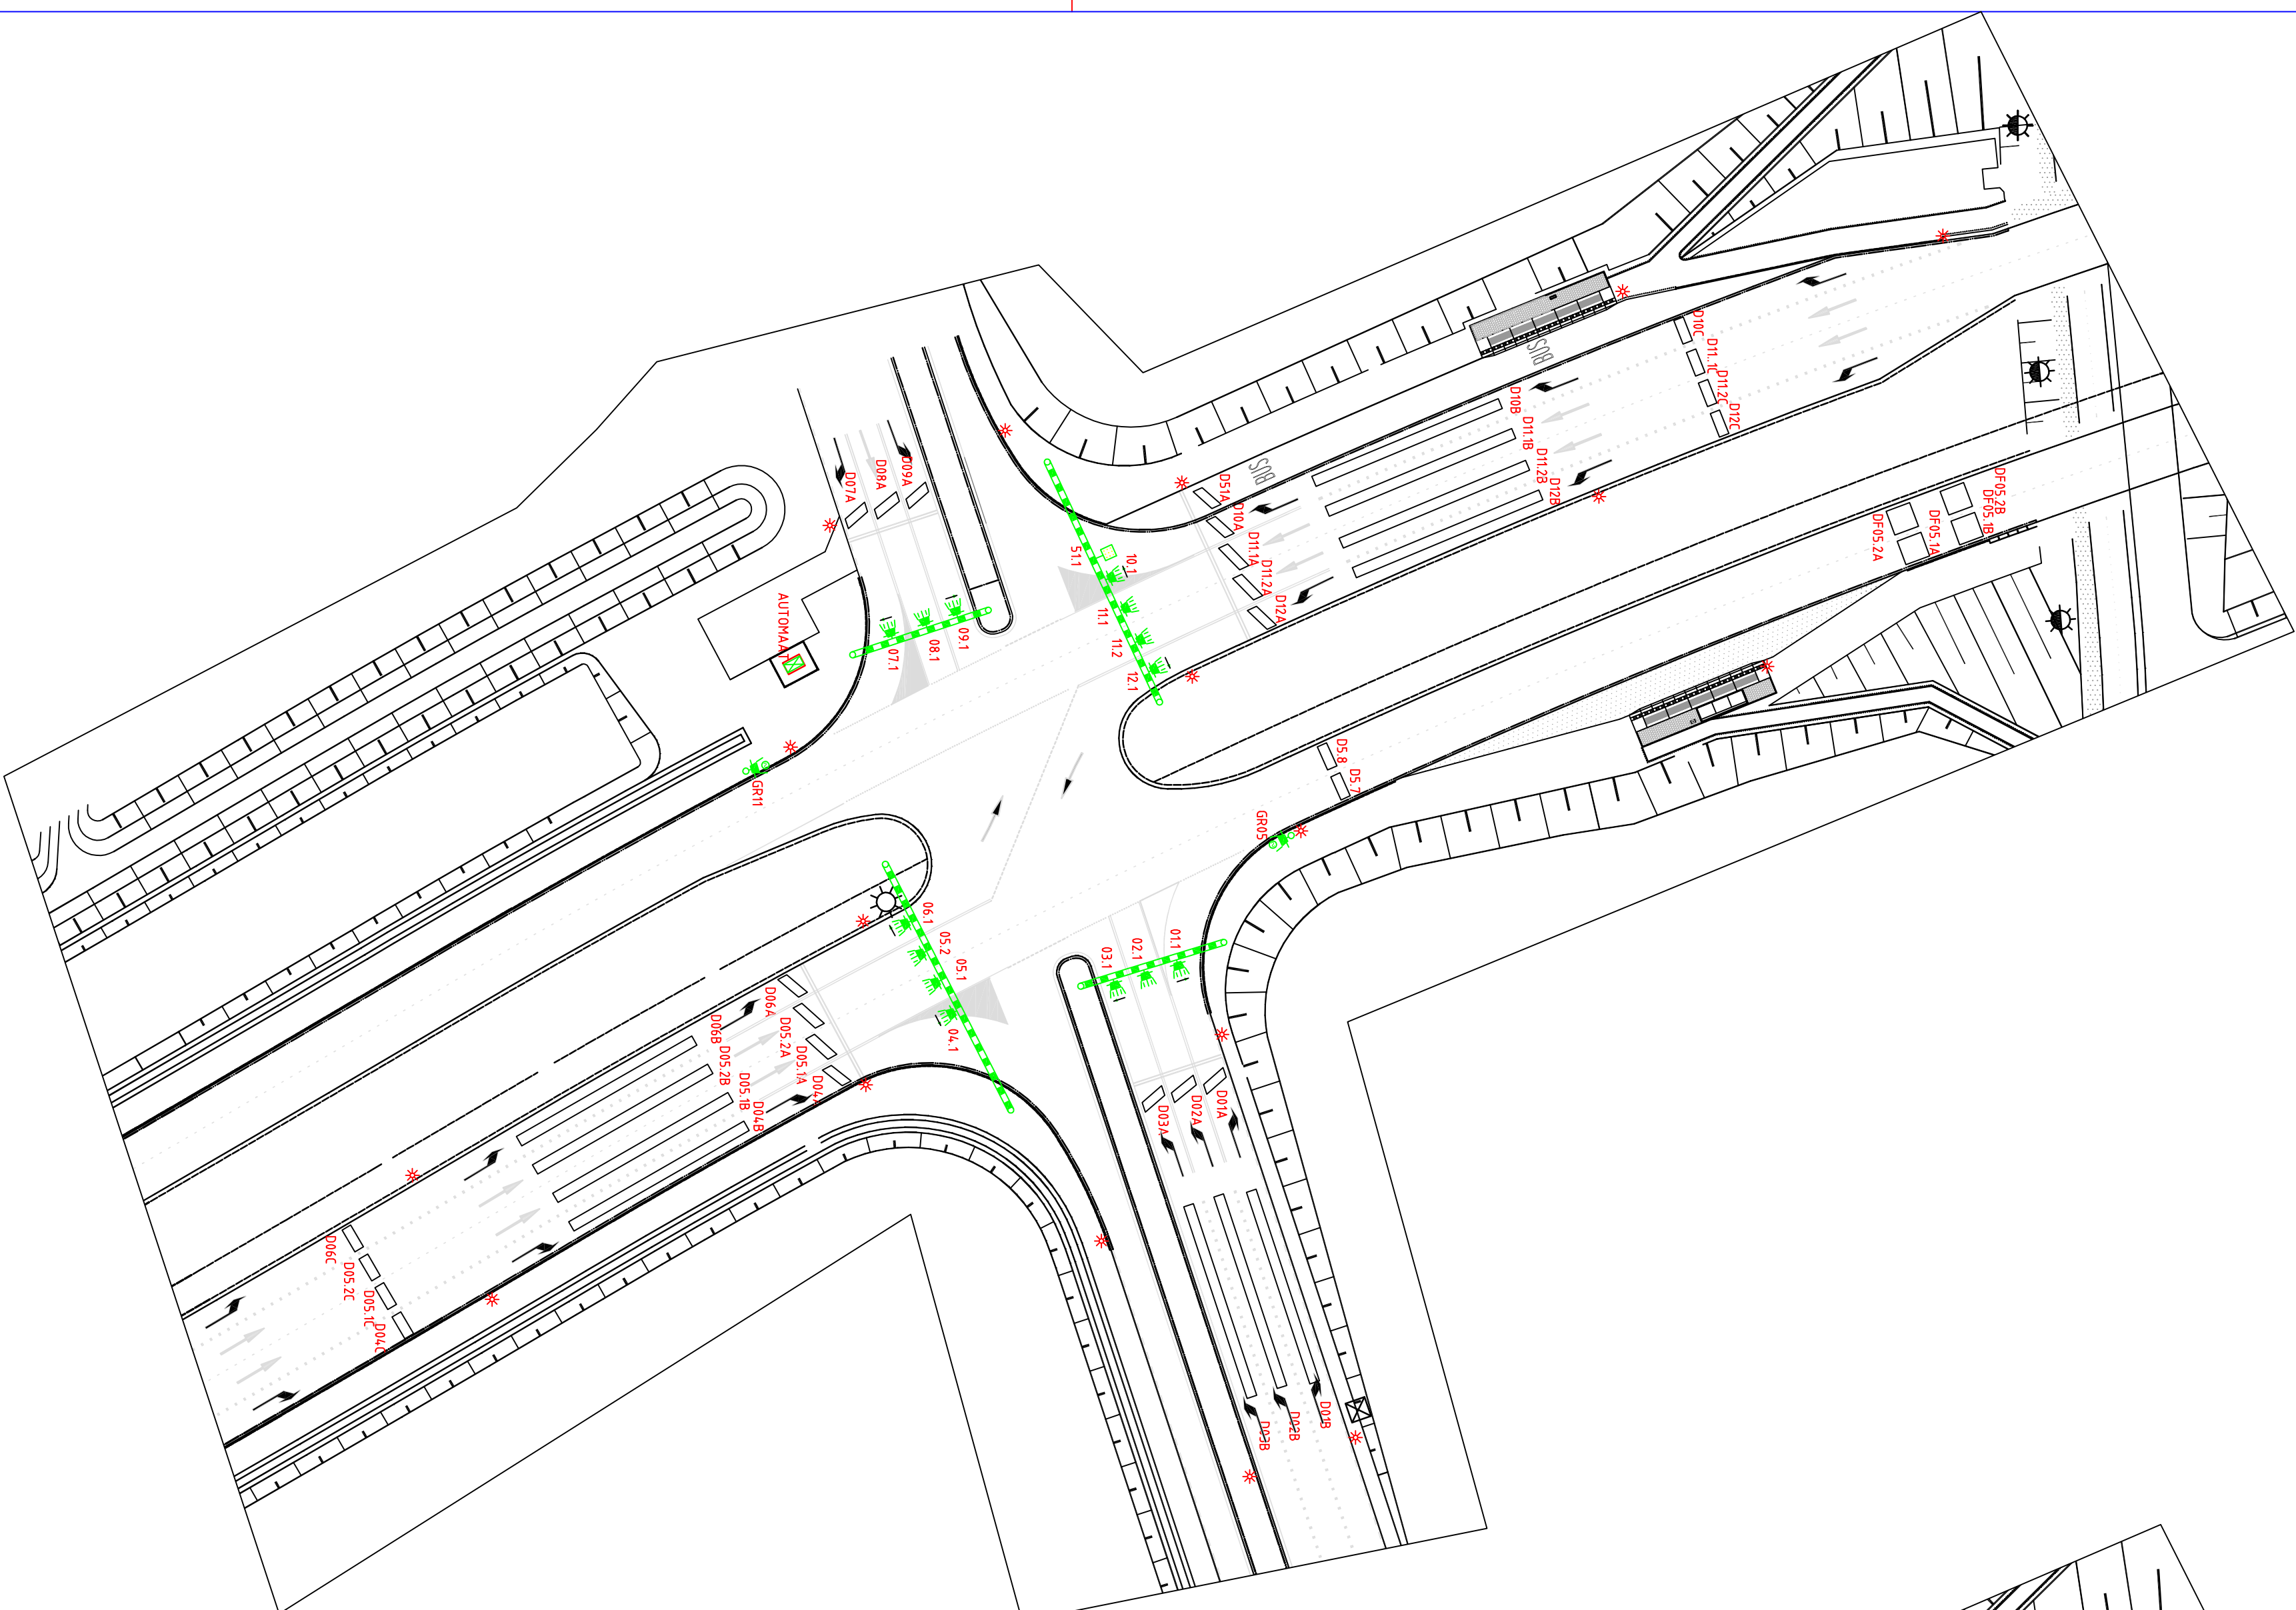


[illegible]

INSTALLATION