


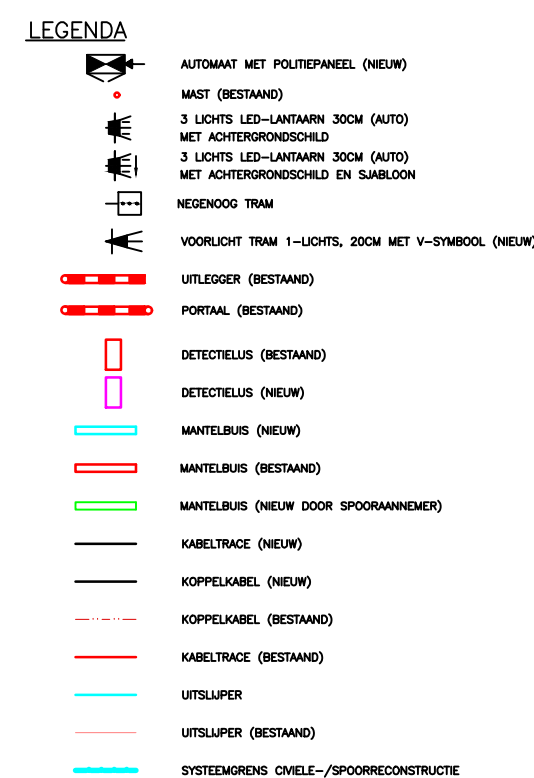

Van	Naar	Doorsnede
VRA K501	Lnt 4.1	EO-YmeKaszh 4x1.5
VRA K501	D 4.1/D 6.1	UXL 4x1.5
VRA K501	D 4.2/D 6.2	UXL 4x1.5
VRA K501	Lnt 6.1	EO-YmeKaszh 4x1.5
VRA K501	Lnt 7.1	EO-YmeKaszh 4x1.5
VRA K501	D 7.1	UXL 2x1.5
VRA K501	D 8.2/D 8.3	UXL 4x1.5
VRA K501	D 7.2	UXL 2x1.5
VRA K501	D 8.5/D 8.6	UXL 2x1.5
VRA K501	D 8.4	UXL 2x1.5
VRA K501	D 8.7	UXL 2x1.5
VRA K501	D 8.8/D 8.9	UXL 4x1.5
VRA K501	Lnt 81/82/83/84	EO-YmeKaszh 16x1.5
VRA K501	D 8.1	UXL 2x1.5
VRA K501	Lnt 3.2	EO-YmeKaszh 4x1.5
VRA K501	Lnt 3.1/2.4	EO-YmeKaszh 8x1.5
VRA K501	D 3.1/D2.3	UXL 4x1.5
VRA K501	D 3.2/D 2.6	UXL 4x1.5
VRA K501	D 2.7/D2.8	UXL 4x1.5
VRA K501	D 2.9	UXL 2x1.5
VRA K501	Lnt 2.1	EO-YmeKaszh 4x1.5
VRA K501	Lnt 2.2/2.3	EO-YmeKaszh 8x1.5
VRA K501	D 2.1/D2.2	UXL 4x1.5
VRA K501	D 2.4/D2.5	UXL 4x1.5
VRA K501	KK K502	15x4x0.8

	GEMEENTE NIEUWEGEIN			
	KRUISPUNT 501	REVISIETEKENING	SCHAAL	: 1:500
	NIEUWEGEIN	VERKEERSREGELINSTALLATIE	GETEKEND	: 30-6-2022 AG
	-	-	FORMAAT	: A1
			BLAD	- VAN -
			PROJECTNUMMER	-
			TEKENING NR.	XP-501