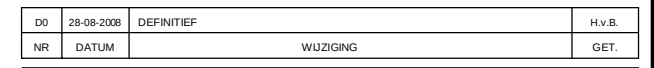

MATEN IN METERS TENZIJ ANDERS AANGEGEVEN



Oranjewoud

R:\00170000\00171689\CIVIEL\VRIGAVE\080708-ACAD\171689-ZH15.DWG