




5
 Alachar
 Alachar

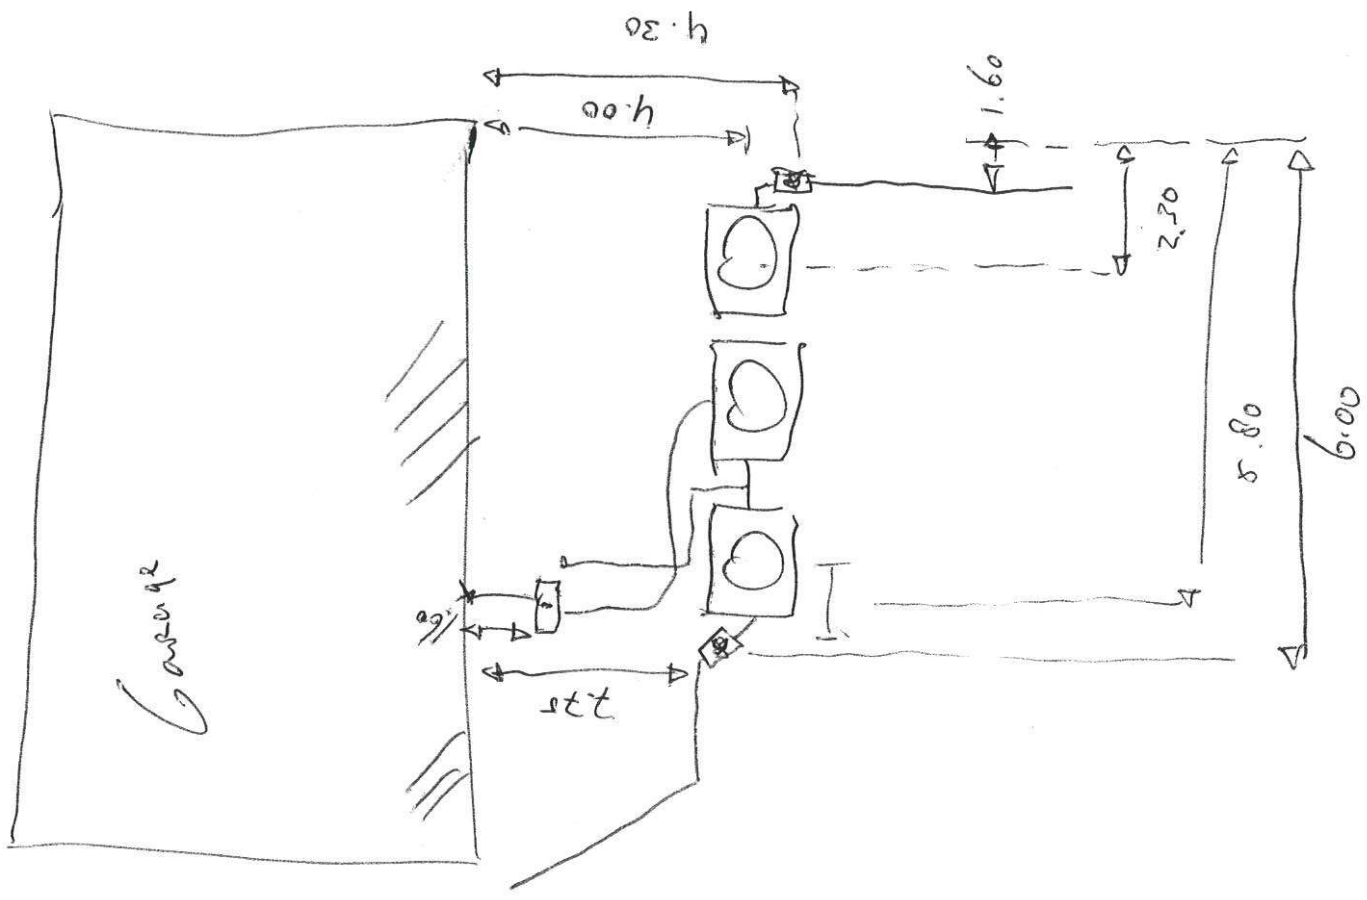