


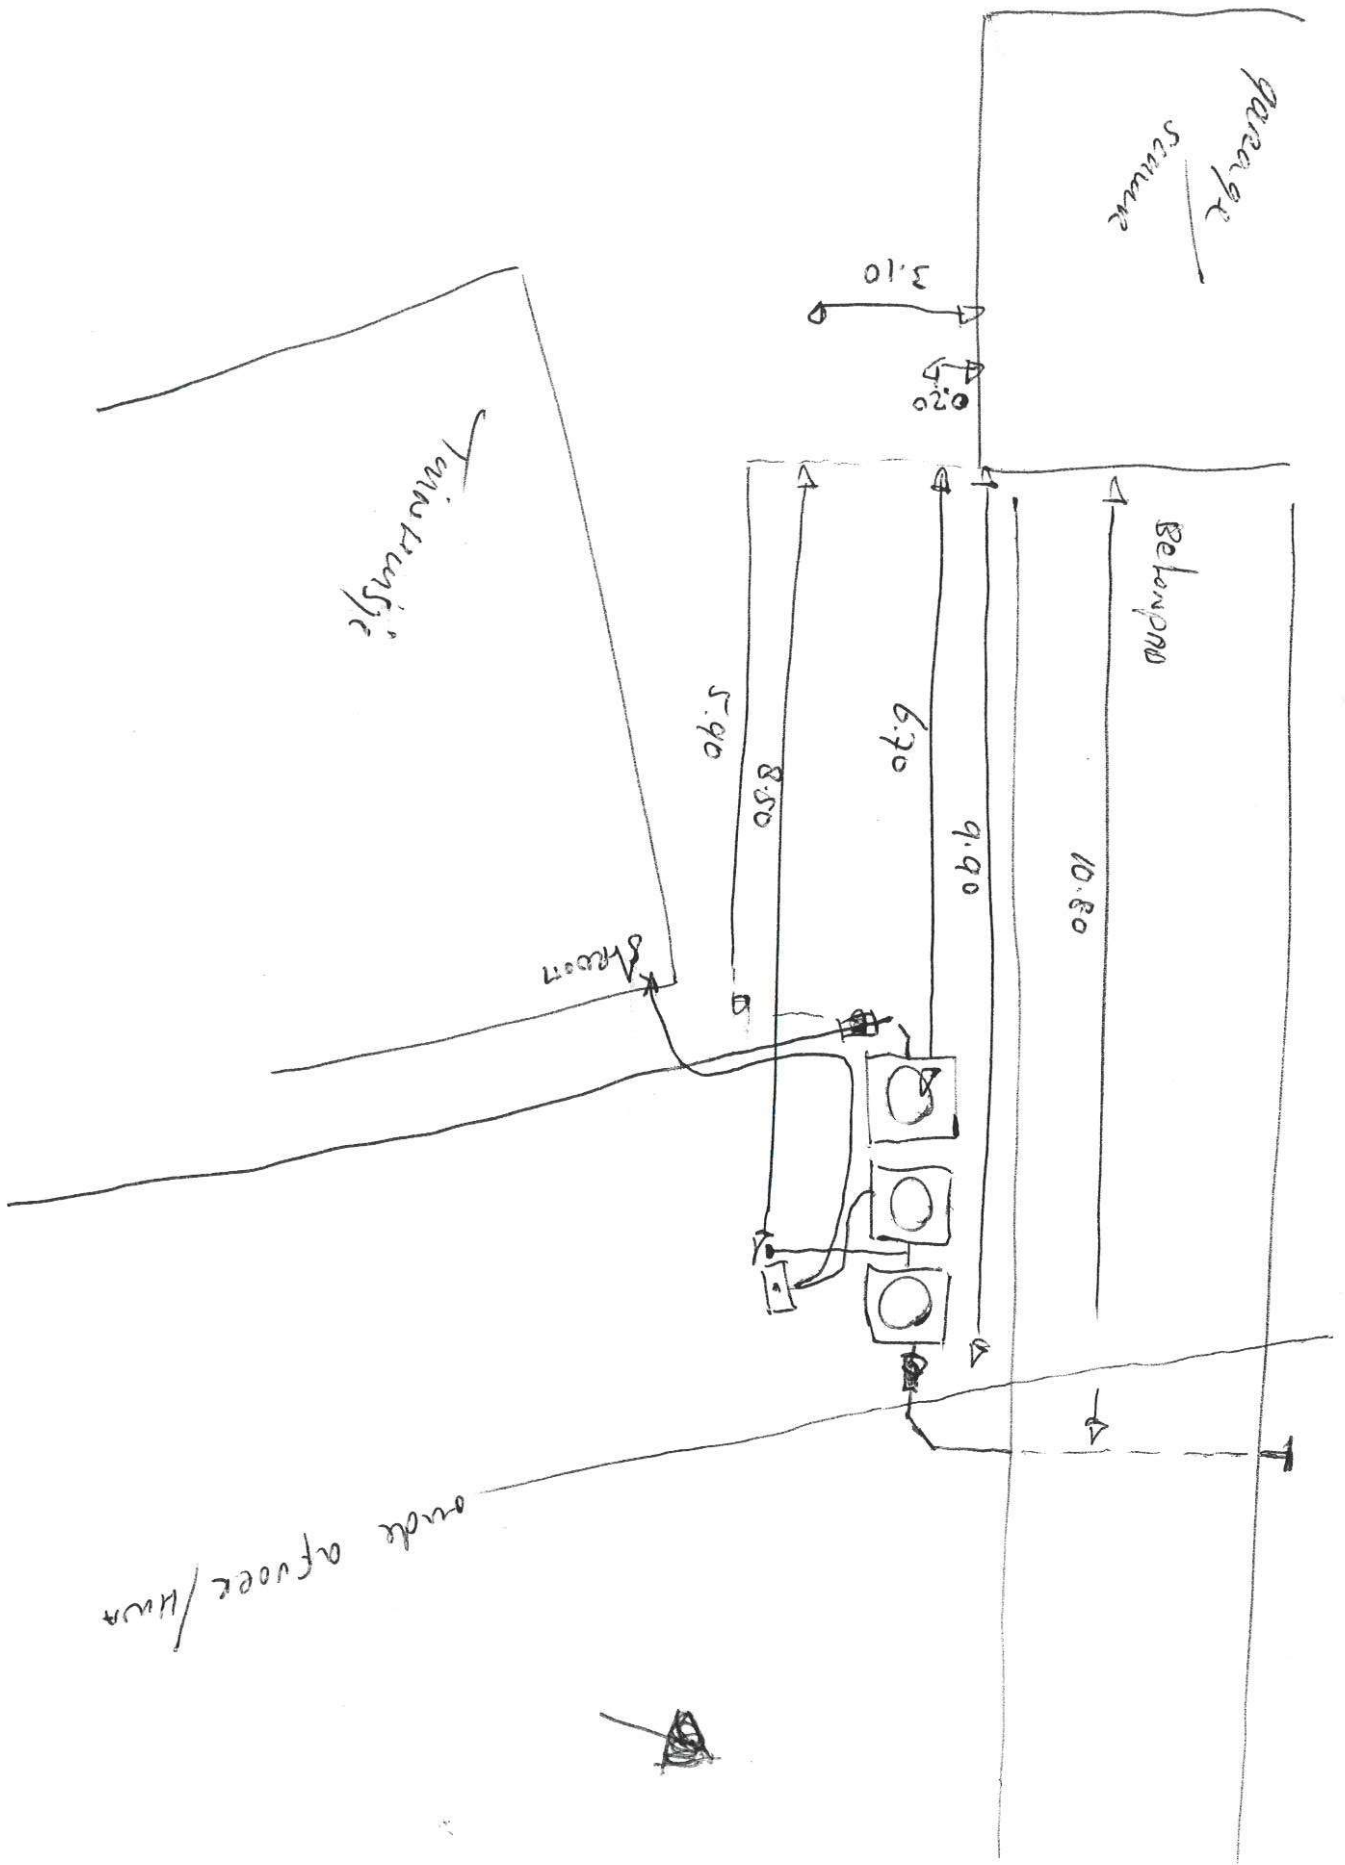

Rekening in 801