


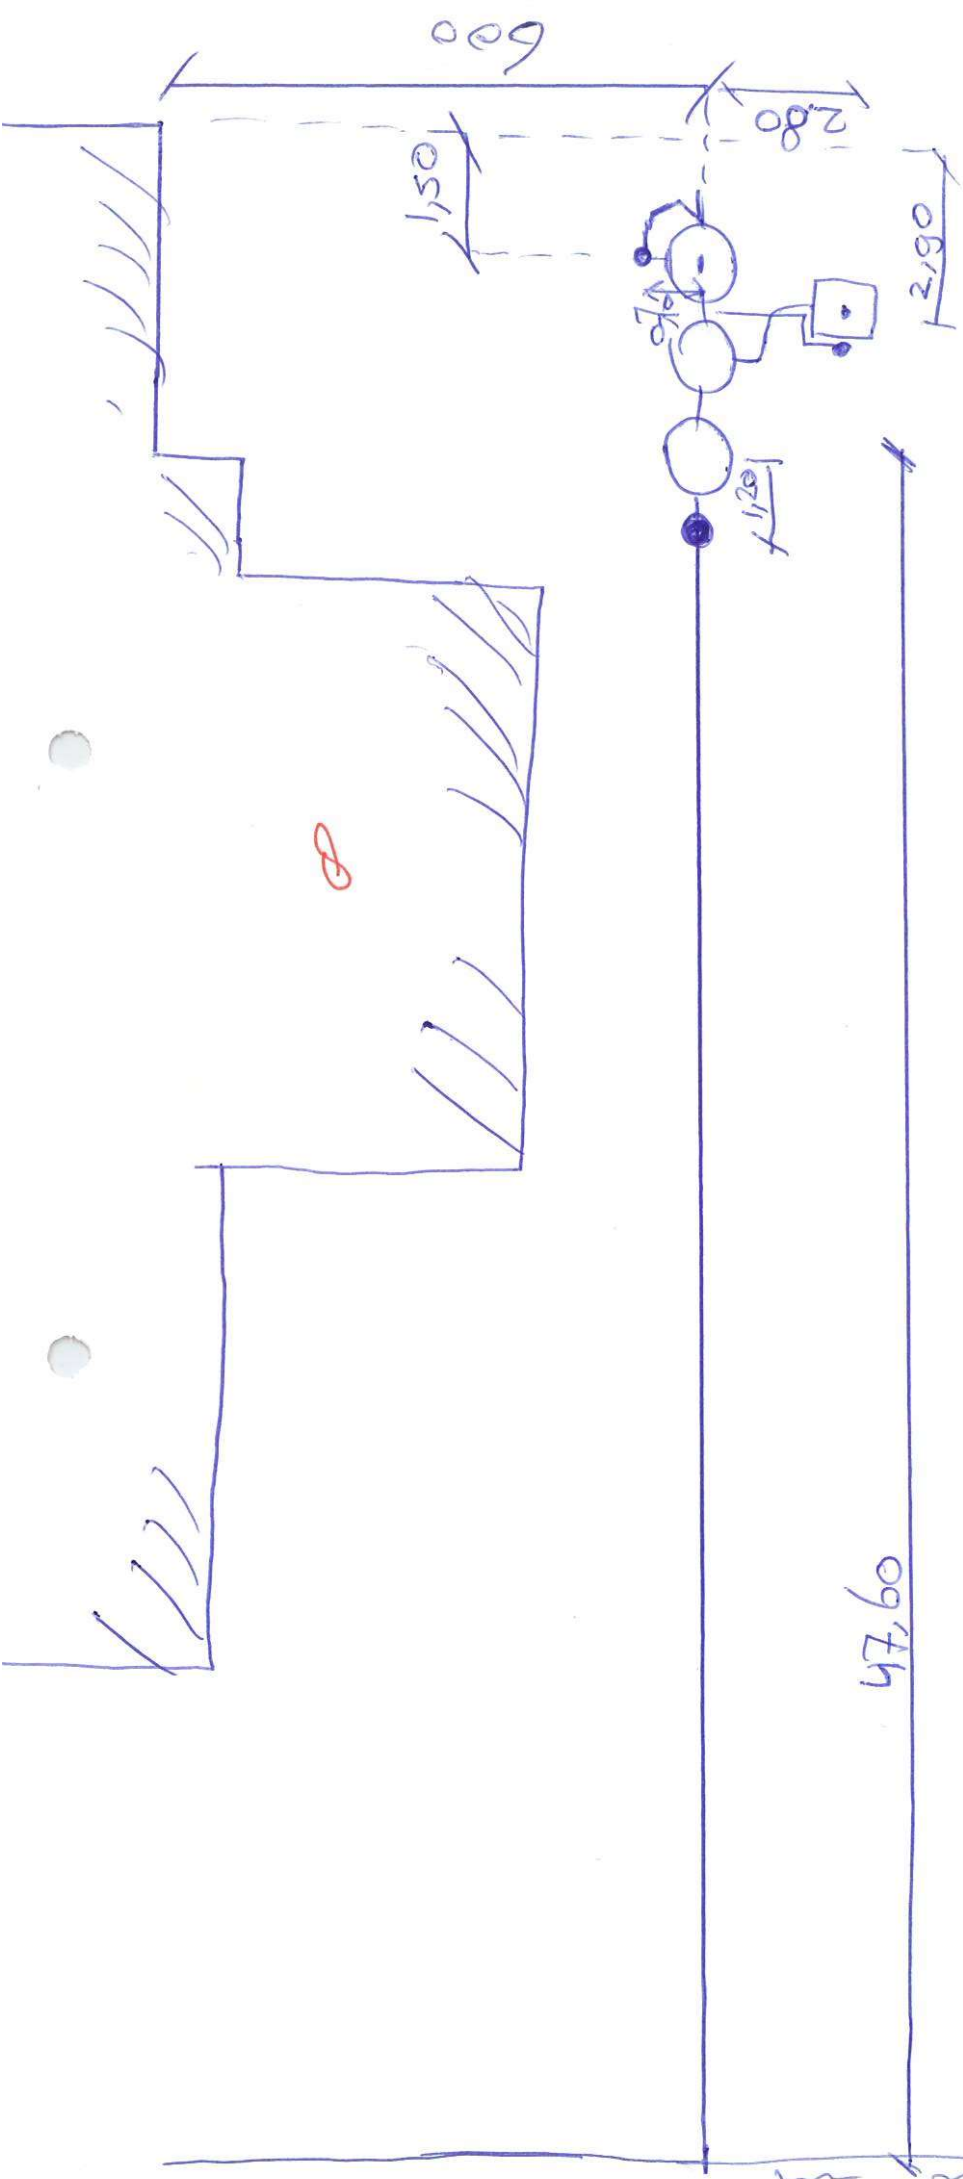

~~Weste~~
West oriende porten
Noord wolden