


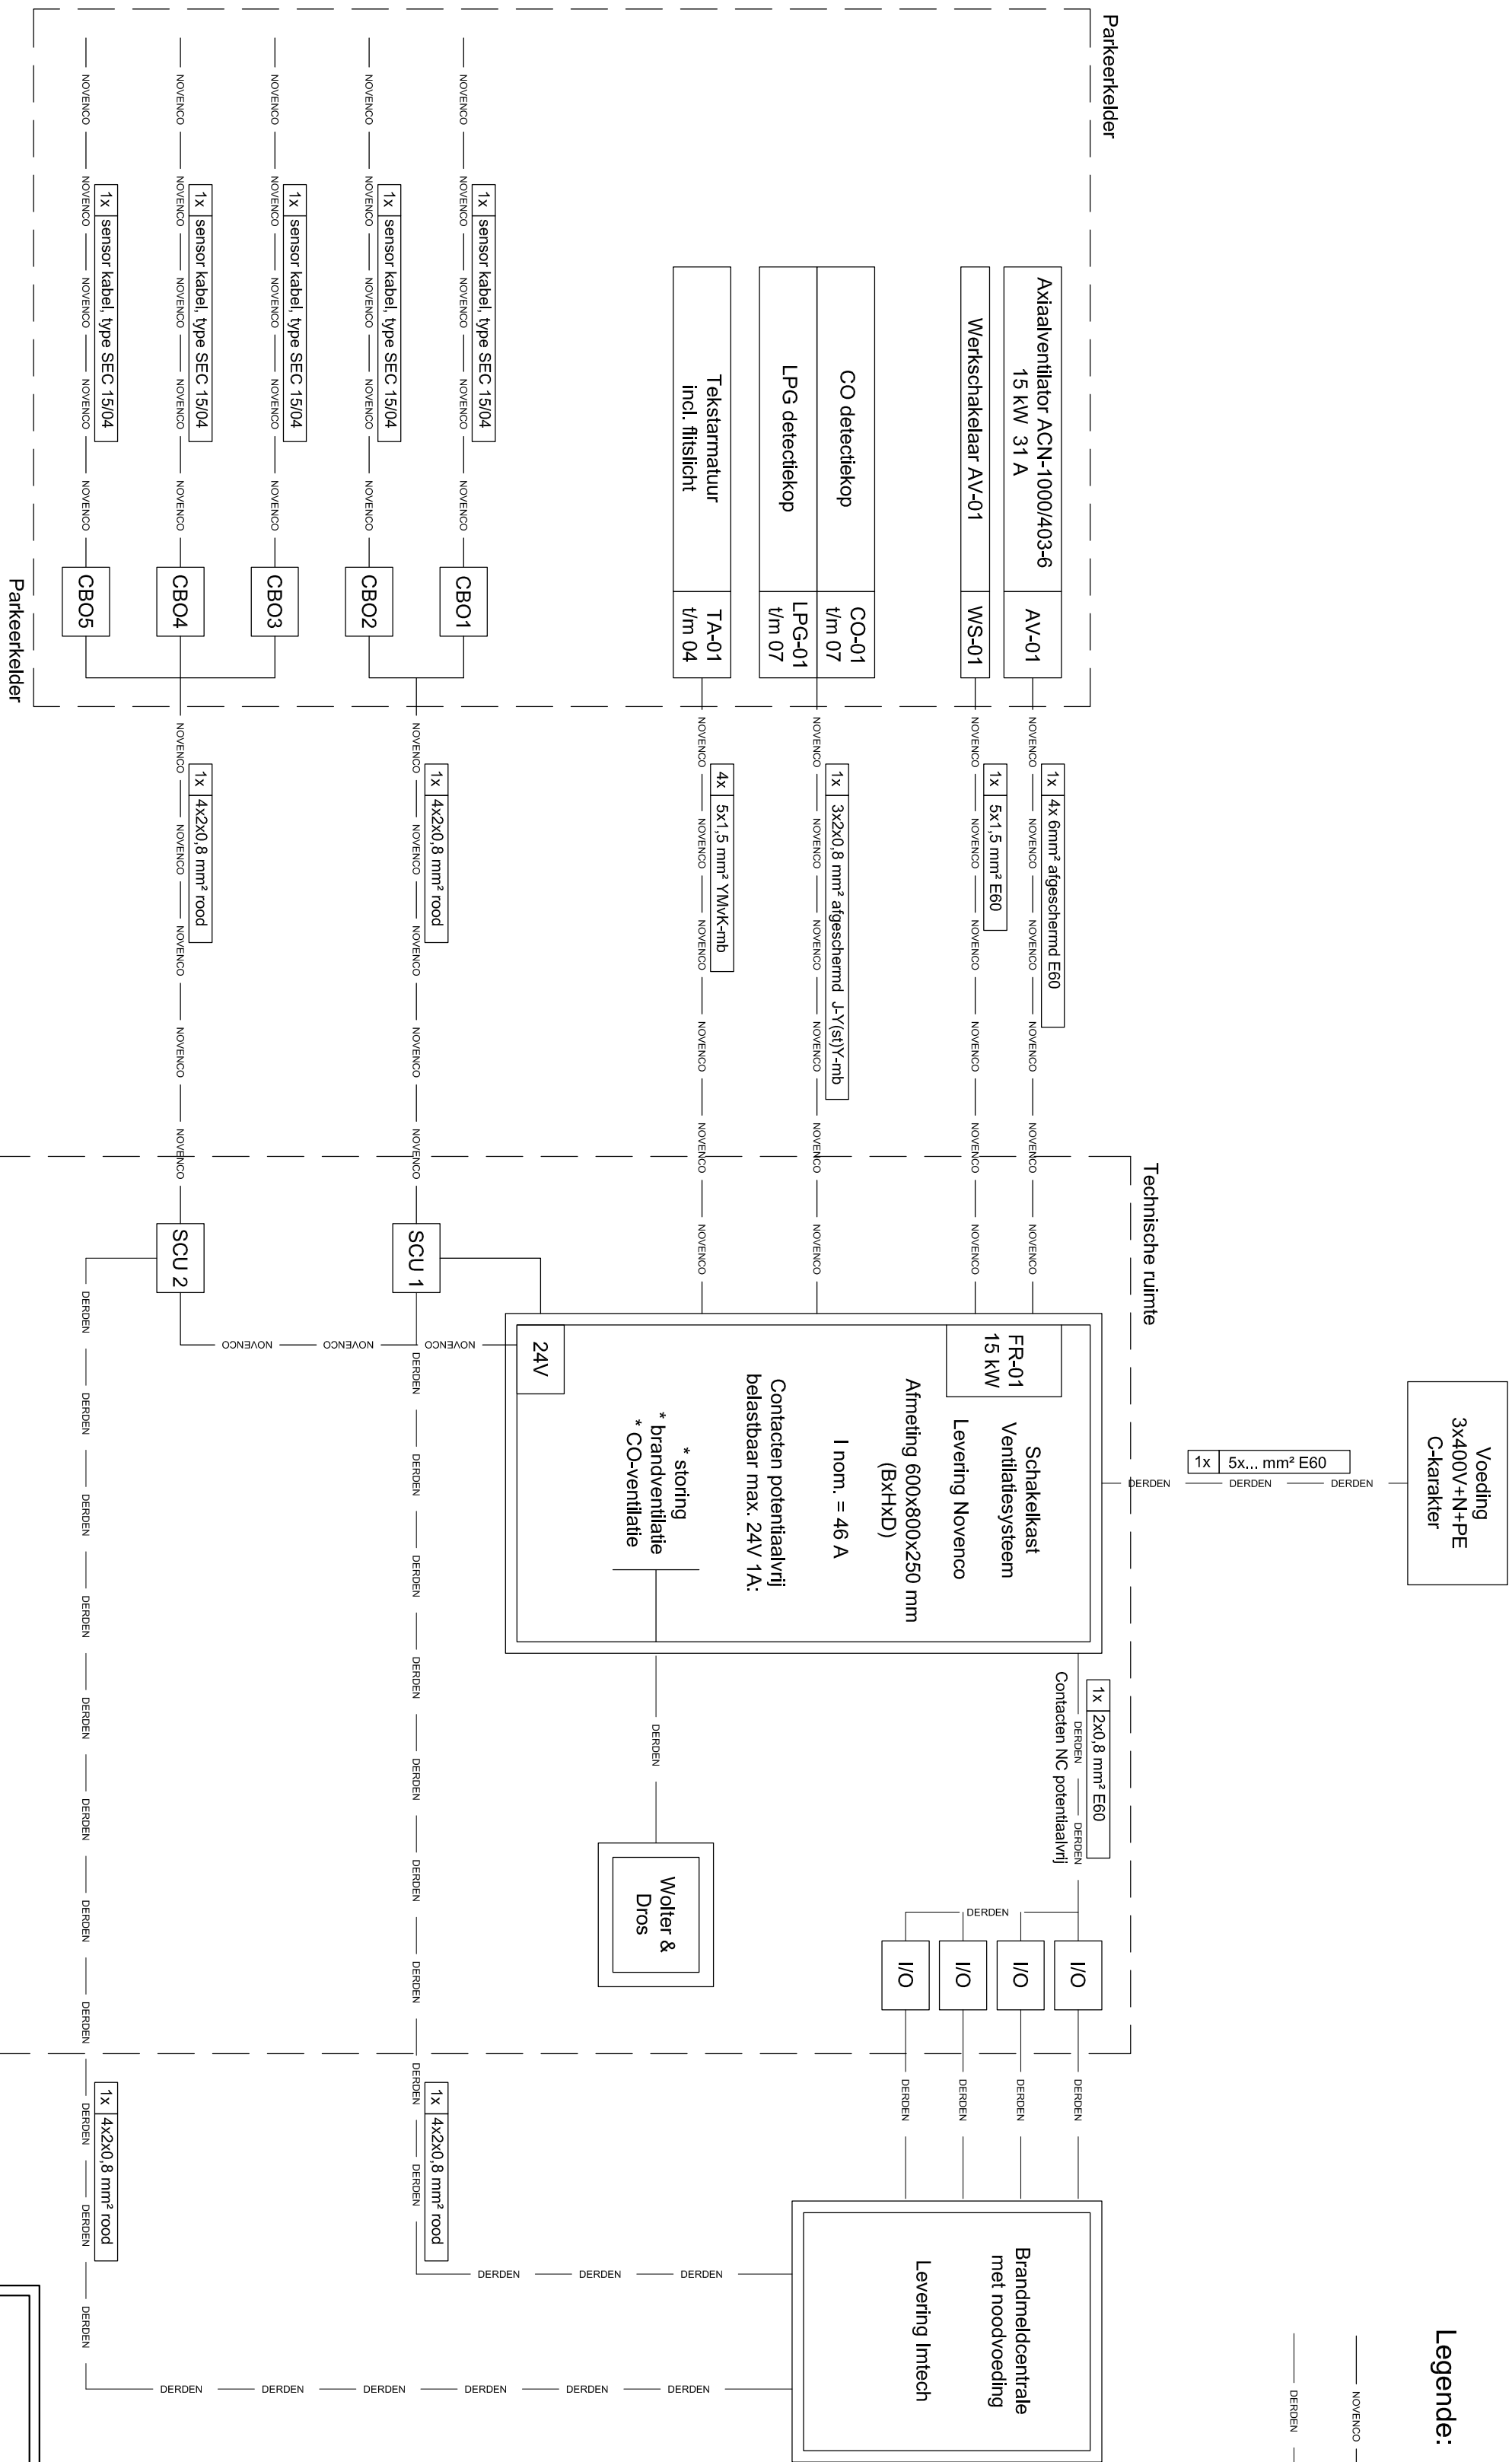

SCU 1: Deel II + III
SCU 2: Deel I

B	07-11-2012	MMM	AS-BUILT	ONC
A	02-01-2012	MMM	DEFINITEF	ONC
	Date	Changed by	Description	Checked by



NOVENCO

Novenoco B.V.
Car Park Ventilation Systems
Bergweg Zuid 115 - 2061 GS Bergschenhoek - The Netherlands
P.O. Box 21 - 2860 AA Bergschenhoek - The Netherlands
Phone : +31 10 524 24 24
Fax : +31 10 524 24 00
E-mail : info@novenoco.nl
Internet : www.novenoco.nl

Project :	DVC Rucphen	Order No :	20112523
Client :	Ingenieursbureau Wolter & Dros	Scale :	-
Subject :	Blokschema t.b.v. ventilatiesysteem	Drawn by :	MMM
		Date :	29-07-2011
		Dimension :	-
		Checked by :	ONC
		Drawing No :	20112523-B01

All rights reserved. Neither the whole nor any part of this drawing may be reproduced or transmitted in any form or by any means (electronic, mechanical or otherwise) without the prior written permission of Novenco B.V.

Rev.
B