


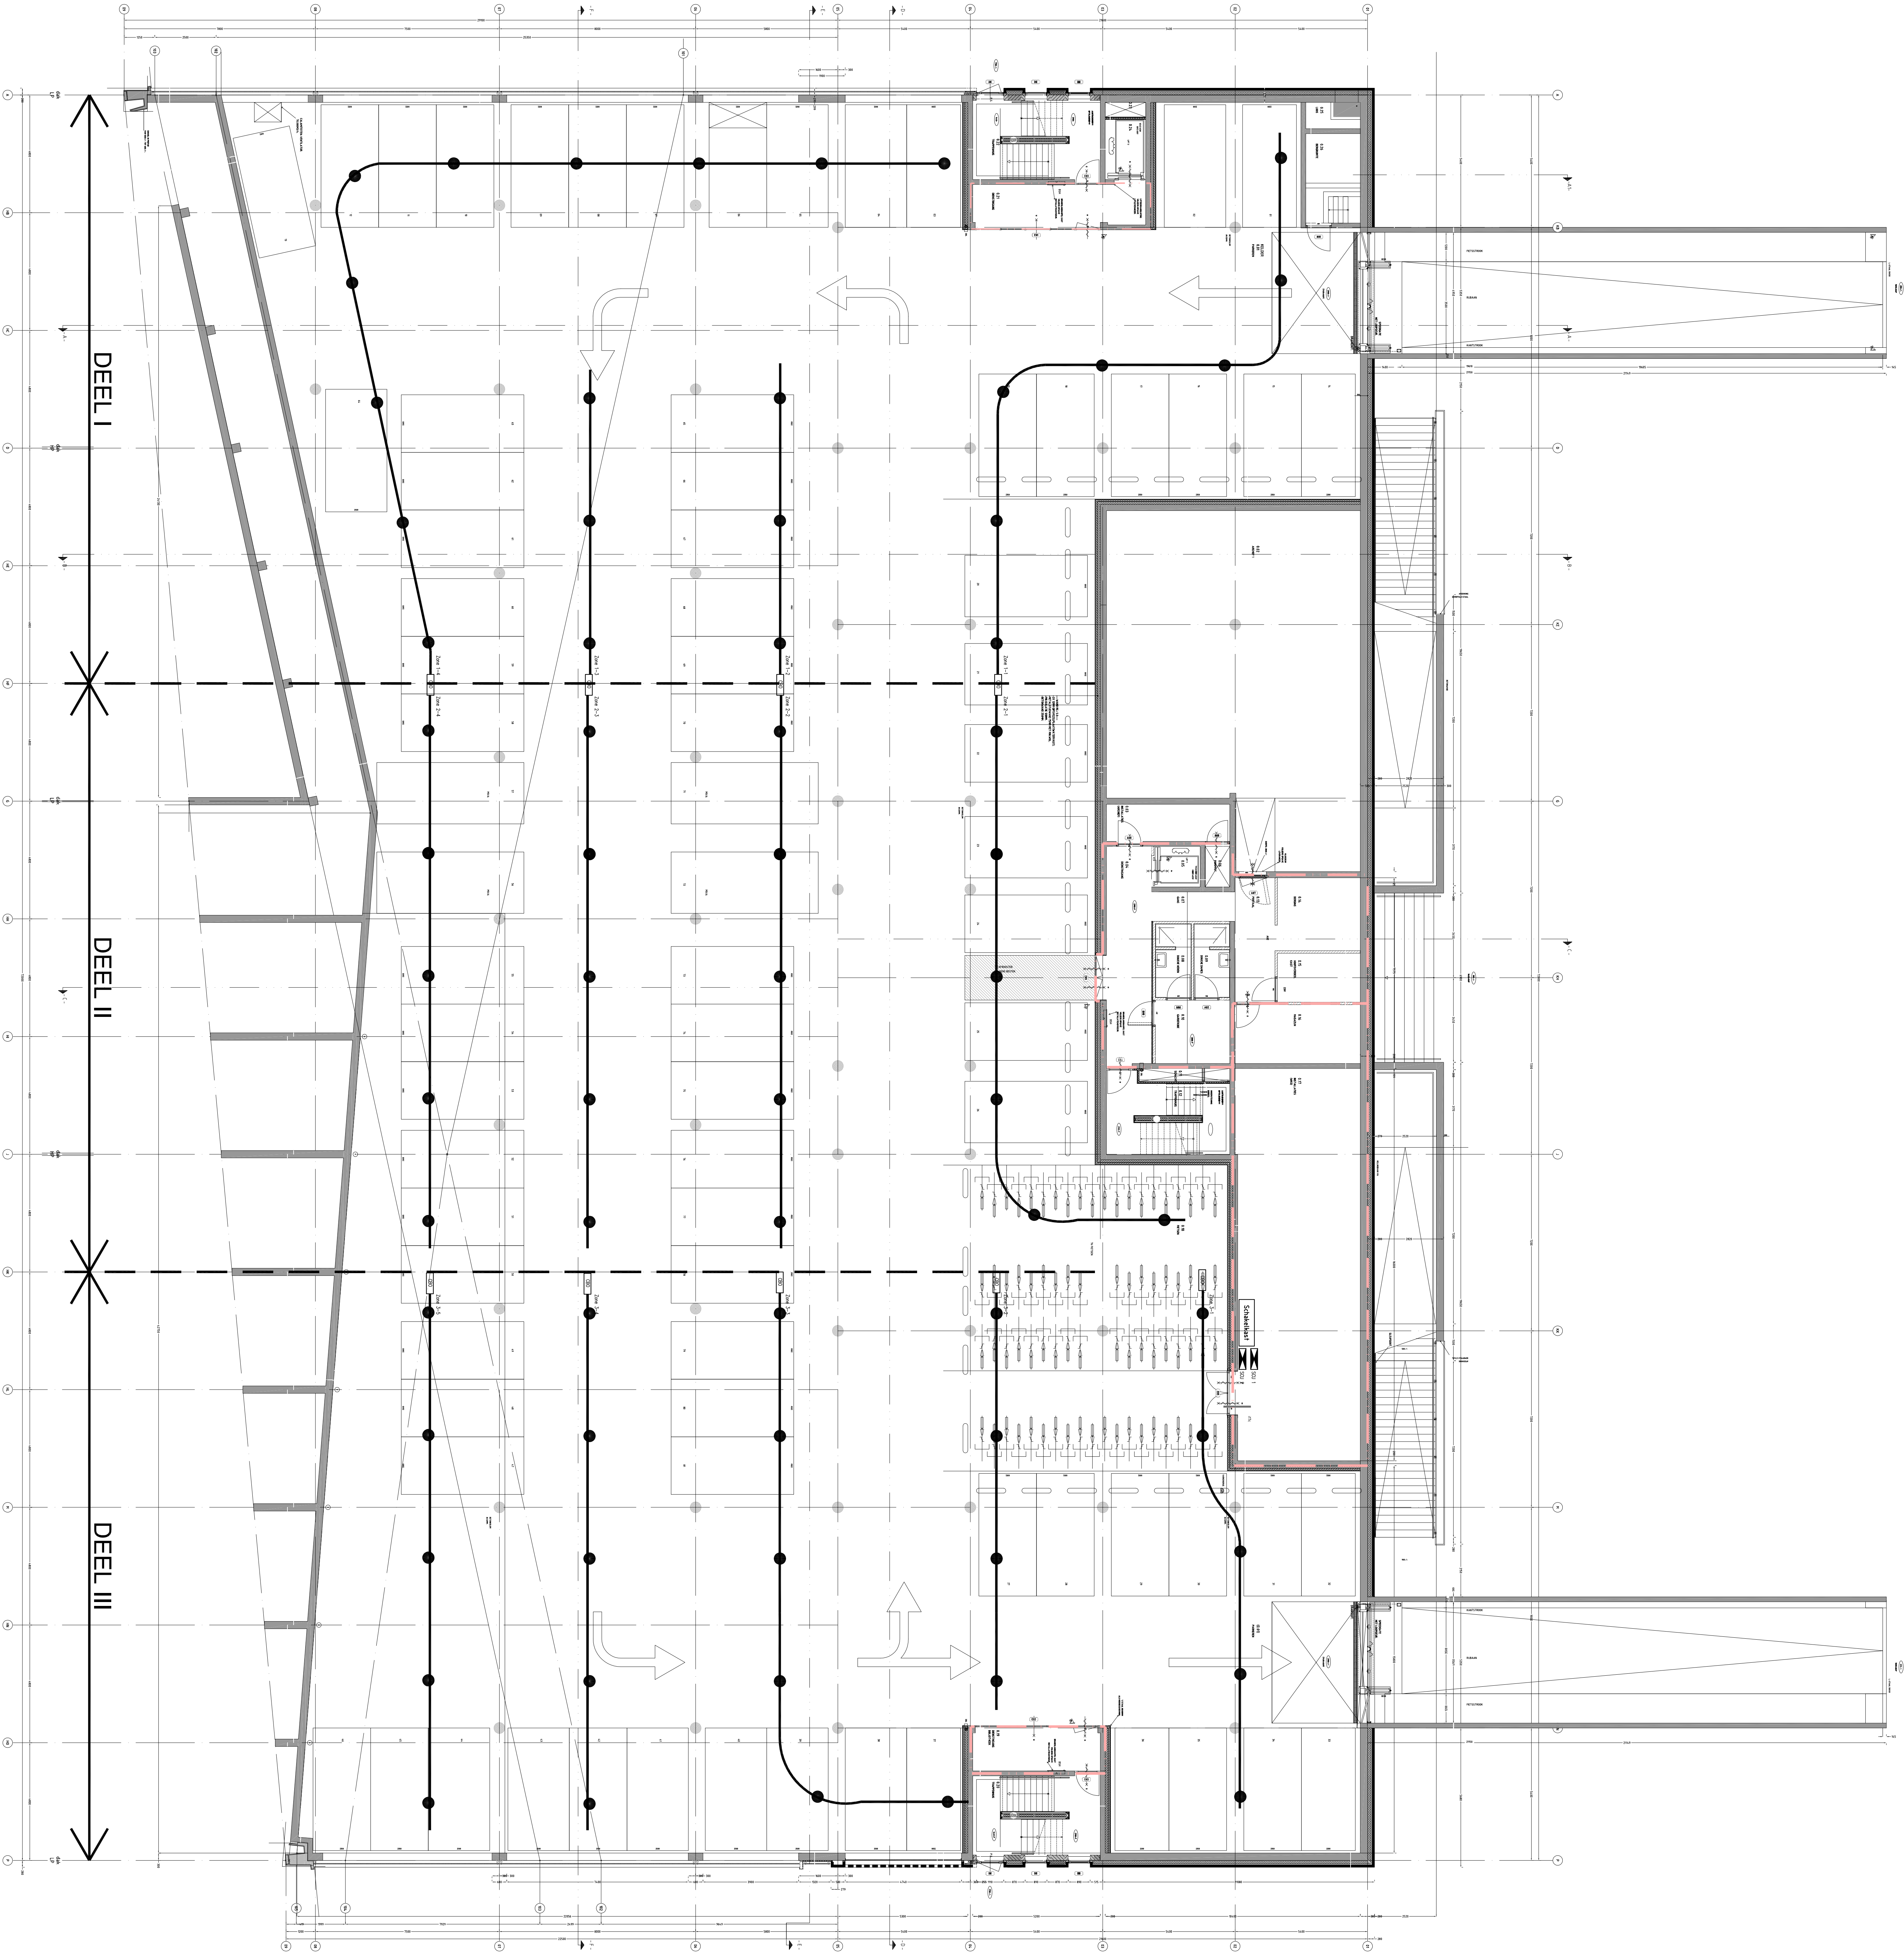

Renvooi brandmeld

— IST-sensordriel

BSO BSA

BSO BSA

BSO BSA

AS-BUILT

B	07/11/2012	NOVO	AS-BUILT	ONC
Rev.	06/11/2012	NOVO	AS-BUILT	ONC

NOVENCO

Novenco B.V.

Oct. P.O. Box 10000, 2010 CA Rotterdam, The Netherlands

P.O. Box 10000, 2010 CA Rotterdam, The Netherlands

Phone : +31 (0) 10 412 1234

Fax : +31 (0) 10 412 1234

E-mail : info@novenco.nl

Website : www.novenco.nl

Project : DVC Ruyter

Client : Ingenieursbureau Weller & Dros

Subject : Brandmeldsysteem lb.v. parkeergarage

Drawing No. : 20112523-F01

At right reserved. Neither the whole nor any part of this drawing may be reproduced, stored in a retrieval system, or transmitted in any form or by any means, electronic, mechanical, photocopying, recording, or otherwise, without the prior written permission of Novenco B.V.

20112523-F01

Rw. B