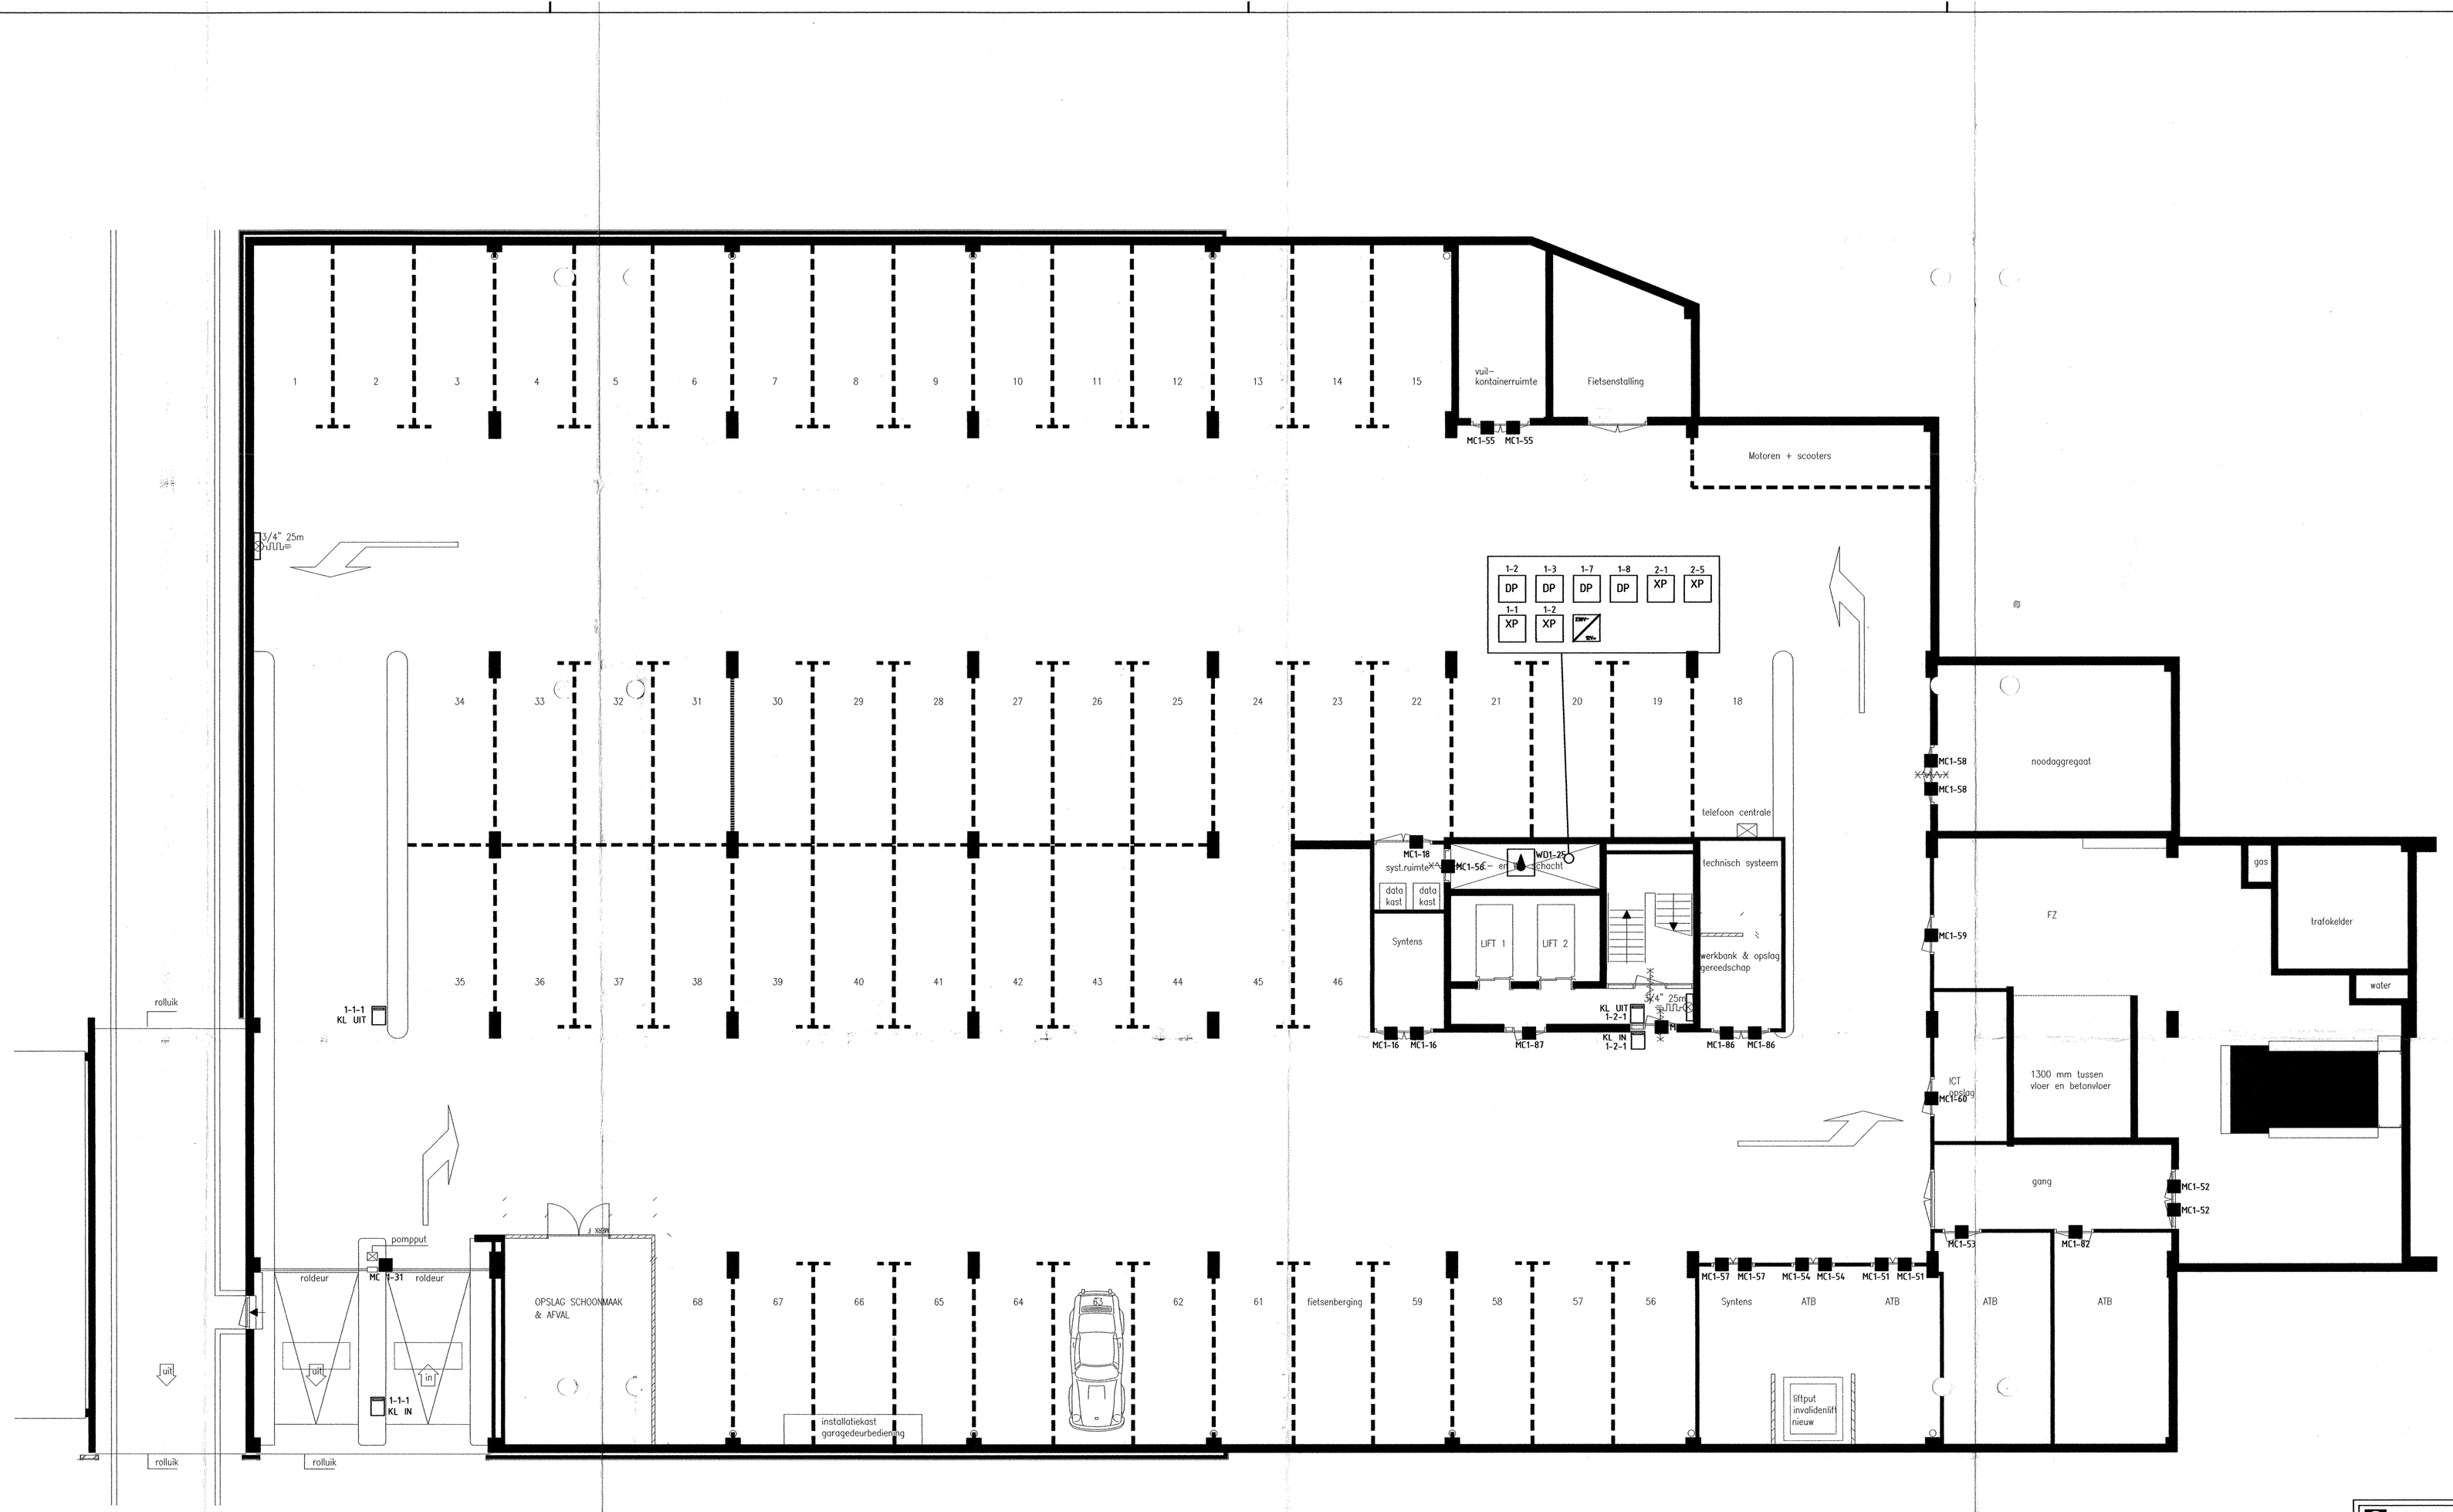

SYMBOLENLIJST TOEGANGSCONTROLE INST.	
SYMBOOL	OMSCHRIJVING
KL	KAARTLEZER
ES	ELEKTRISCHE SLUITPLAAT
RTE	RTE DRUKKNOP
ND	NOODDRUKKNOP
MPC	MPC CENTALE
XP	EXPANDER POD
DP	DEUR POD
12V	VOEDING 12V

SYMBOLENLIJST INBRAAKBEVEILIGINGS INST.	
SYMBOOL	OMSCHRIJVING
MC	MAGNEETCONTACT
	PIR WIDEBEAM
	WATERDETECTIE
	OVERVALSKNOP
	SIGNAALGEVER OVERVALSKNOP
SC	SCHOOTCONTACT
PATCH	PATCHKAST

Chubb Varel
A UTC Fire & Security Company

National Accounts
Hettenheuvelweg 13
1101 BM Amsterdam

omschrijving/description

- TER INFORMATIE / FOR INFOMATION
- VOORLOPIG ONTWERP / PRECISION
- TER CONTROLE / FOR APPROVAL
- VOOR UITVOERING / FOR CONSTRUCTION
- DEFINITIEF ONTWERP / FINAL DESIGN
- ALS UITGEVOERD / AS BUILT
- ONGECONTR. KOPIE / UNCONTR. COPY
- ANDERS NL. / OTHER LC.

datum/date | handtekening/signature

REV	DATE	DESCRIPTION AND PROJECTNUMBER	DWN BY	CH'CD BY	CV APPR.	CLIENT APPR.
REV	DATUM	OMSCHRIJVING EN PROJECTNUMMER	GET. DOOR	GEC.DOOR	CV AKKD.	KLANT AKKD.
A	14/05/09	AS BUILT / 42971324	HV	MW	MvD	
0	20/02/08	ONTWERP	HV	WvdR	WvdR	

This document is confidential. The copyright is vested in Chubb Varel Security B.V. Amsterdam, the netherlands All rights reserved. Neither the whole nor any part of the information contained herein may be copied, reproduced, stored in any retrieval system transmitted in any form or by any means (electronic, mechanical repro-graphic, recording or otherwise) without the prior written consent of the copyright owner.

TITLE / TITEL: INBRAAK & TOEGANGSCONTROLE INSTALLATIE
PROJECTERING KELDER

Chubb Varel
A UTC Fire & Security Company

CHUBB VAREL DRAWING No./CHUBB VAREL TEK.Nr.: 294447-20606.001
CLIENT DRAWING No./KLANT TEK.Nr.:

CLIENT / KLANT: KAMER VAN KOOPHANDEL
RUYTERKADE 5
1013 AA AMSTERDAM

FORMAT / FORMAAT: A1
SCALE / SCHAAL: 1:100
REV No.: A
SHEET No.: 001
BLAD Nr.:

DOSSIER NUMBER / DOSSIER NUMMER: 294447