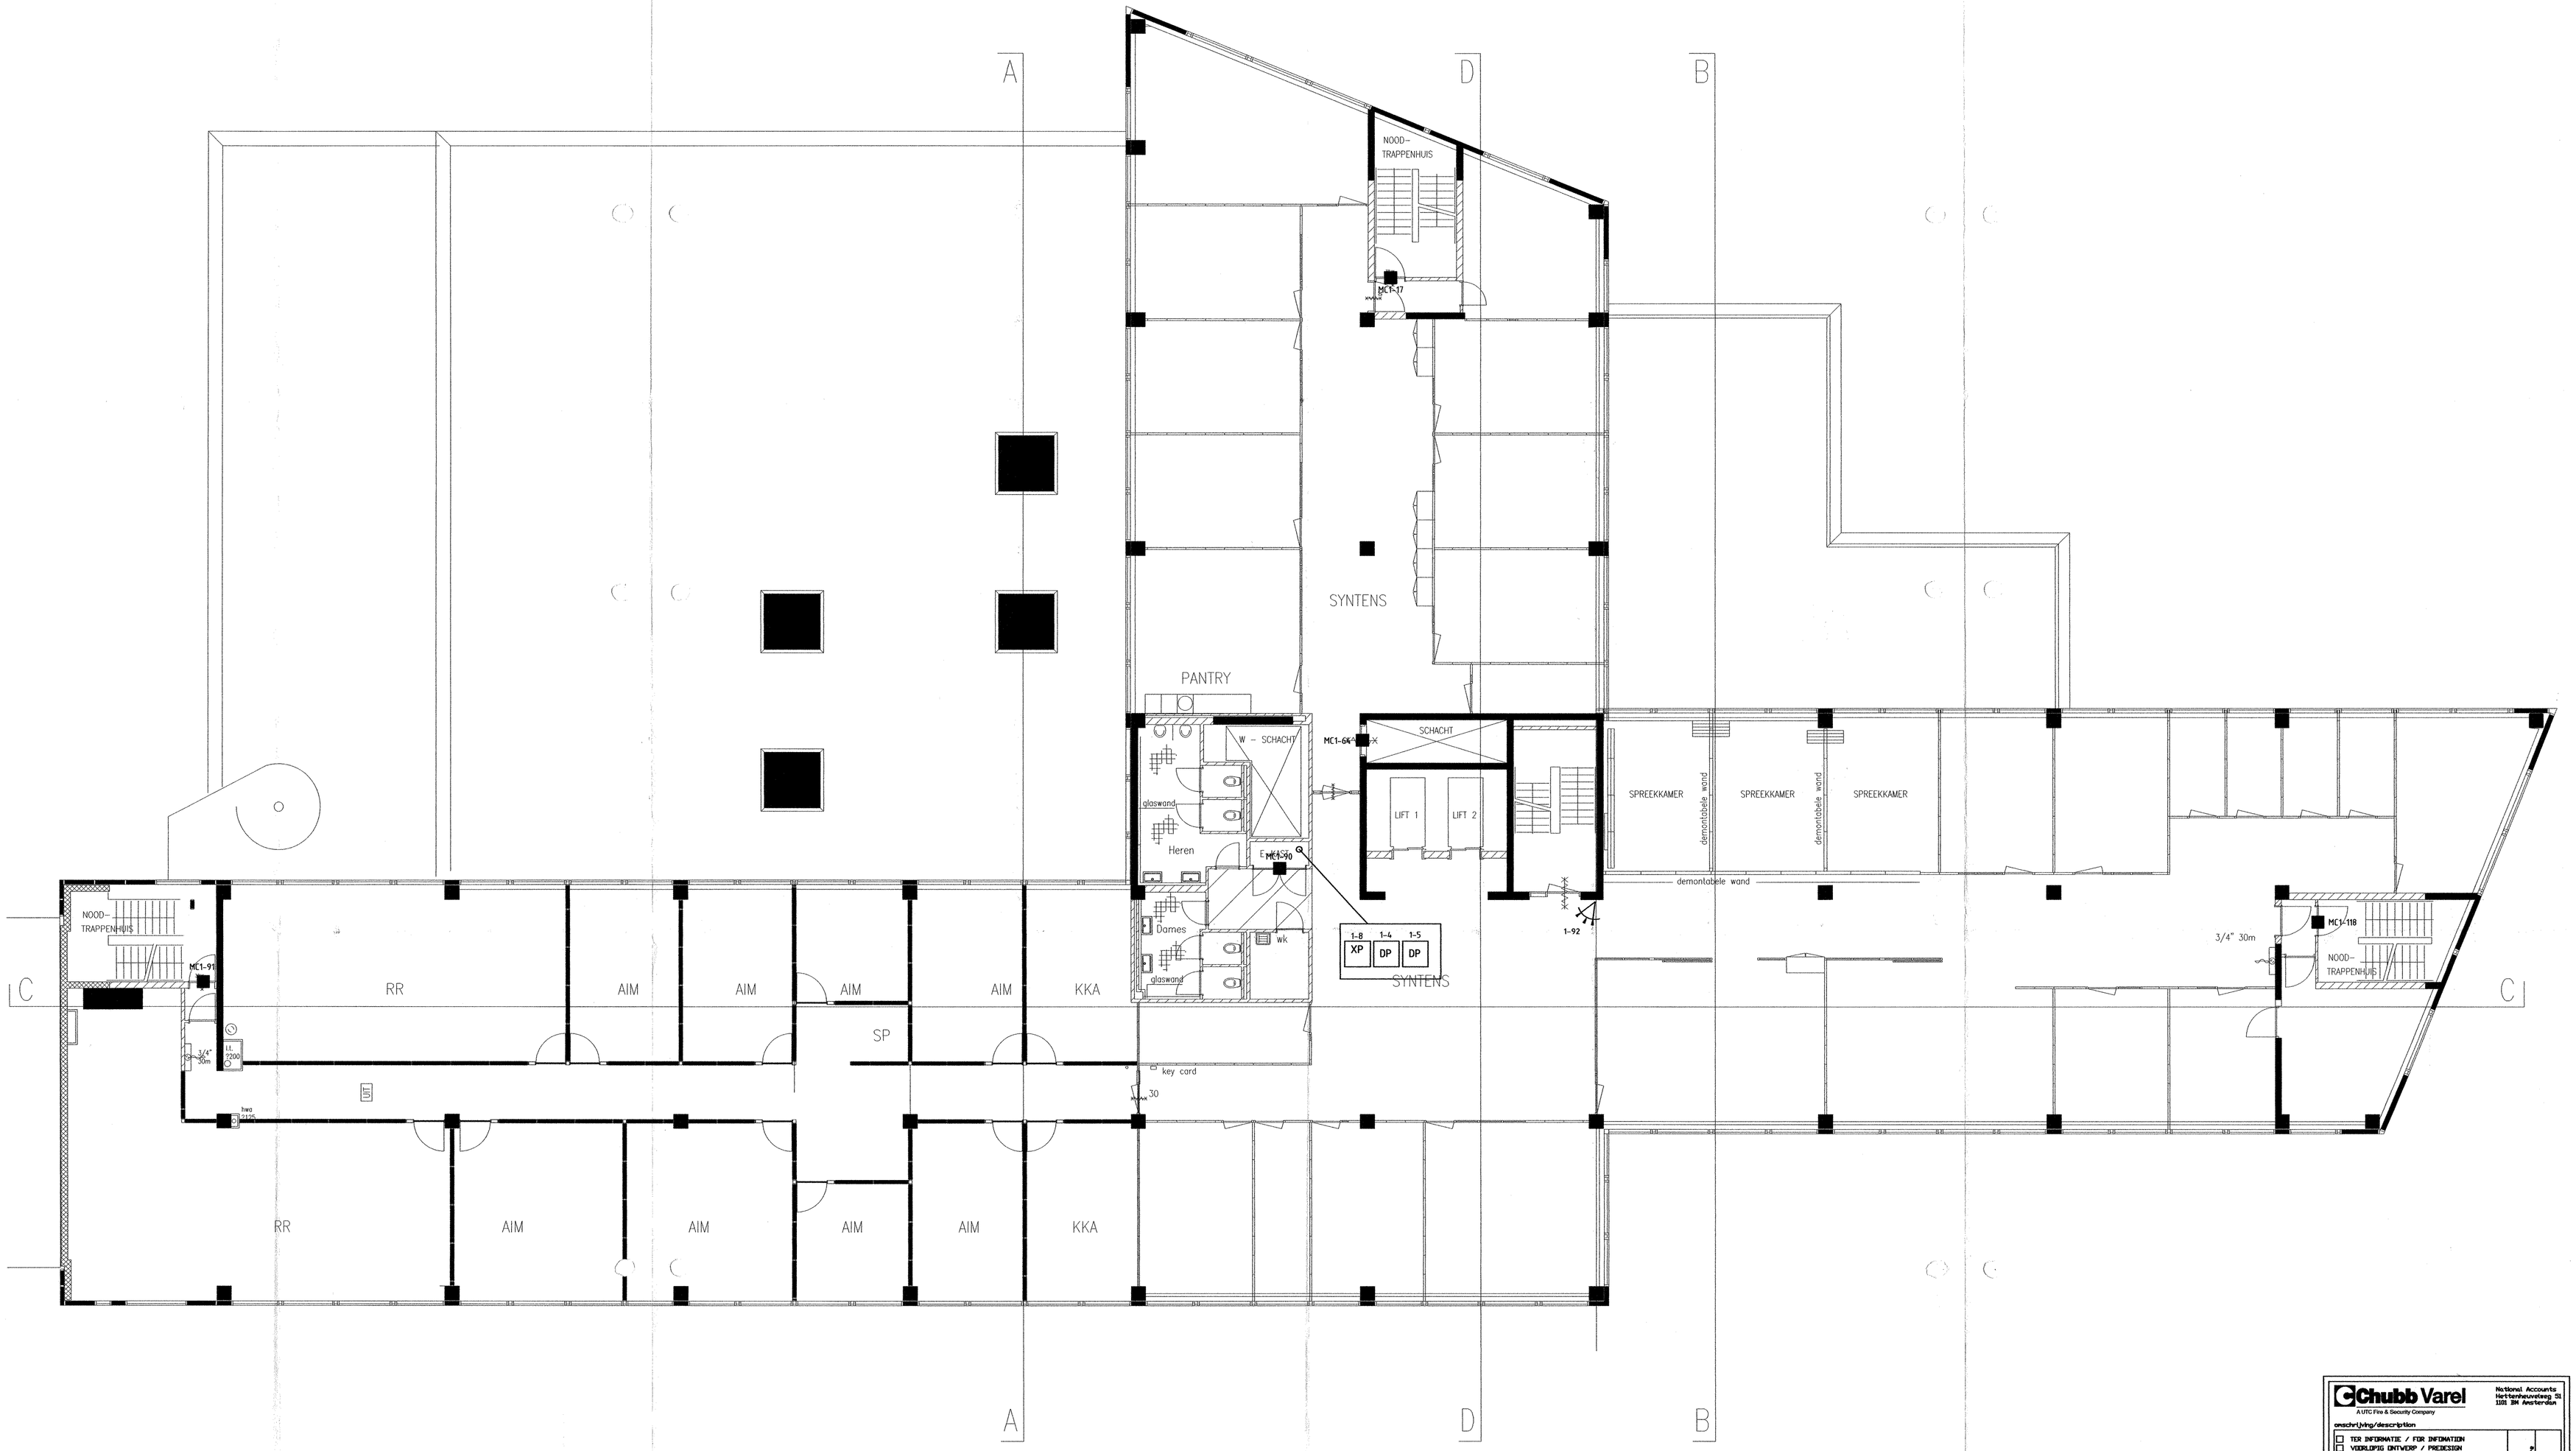

SYMBOLENLIJST TOEGANGSCONTROLE INST.	
SYMBOOL	OMSCHRIJVING
KL	KAARTLEZER
ES	ELEKTRISCHE SLUITPLAAT
RTE	RTE DRUKKNOP
ND	NOODDRUKKNOP
MPC	MPC CENTALE
XP	EXPANDER POD
DP	DEUR POD
PWR	VOEDING 12V

SYMBOLENLIJST INBRAAKBEVEILIGINGS INST.	
SYMBOOL	OMSCHRIJVING
MC	MAGNEETCONTACT
	PIR WIDEBEAM
	WATERDETECTIE
	OVERVALSKNOP
	SIGNAALGEVER OVERVALSKNOP
SC	SCHOOTCONTACT
PATCH	PATCHKAST

Chubb Varel
A UTC Fire & Security Company

National Accounts
Hertenhuisweg 23
1101 BM Amsterdam

omschrijving/description

- ☐ TER INFORMATIE / FOR INFORMATION
- ☐ VOORLOPIG ONTWERP / PRECISION
- ☐ TER CONTROLE / FOR APPROVAL
- ☐ VOOR UITVOERING / FOR CONSTRUCTION
- ☐ DEFINITIEF ONTWERP / FINAL DESIGN
- ☐ AS BUILT VERSION / AS BUILT
- ☐ ONGECONTR. KOPIE / UNCONTR. COPY
- ☐ ANDERS NL. / OTHER I.E.

datum/date | handtek./signature

REV	DATUM / DATE	DESCRIPTION AND PROJECTNUMBER / OMSCHRIJVING EN PROJECTNUMMER	DWN BY / GET. DOOR	CHK'D BY / GEC.DOOR	CV APPR. / CV AKKD.	CLIENT APPR. / KLANT AKKD.
A	14/05/09	AS BUILT / 42971324	HV	MW	MvD	
0	20/02/08	ONTWERP	HV	WvdR	WvdR	

This document is confidential. The copyright is vested in Chubb Varel. Alle rechten voorbehouden. All rights reserved. Neither this document nor any of this document may be disclosed to any third party or reproduced, stored in any retrieval system transmitted in any form or by any means (electronic, mechanical repro graphic, recording or otherwise) without the prior written consent of the copyright owner.

TITLE / TITEL: INBRAAK & TOEGANGCONTROLE INSTALLATIE
PROJECTERING 3E VERDIEPING

Chubb Varel
A UTC Fire & Security Company

CHUBB VAREL DRAWING No./CHUBB VAREL TEK.Nr.: 294447-20606.005
CLIENT DRAWING No./KLANT TEK.Nr.:

CLIENT / KLANT: KAMER VAN KOOPHANDEL
RUYTERKADE 5
1013 AA AMSTERDAM

FORMAT / FORMAAT: A1
SCALE / SCHAAL: 1:100
REV No.: / REV Nr.: A
SHEET No.: / BLAD Nr.: 005

DOSSIER NUMBER / DOSSIER NUMMER: 294447