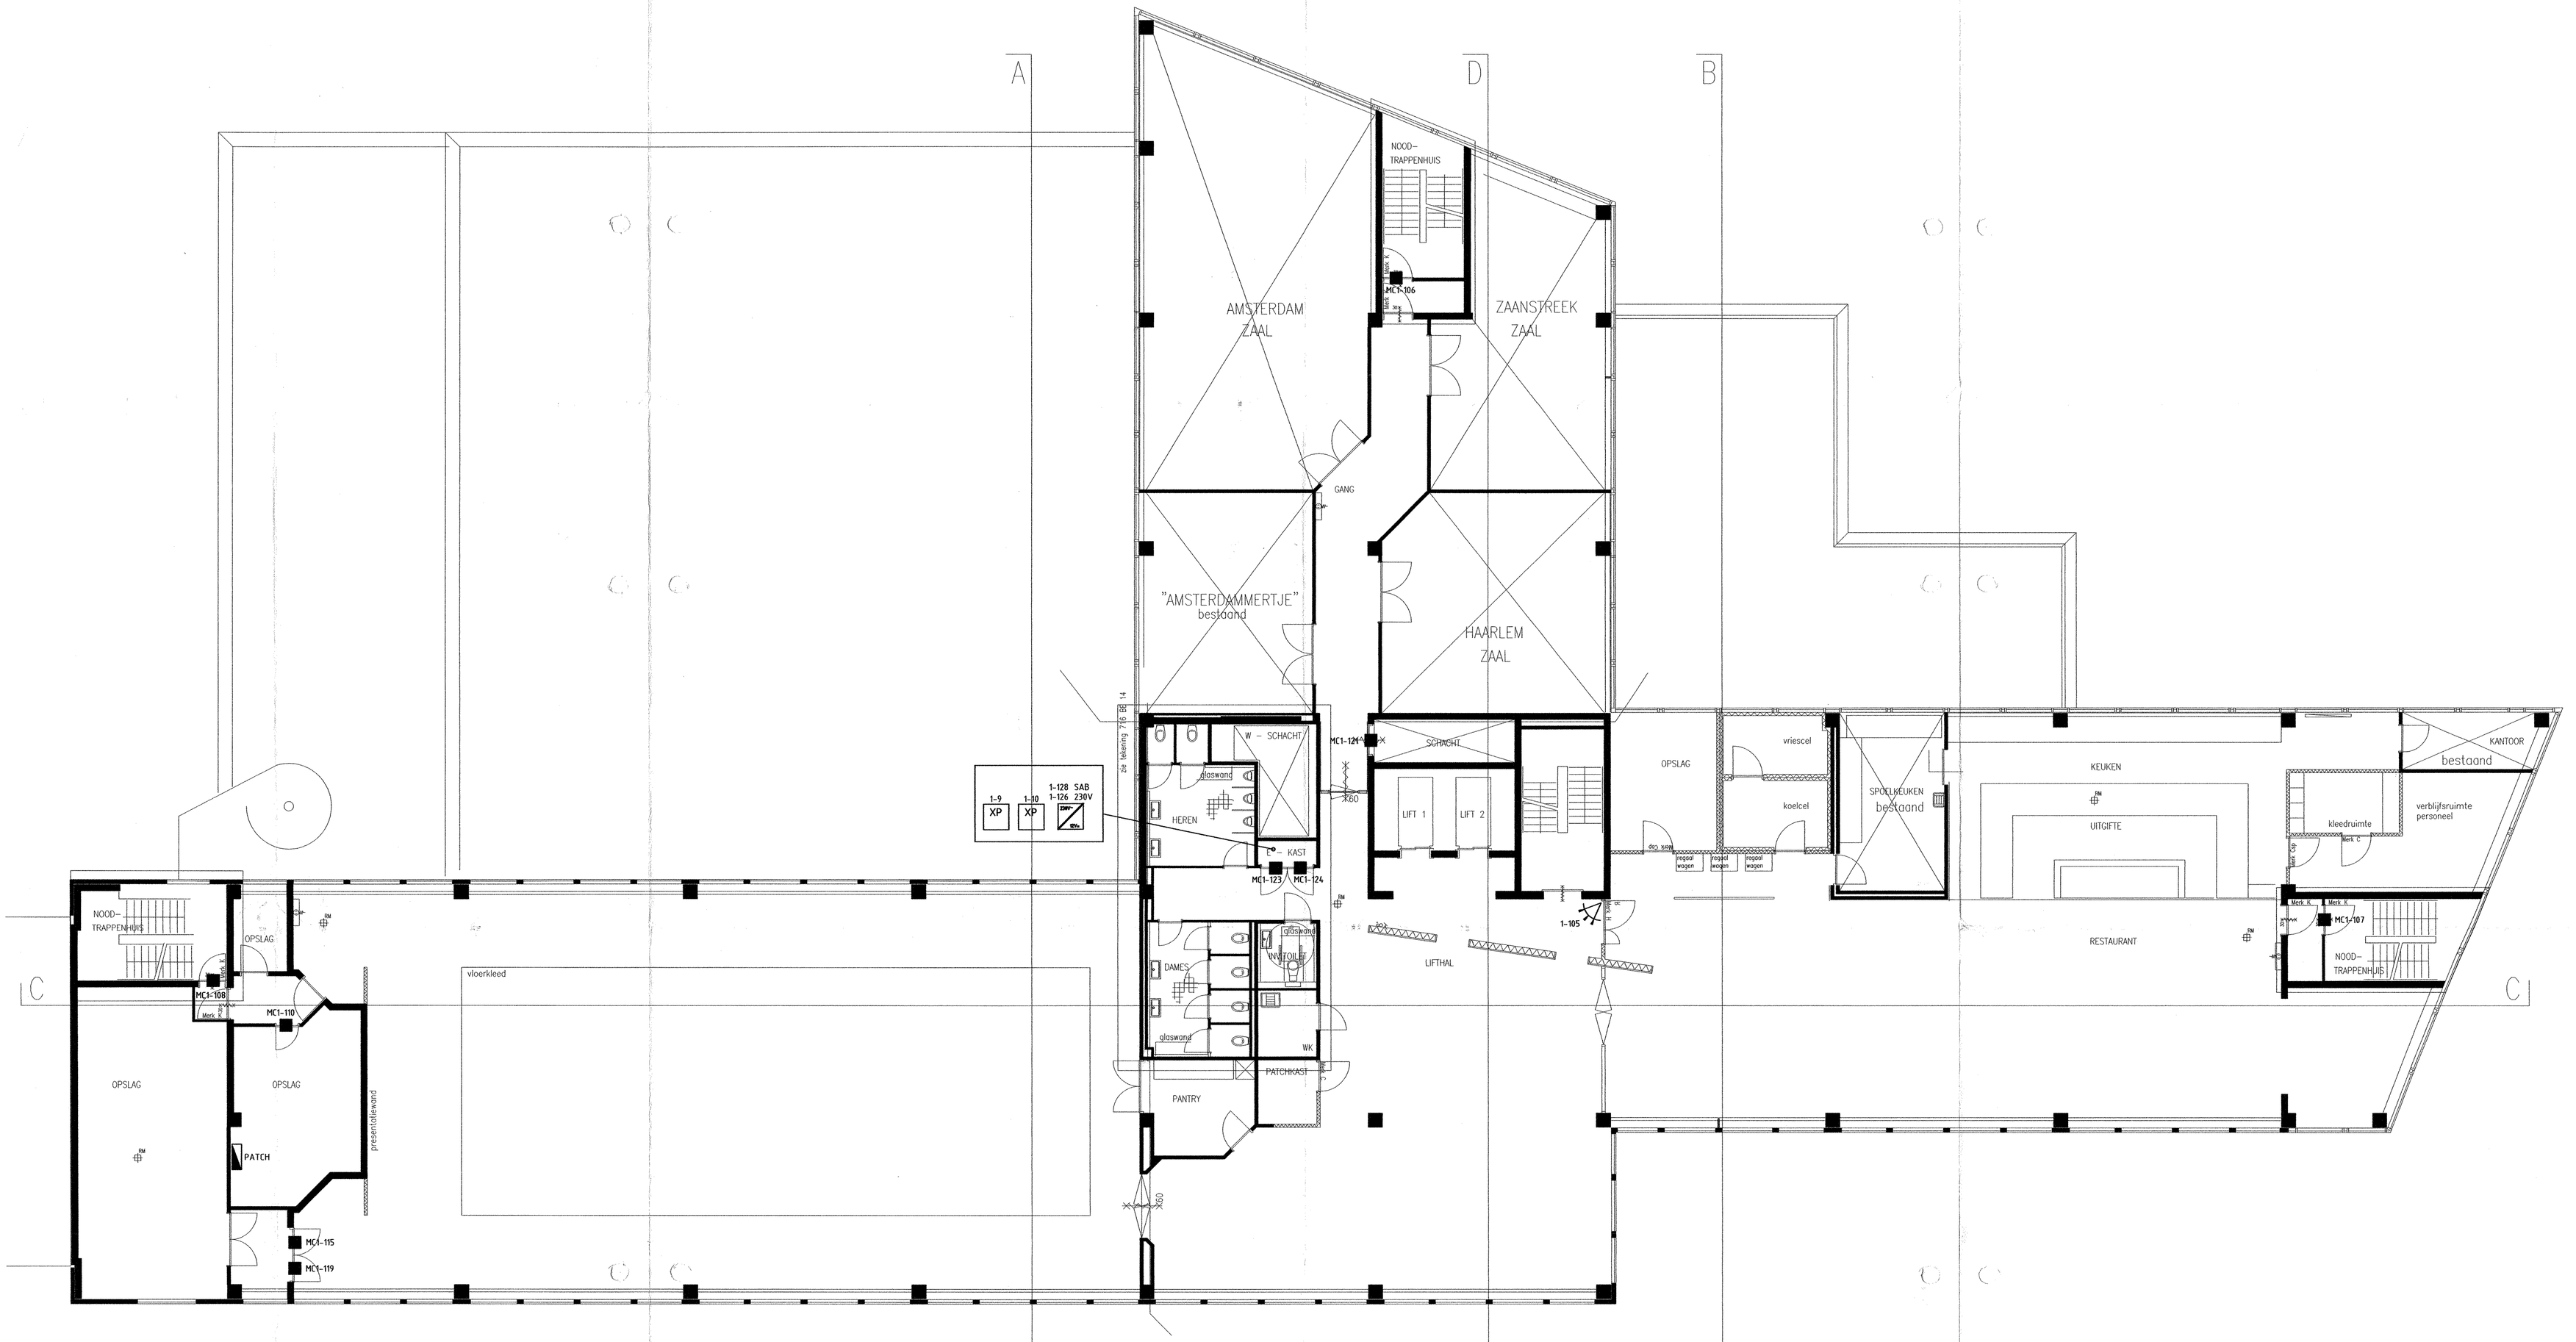

SYMBOLENLIJST TOEGANGSCONTROLE INST.	
SYMBOOL	OMSCHRIJVING
KL	KAARTLEZER
ES	ELEKTRISCHE SLUITPLAAT
RTE	RTE DRUKKNOP
ND	NOODDRUKKNOP
MPC	MPC CENTALE
XP	EXPANDER POD
DP	DEUR POD
12V	VOEDING 12V

SYMBOLENLIJST INBRAAKBEVEILIGINGS INST.	
SYMBOOL	OMSCHRIJVING
MC	MAGNEETCONTACT
	PIR WIDEBEAM
	WATERDETECTIE
	OVERVALSKNOP
	SIGNAALGEVER OVERVALSKNOP
SC	SCHOOTCONTACT
PATCH	PATCHKAST

Chubb Varel
A UTC Fire & Security Company
National Accounts
Hettenheuveleeg 51
1101 BM Amsterdam

omschrijving/description

- ☐ TER INFORMATIE / FOR INFORMATION
- ☐ VOORLOPIG ONTWERP / PREDESIGN
- ☐ TER CONTROLE / FOR APPROVAL
- ☐ VOOR UITVOERING / FOR CONSTRUCTION
- ☐ DEFINITIEF ONTWERP / FINAL DESIGN
- ☐ ALS UITGEVOERD / AS BUILT
- ☐ ONGECONTR. KOPIE / UNCONTR. COPY
- ☐ ANDERS NL. / OTHER I.E.

datum/date
handtek/signature

REV REV	DATE DATUM	DESCRIPTION AND PROJECTNUMBER OMSCHRIJVING EN PROJECTNUMMER	DWN BY GET. DOOR	CHK'D BY GEC.DOOR	CV APPR. CV AKKD.	CLIENT APPR. KLANT AKKD.
A	14/05/09	AS BUILT / 42971324	HV	MW	MvD	
0	20/02/08	ONTWERP	HV	WvdR	WvdR	

This document is confidential. The copyright is vested in Chubb Varel Security B.V. Amsterdam, the netherlands. All rights reserved. Neither the whole nor any part of this document may be disclosed to any third party or reproduced, stored in any retrieval system transmitted in any form or by any means (electronic, mechanical repro graphic, recording or otherwise) without the prior written consent of the copyright owner.

TITLE / TITEL: INBRAAK & TOEGANGCONTROLE INSTALLATIE
PROJECTERING 5E VERDIEPING

Chubb Varel
A UTC Fire & Security Company

CHUBB VAREL DRAWING No./CHUBB VAREL TEK.Nr.: 294447-20606.007

CLIENT DRAWING No./KLANT TEK.Nr.:

CLIENT / KLANT
KAMER VAN KOOPHANDEL
RUYTERKADE 5
1013 AA AMSTERDAM

FORMAT FORMAAT: A1
SCALE SCHAAL: 1:100
REV No.: REV Nr.: A
SHEET No.: BLAD Nr.: 007

DOSSIER NUMBER / DOSSIER NUMMER: 294447