



gaoninger B6

P-ingang

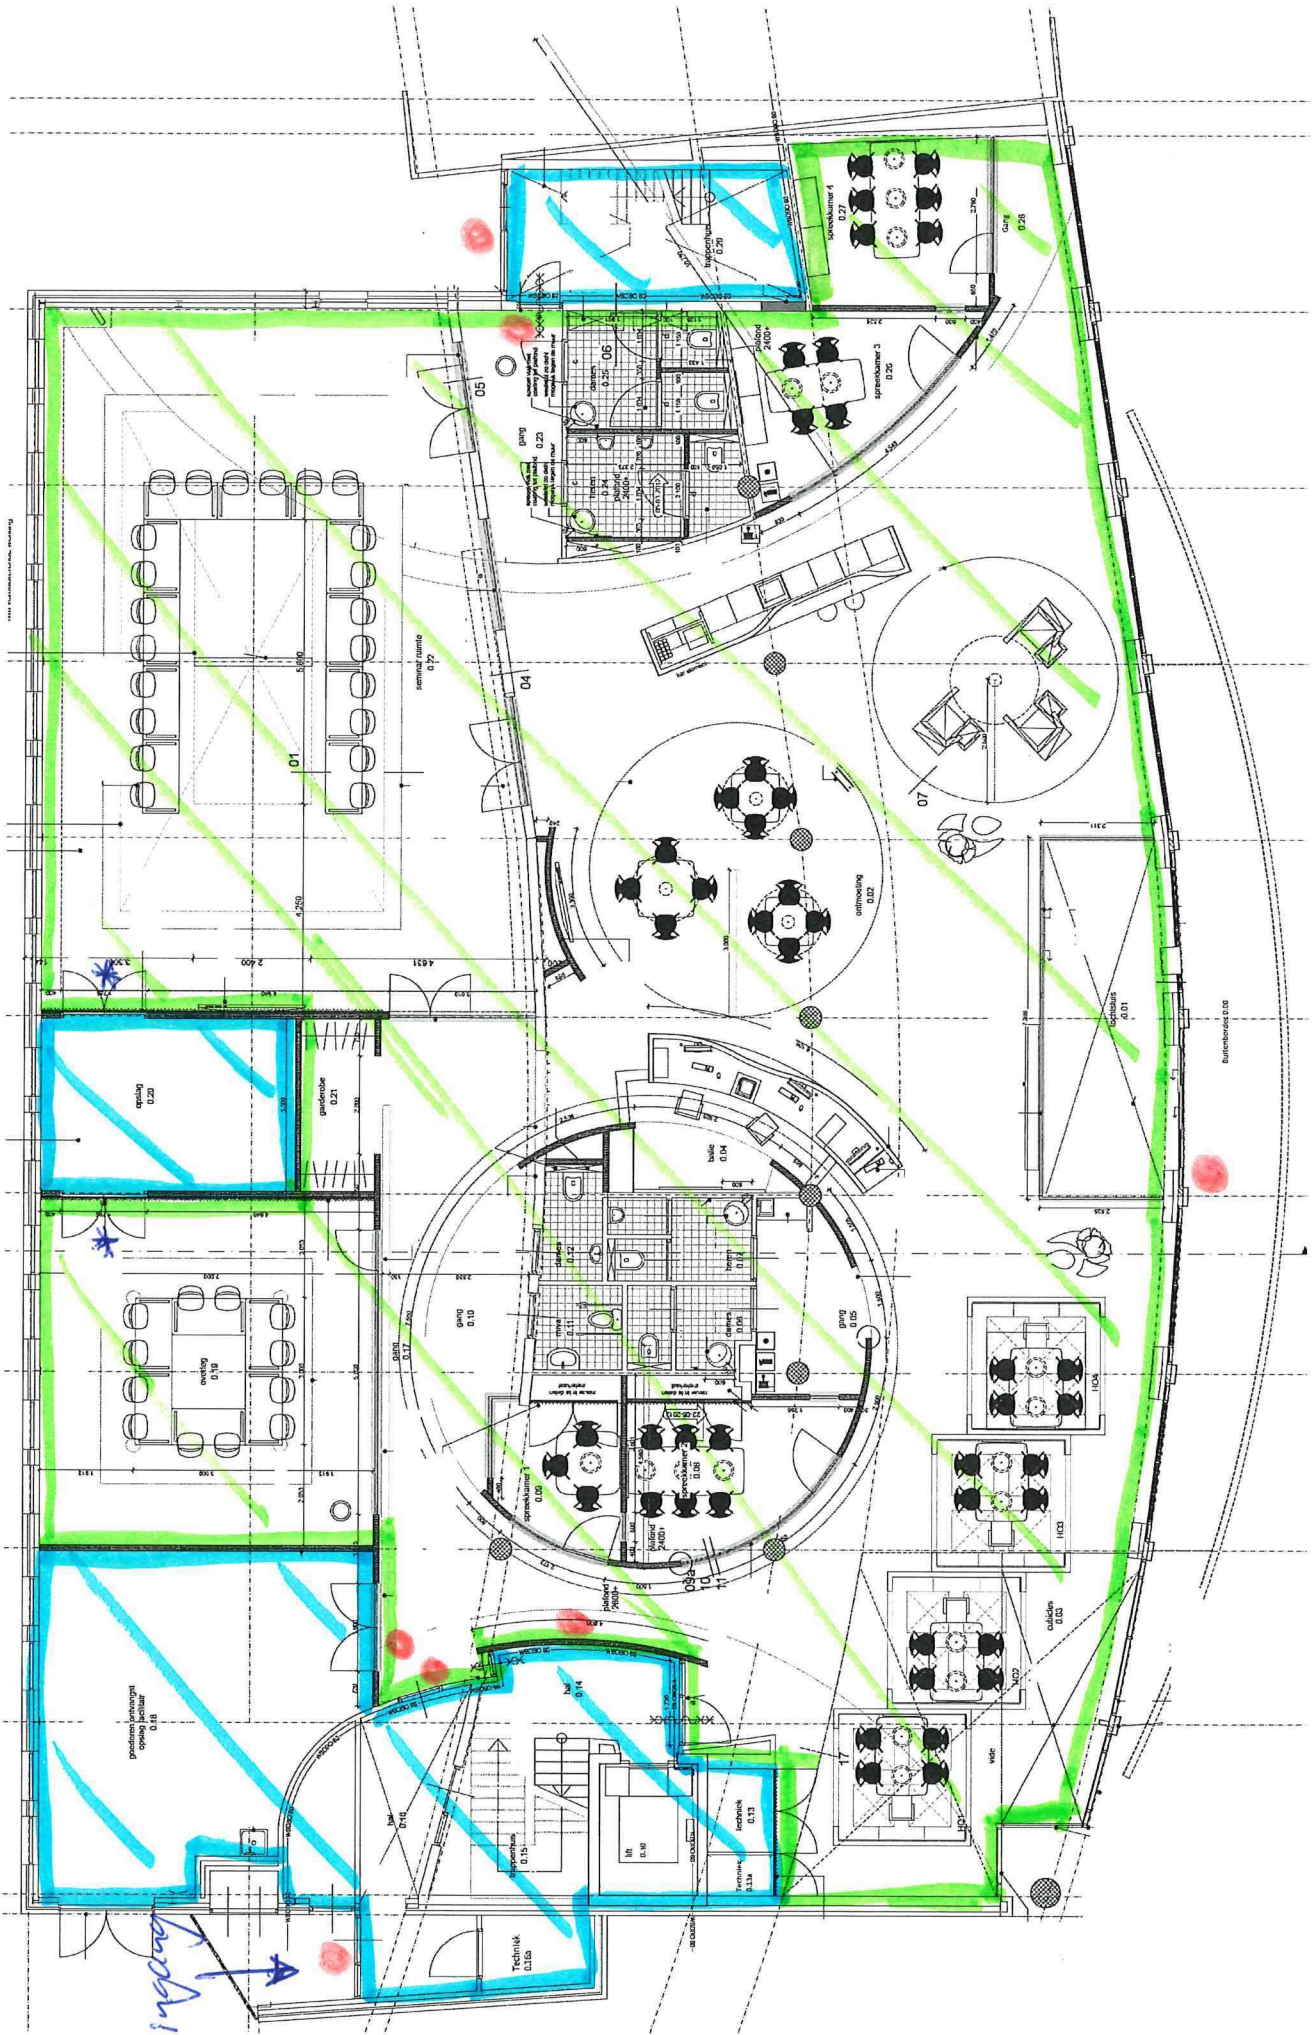


groningen 2e etage

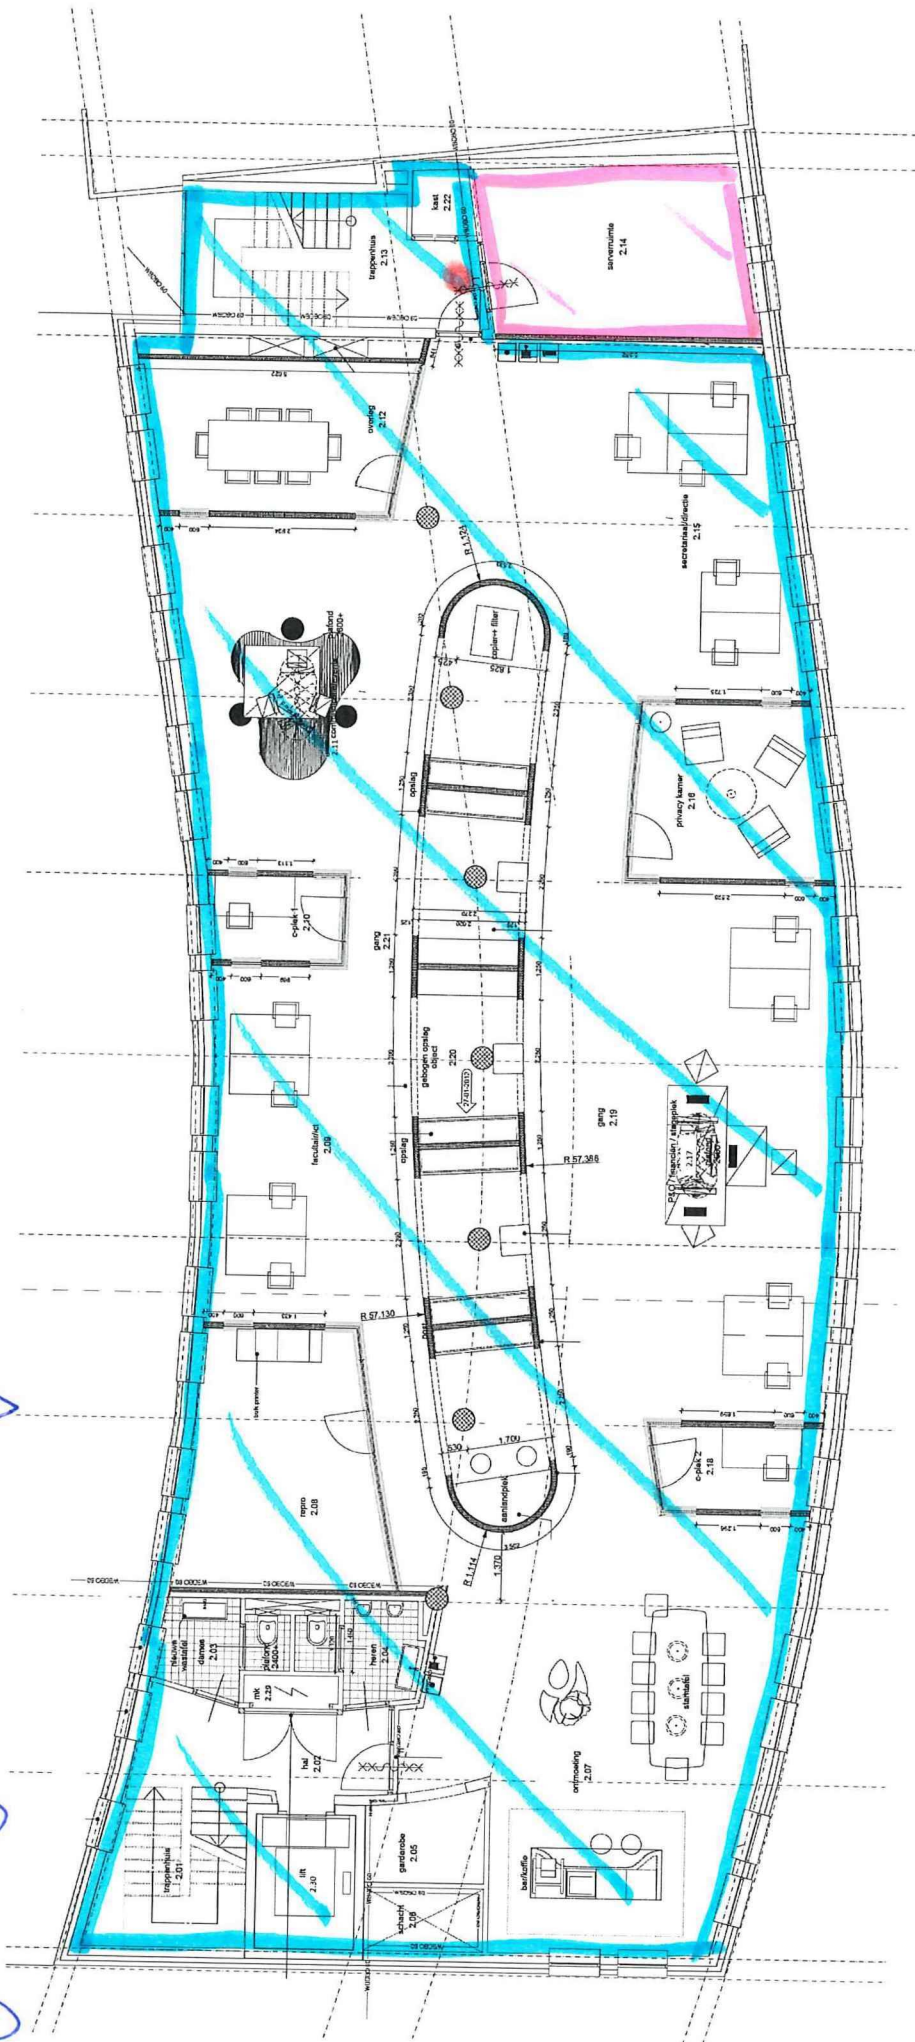

beveiligd II

virtueel III


gaarlingen u e stage

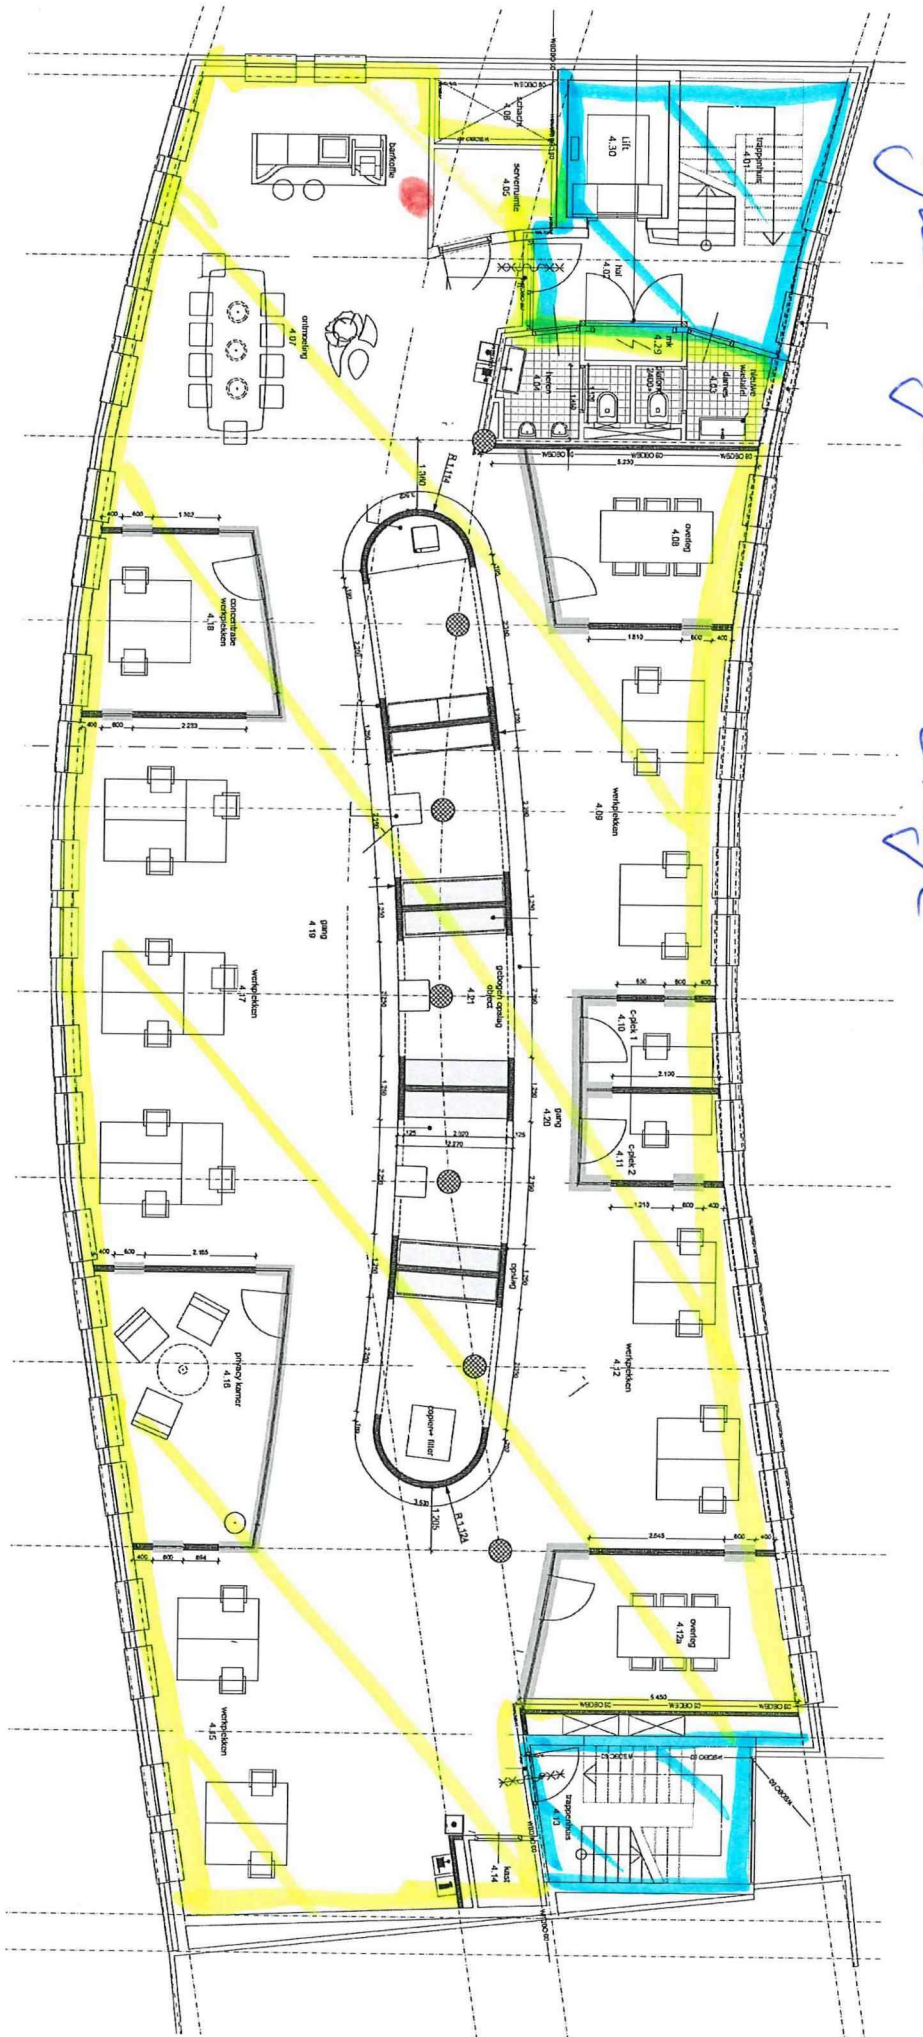

— beveiliging II

— Extensie IV

█ Extension IV

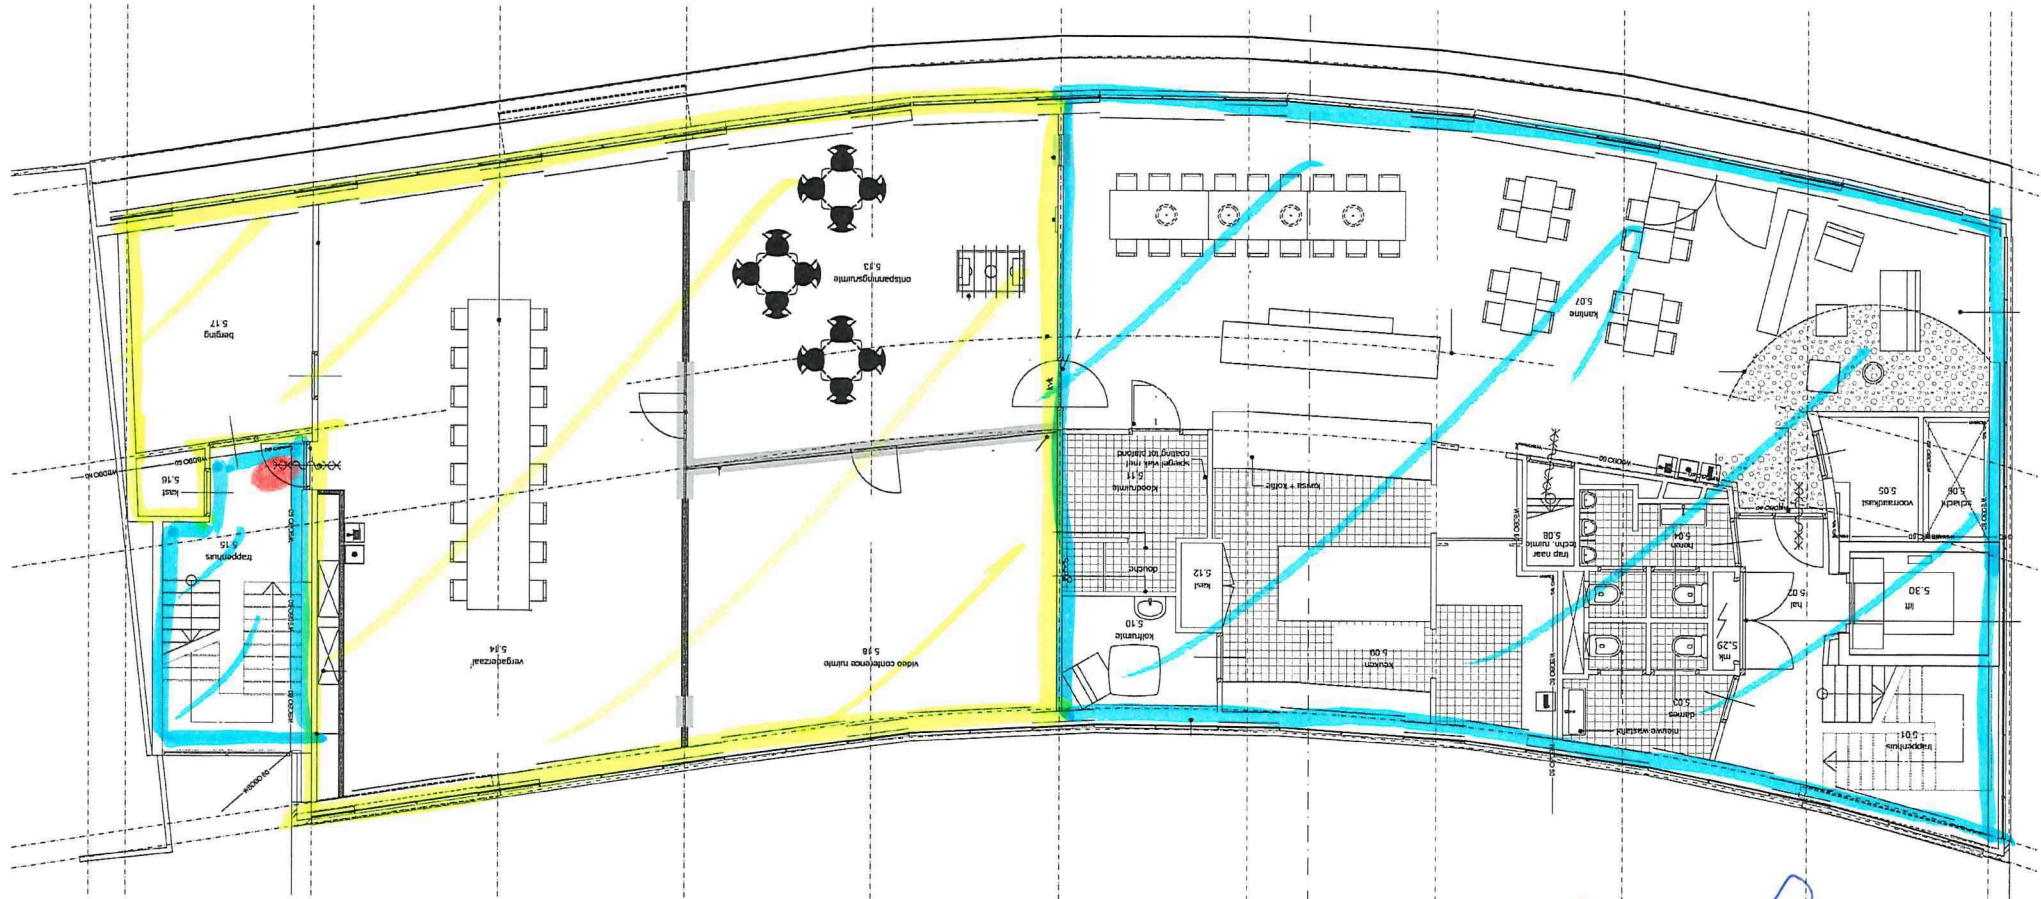

