


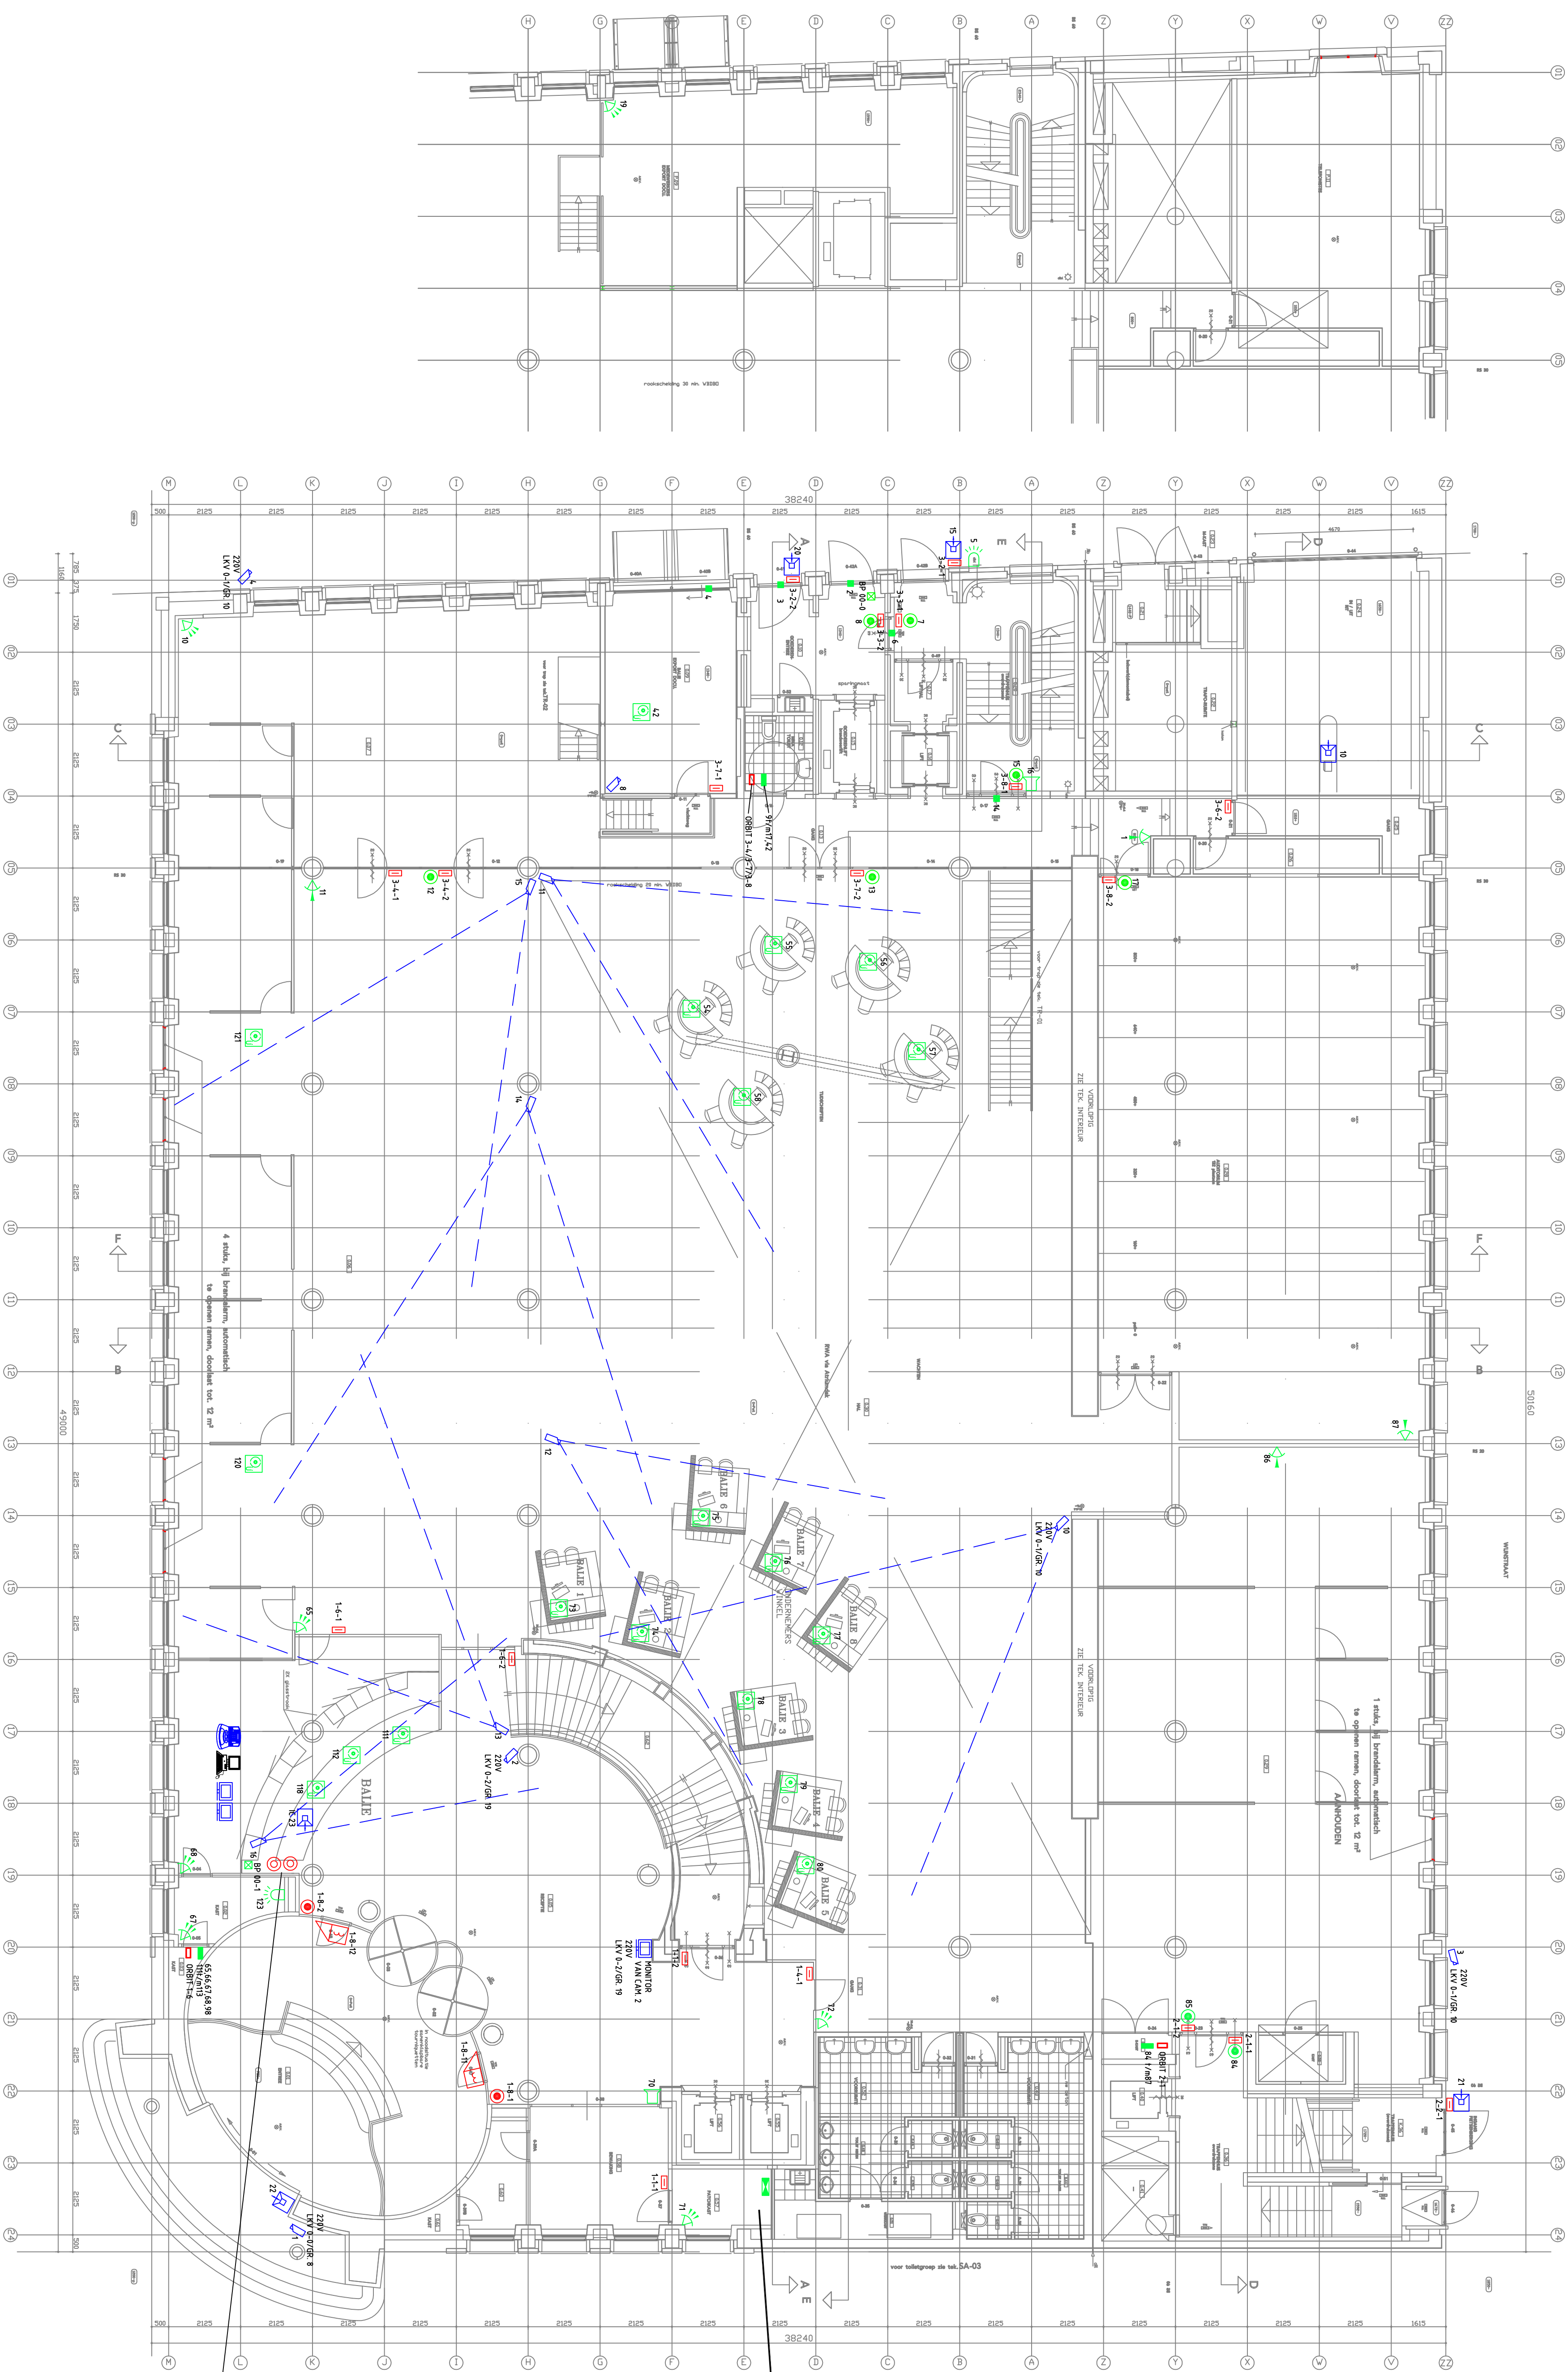

SYMBOL	VERKLARING
	CENTRAAL MELDPAANEL
	BEDIENINGS PANEEL
	DETECTOR WIDE ANGLE
	DETECTOR LONG RANGE
	DETECTOR 360°
	MAGNEET KNOT AKTI
	OVERVAL KNOT
	SUPERISIE PUNT
	OPTISCHE SIGNAALGEVER
	AKOESTISCHE SIGNAALGEVER
	PD
	GRATIE HANDELDER (BU) NOD DEUR OPEN
	DRIKKNOP
	LED
	MONITOR
	KAAATLEZER
	DRIKKNOP
	NODDRIKER
	ELECTRISCHE DOORSLOT
	CAMERA
	BEDIENINGSUNIT CCTV
	INTERCOM

INBASKAM	TEGANGS CONTROL
MINI MUSD	ORBIT 1-3/1-4/1-7/1-8
GATEWAY 4-PUSU	PUSU 1-b.v. ORBIT 1-3/1-7/1-7
GATEWAY 4-PUSU	I/O ORBIT
DELETO	
SERVER TEGANG	230V 10V 3-2
	GR 9 9 CTCT/10/TEGANGS CONTROL
	GR 21 INTERCON
	GR 21 INBASKAM

Opdr. nr./ref.		KAMER VAN KOOPHANDEL.	
Onderwerp		BEGANE GROND	
Adres		BLAAK 40	
Plaats		3001 TA ROTTERDAM	
Idaanteken:		358V0B1	
290108		REVISE	
121016		AS BUILT	
120331		REVISE BA + BK	
090210		REVISE	
290120		Omschrijving	
Akkoord		Datum	
Scheet 1: 100(A)		Sch. # 20075	
Datum: 18-04-01		Gef. t/b:	
E-mail: info@tyco.com		Tyco Fire and Security Nederland B.V.	
Versie 1.2 Tyco Fire and Security Nederland B.V. Postbus 265 2200 AG Capelle aan den IJssel Tel.: 0181 988 200 Fax: 0181 988 2445 Web: www.tyco.nl		TOEGANGSKONTROLE - SYSTEEM CCTV-INSTALLATIE INTERCOM-INSTALLATIE	
 tyco Integrated Fire & Security		ONTWERP MERK TEK. DEFINITIEF	
PROJECT STATUS			