

Renvoio:

[illegible]Isolatíe[illegible]Roosterstraat:

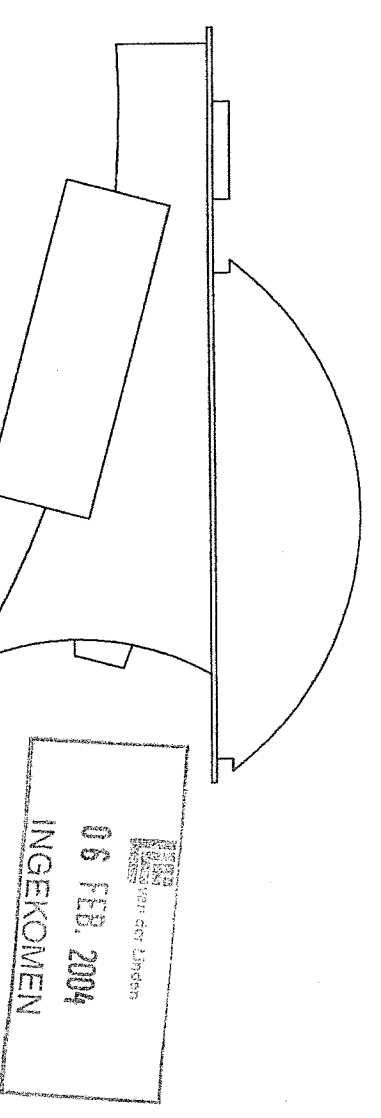


VOOR VERVOLG INSTALLATIE
ZIE TEK: W 10

Beg grond halfroond deel

801WUNDOG TERNESIG 1774W-00

[illegible]

06 FEB. 2004

REVISIE FEBRUARI 2003

BEDIJF VAN DER LINDEN B

GEYEND INGENIEURSBUREAU

ARCHITECTEN

TAB. SIMONIS PAADGEVEND

International

osterlicht College t

Abelino,

TB-Installatie (CV-)

eg grond half rond


DOCTORS

US 11

INSTALLATION

IEEE telephone (034
E-mail: Install

277

[illegible]

turn	11-02-2003
to	Avdy
2:	
total	150
total no:	
22292	
status:	
EVISIE	
email:	
0+	
declaring no:	
111	