


AANPASSING van de 38.020.165.25

Montage verlengstuk op staander

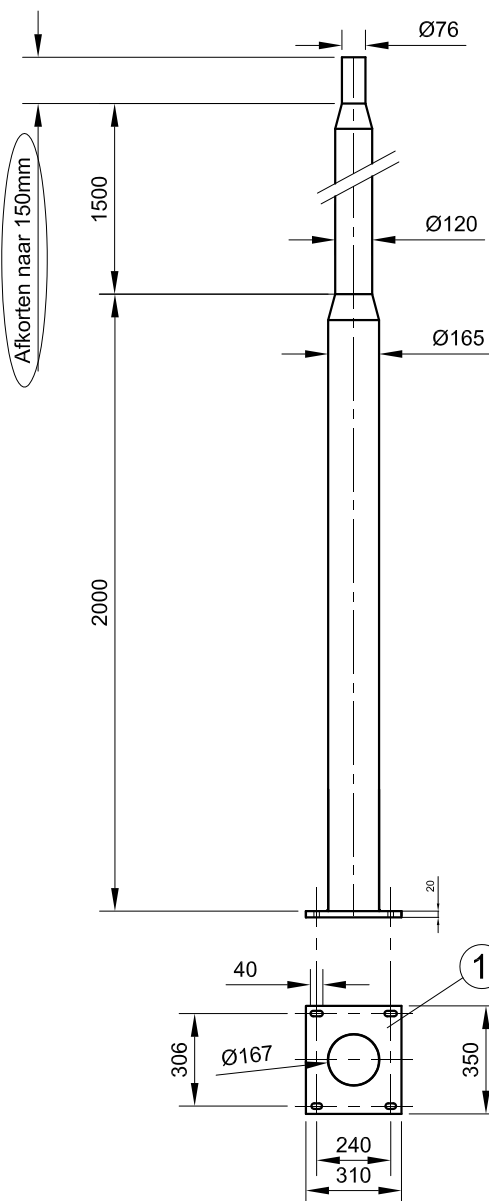

GESTREKTE LENGTE TOTAAL: 3800 (Naar 3650)
 GESTREKTE LENGTE TOP: 300
 BUIGPUNT B: 0
 PERSLENGTE: 4050
 MANTELOPPERVLAK: 1.67 m²
 GEWICHT: 20 kg
 WANDDIKTE: 3.3

A	4	16	Onderlegging	RVS	M16	
	3	16	Zelfborgende moer	RVS	M16	
	2	4	Draadeind	RVS	M16	L=300
	1	1	Voetplaat	Alu	350x310x20	-
	ITEMNO.	QUANTITY	DESCRIPTION	MATERIAL	DIMENSIONS	REMARKS
			sapa: Sapa Pole Products			
			Sapa Pole Products Alcoalaan 1 - 5151 RW Drunen Postbus 75 - 5150 AB Drunen Tel/Fax: +31(0)416-386100/230			
			THIS DRAWING REMAINS PROPERTY OF SAPA POLE PRODUCTS IN DRUNEN AND MAY WITHOUT PERMISSION OF THE OWNER NOT BE MULTIPLIED, BE USED FOR THIRD PARTIES OR BE GIVEN TO THIRD PARTIES FOR PERUSAL.	AM.PROJ. 	SURFACE ROUGHNESS CENTER LINE AVERAGE RA (CLA) IN µm BY ISO1302 EN40 UNLESS OTHERWISE STATED	DIMENSIONS TOLERANCES BY: <input checked="" type="checkbox"/> C
			DRAWN BY MRe	CHECKED BY (SIGNATURE)	SCALE 1:25	
			MATERIAL EN AW 6060 T66		DATE 10-03-11	
			FORMAT A4	REMARK T.b.v. LHP's tussen 8 en 10m	DRAWINGNUMBER 38.020.165.28	MODE A
			TITLE OV en ANWB-N detail tbv staander LPH 10m			