


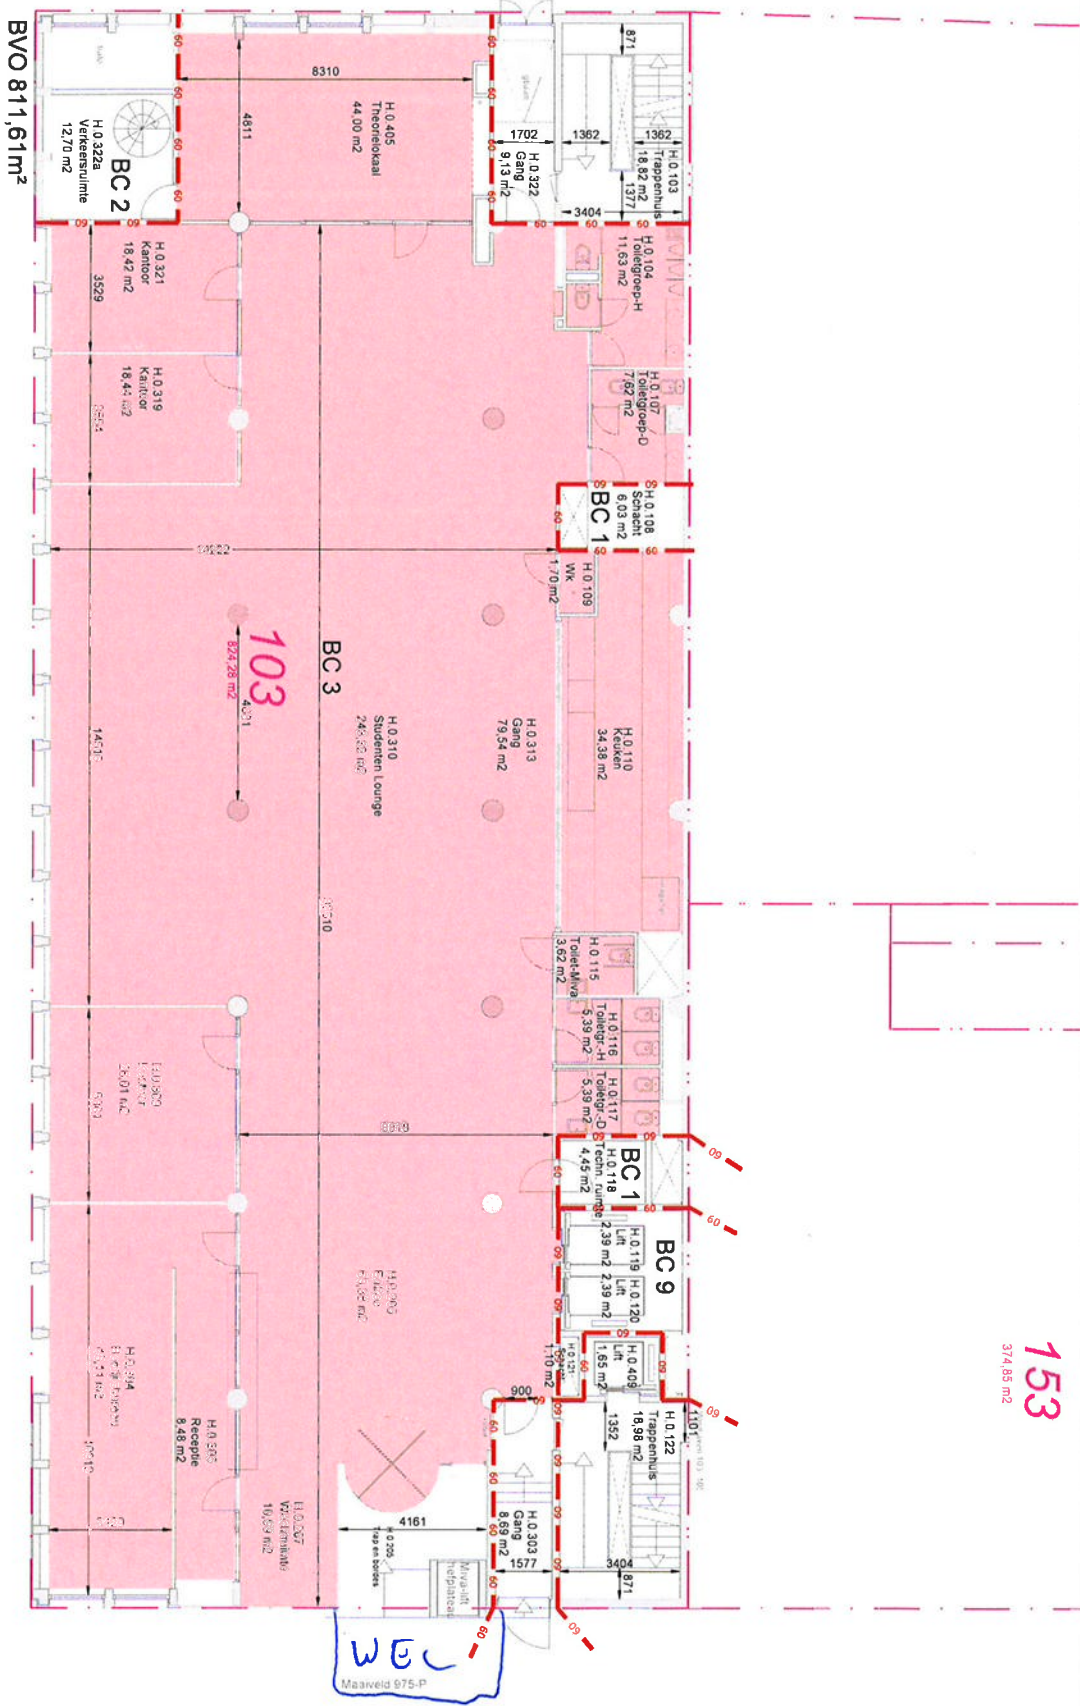

Legenda

50 Min Vind
50 Min Vind





153

WEL
Maarveld 975-P



WEL

[illegible]

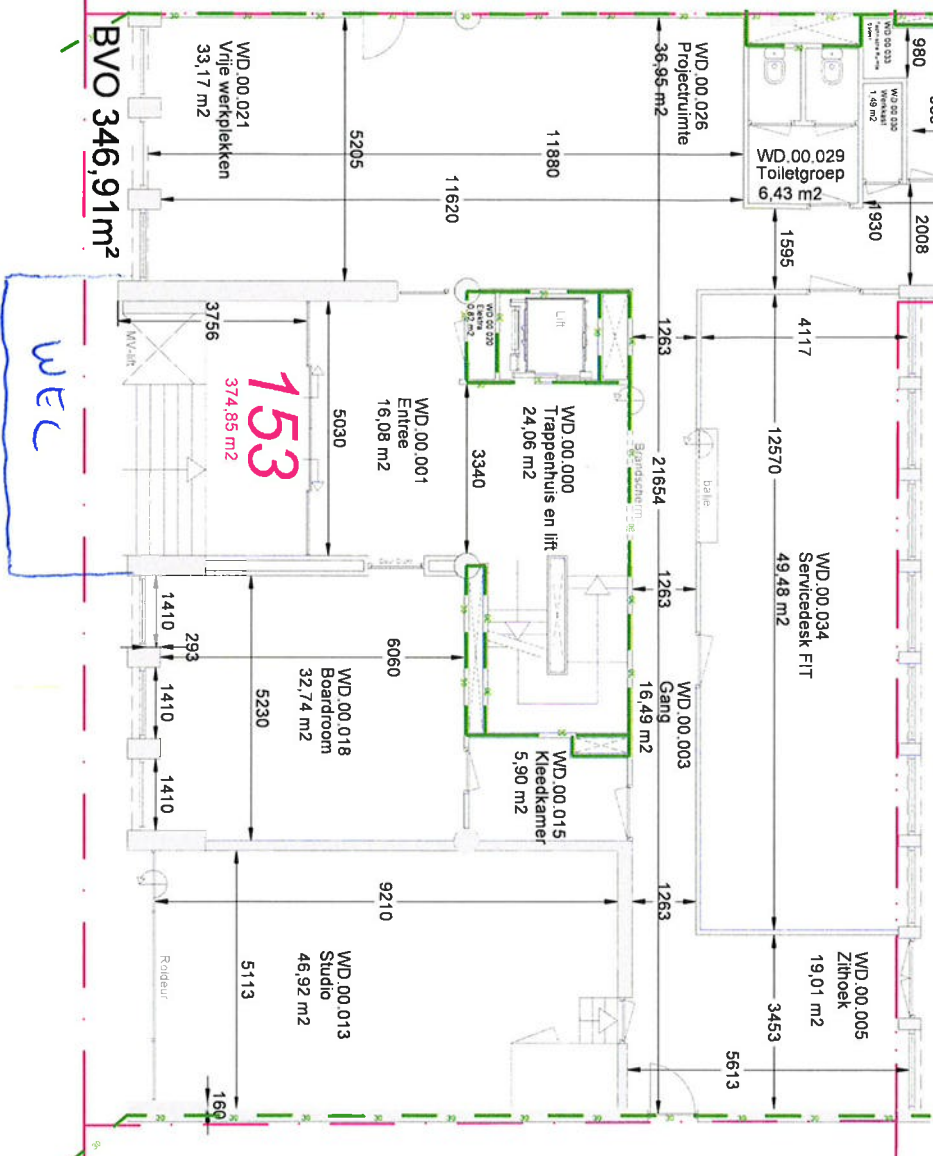


Legenda

30 Min Wand

Kadastrale Grens

[illegible]