
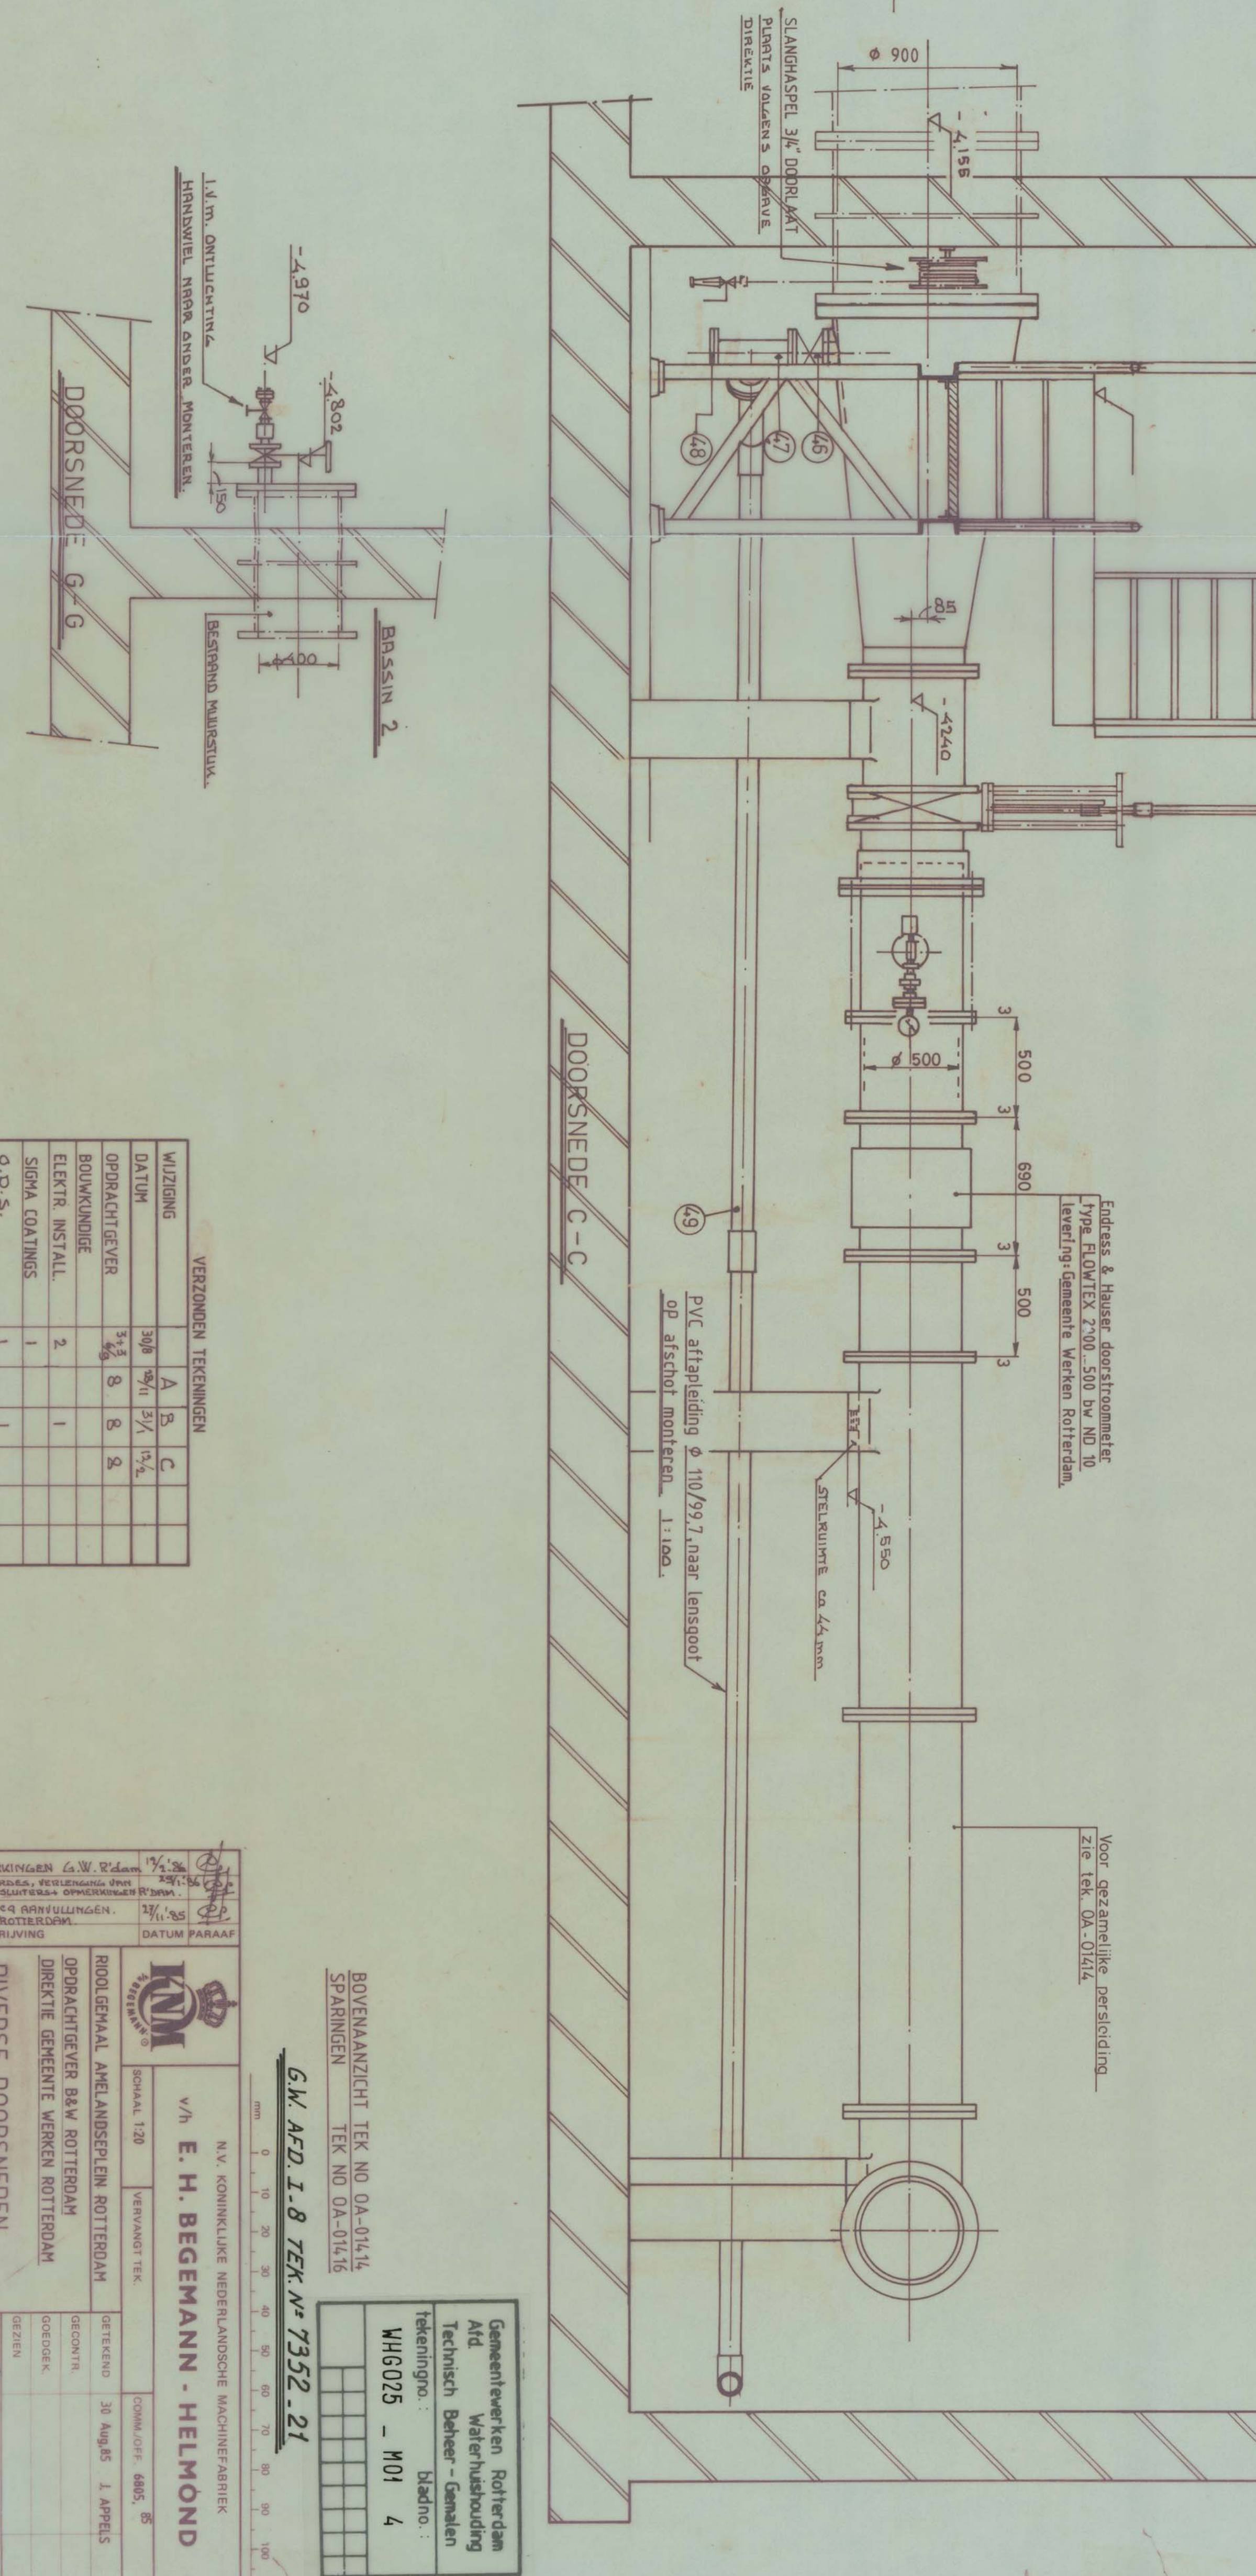
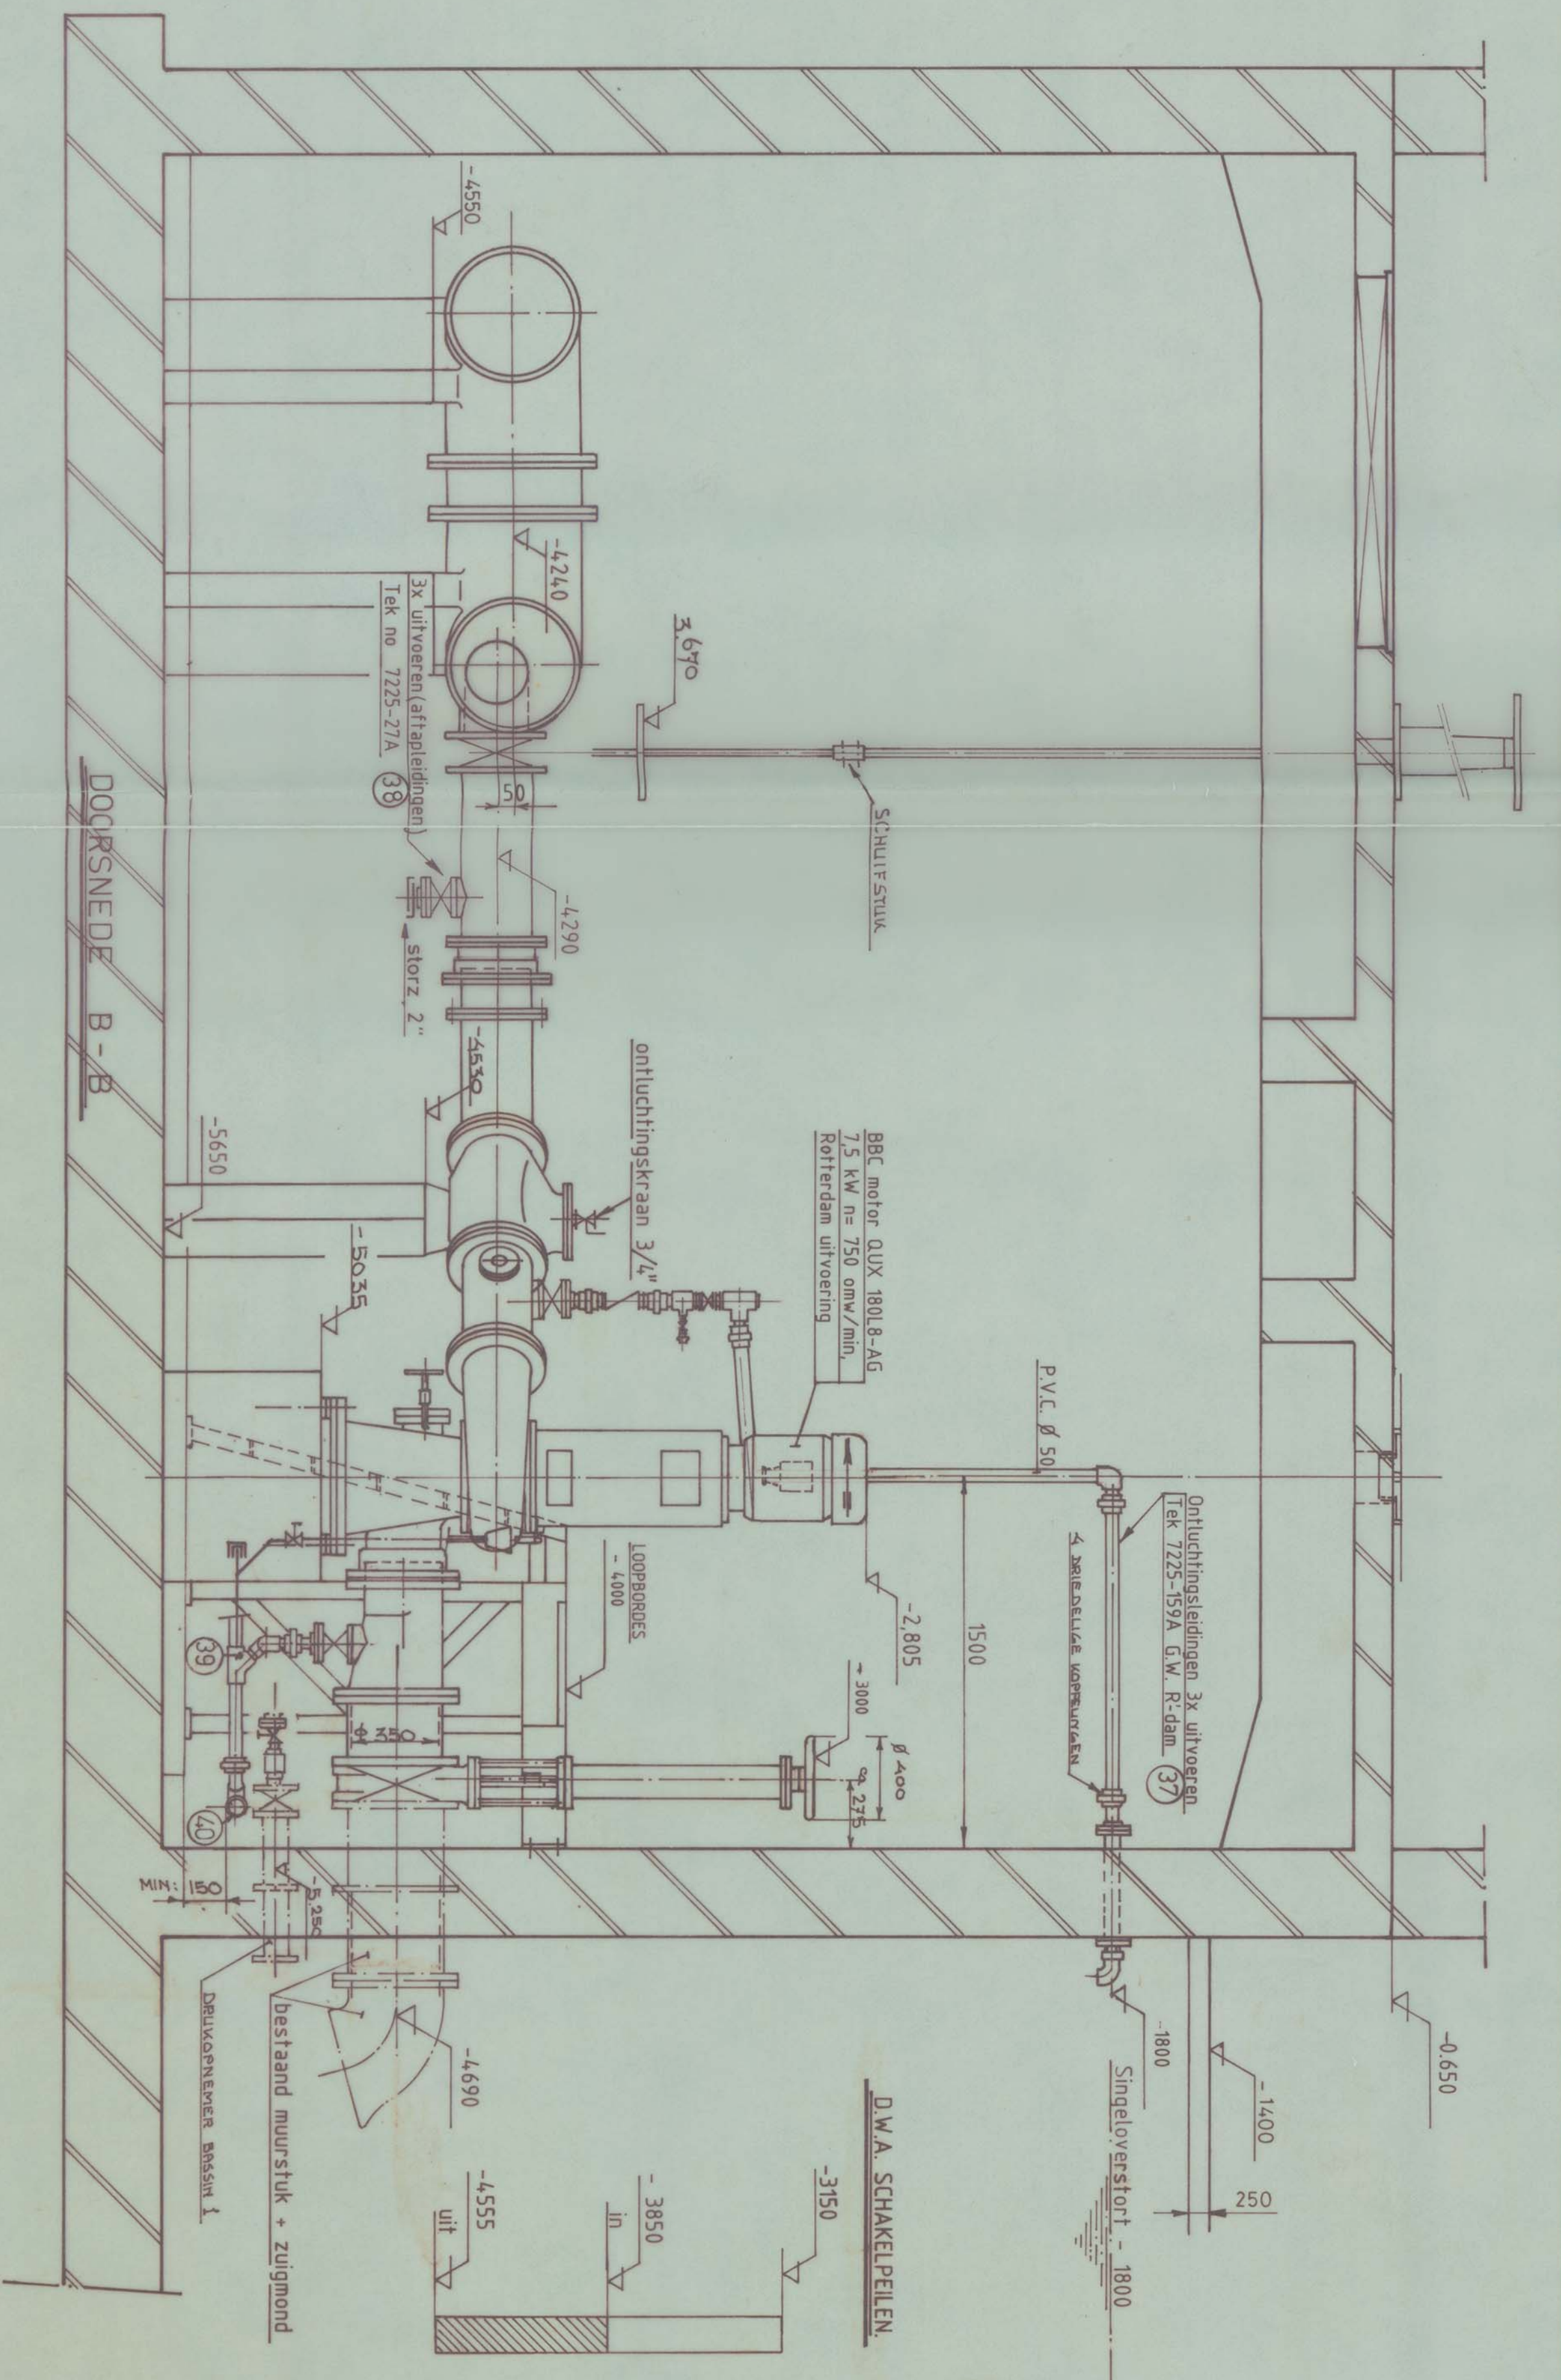


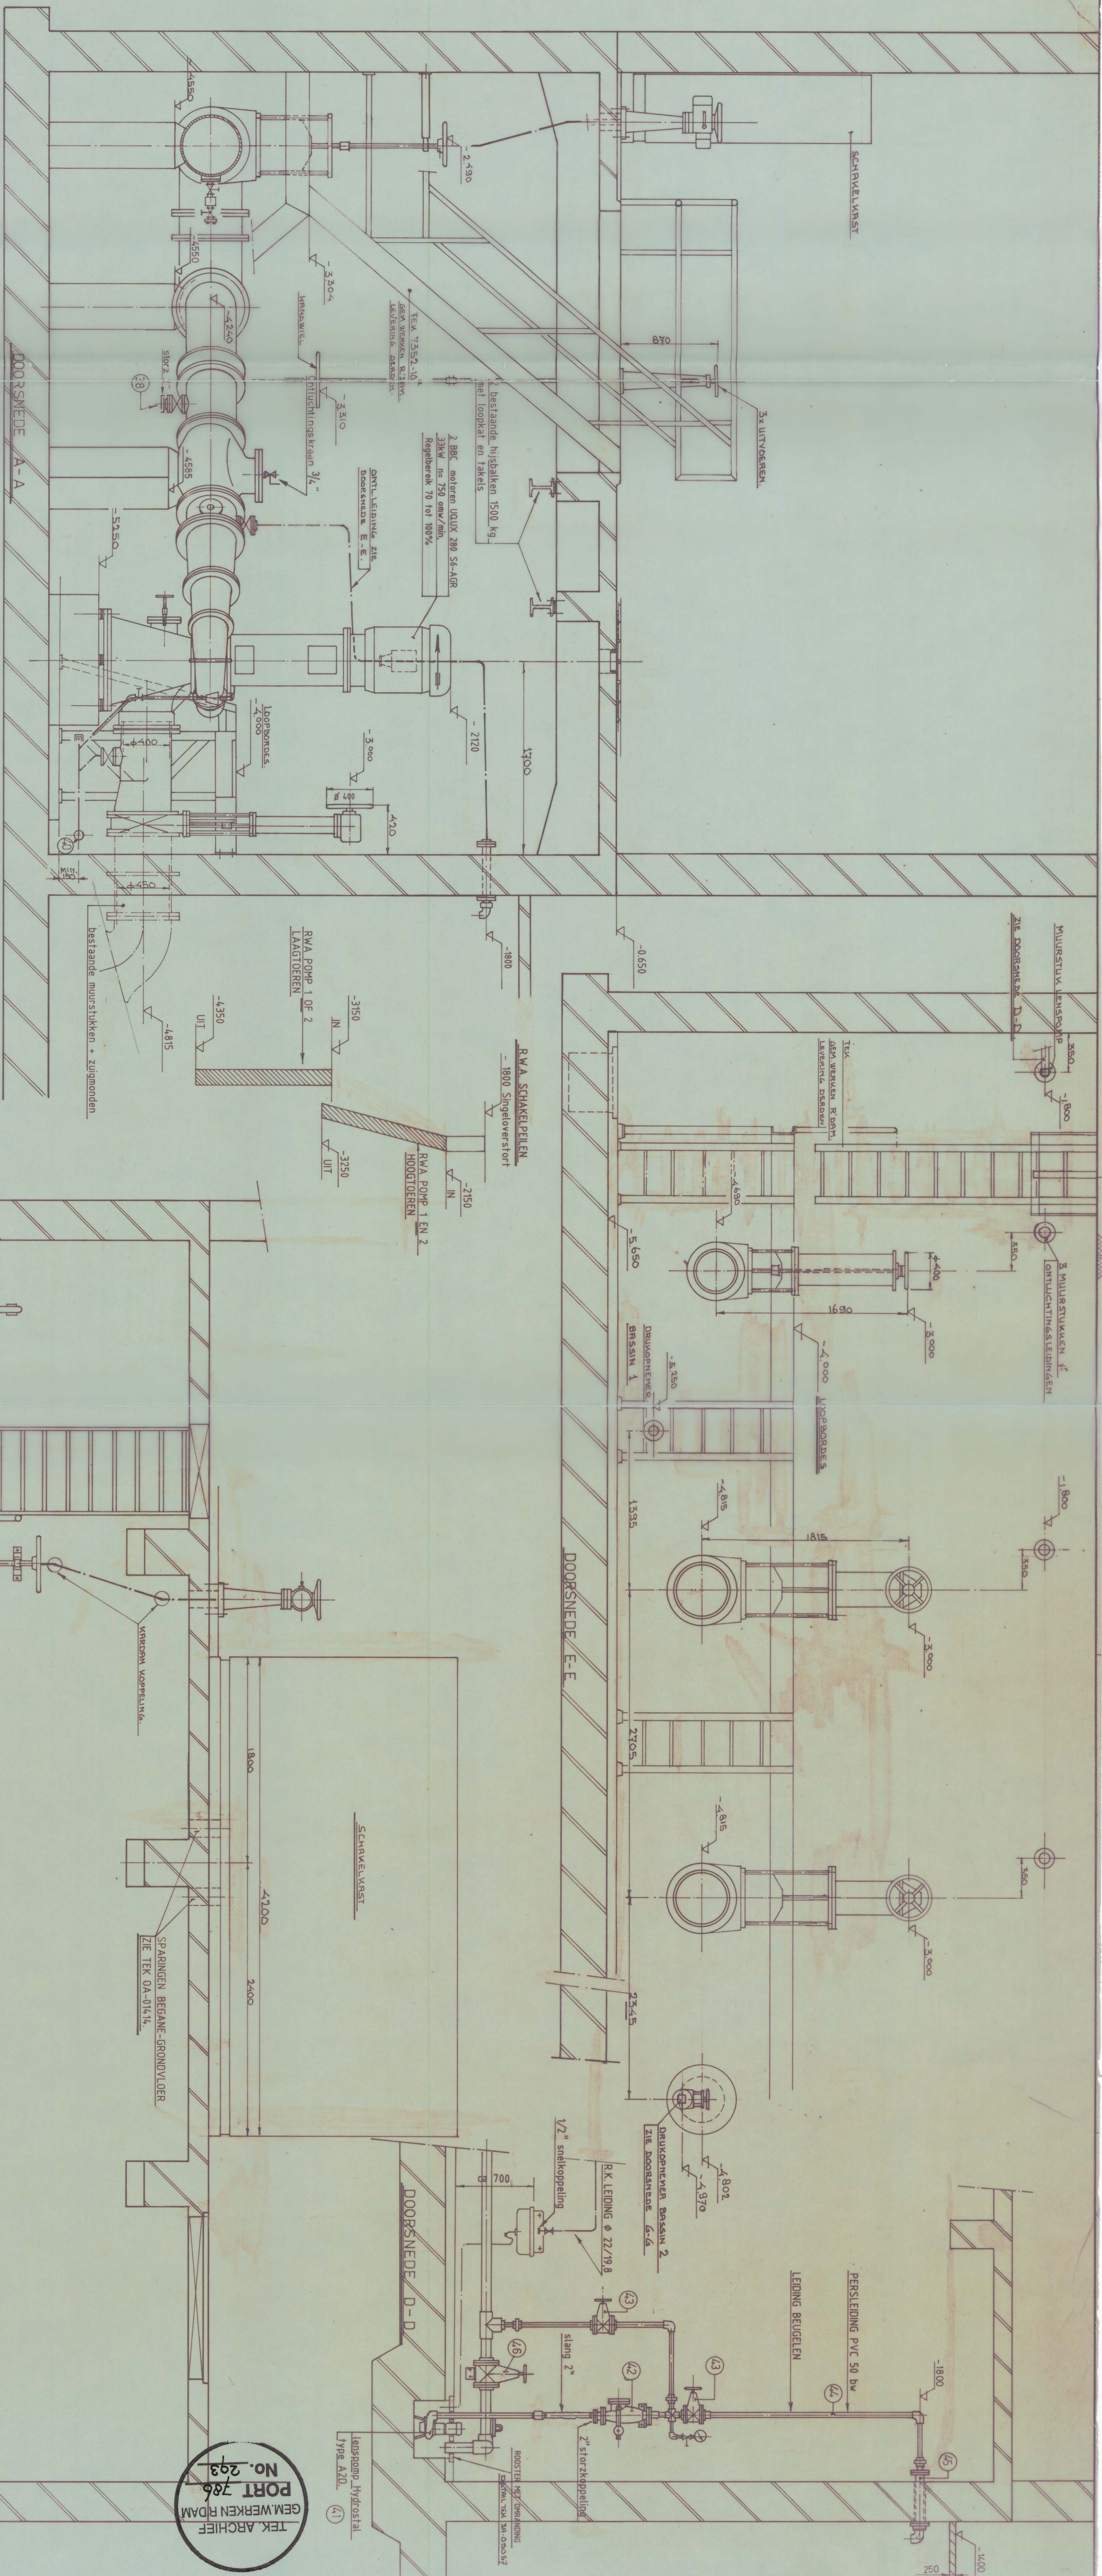

VERZONDEN TEGENNIEM									
WIZIUNG	A	B	C						
DATUM	190	3/1	1/1						
OPDRACHTGEVER	3/1	8	8	2					
BOUWNUMMER	1	1	1	1					
ELEKTR. INSTALL.	2	1	1	1					
SIGMA COATINGS	1	1	1	1					
O.D.S.	1	1	1	1					
FABRIEK									


