


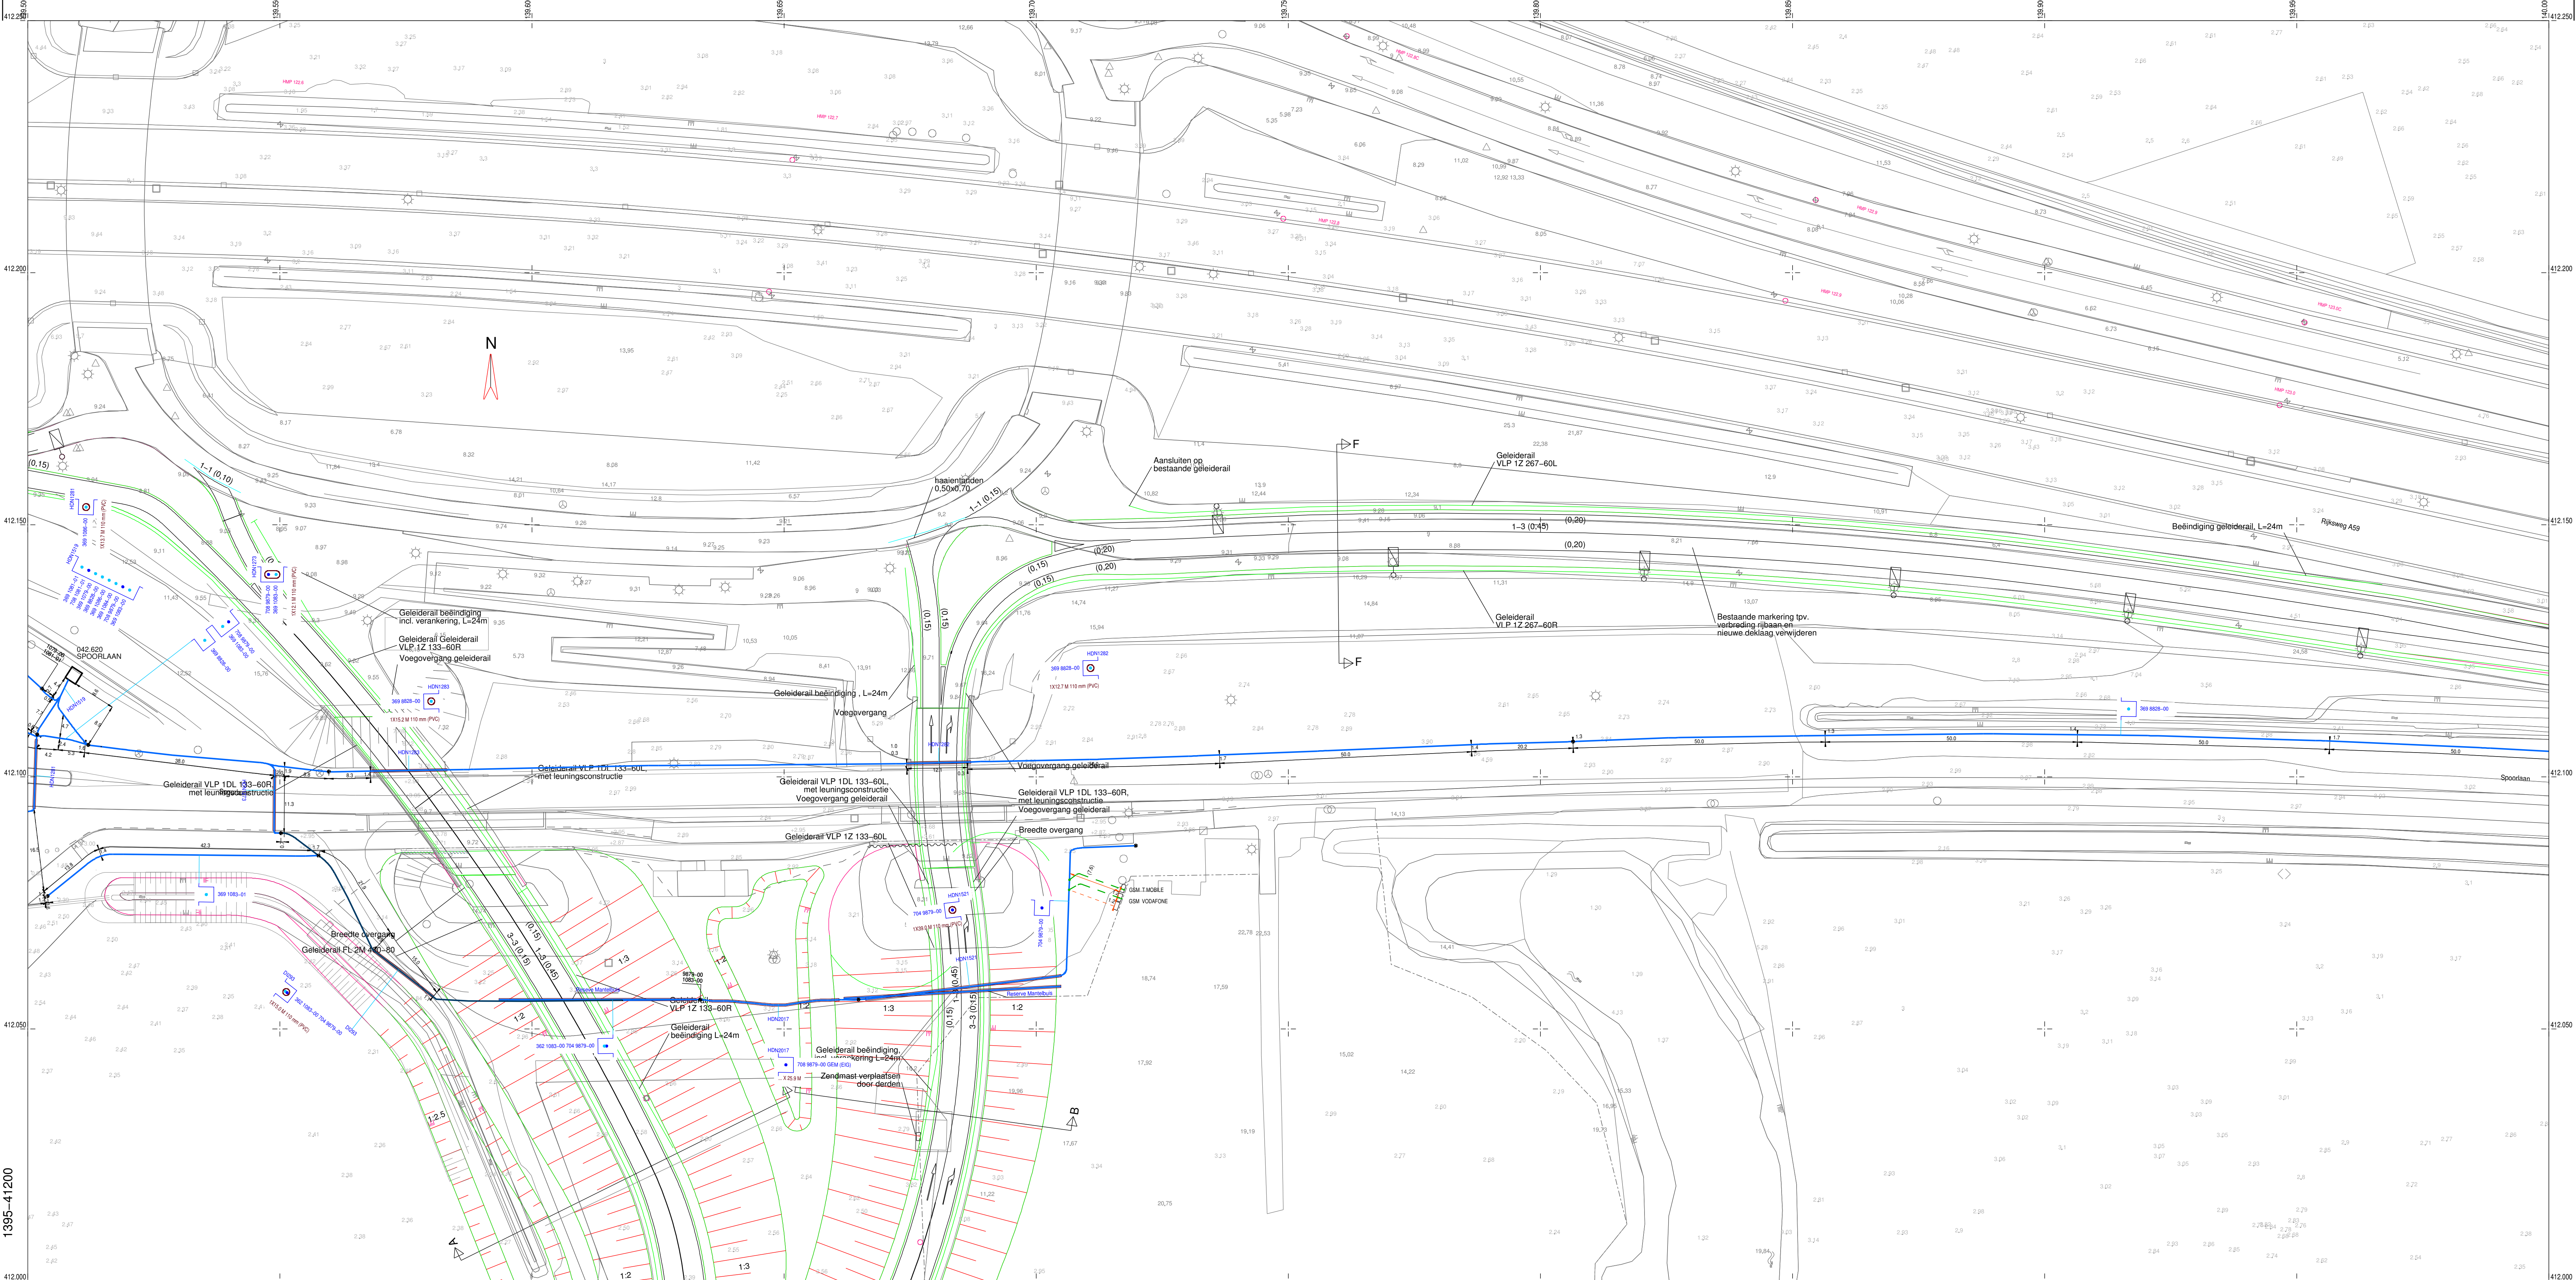

04/06/2013 BLS/OV

KABELBOODING				GEUL-STATUS		GEMEENTE(N) : HEUSDEN				Regio Brabant W.ald. Netplanning	
KODE	TYPE	VERKLARING	SYMBOL	OMSCHRIJVING		KOM :				Edisonstraat 60	
369	OV	445.000 Cu VIO-VMAKas		Digital ingangsm						4816 AX Breda	
708	LS	445.00 Al V-VMAKas		definitief lagging bekand						TEL.: 073-8530300	
362	OV	445.000 Cu VMAK								Pilot datum : 04/06/2013	
704	LS	445.00 Al VMAK								Applicatie : BLS/OV	
										Schaal : 1:500	
										Opmerking 1 :	
										Opmerking 2 :	
										1395-41200	