




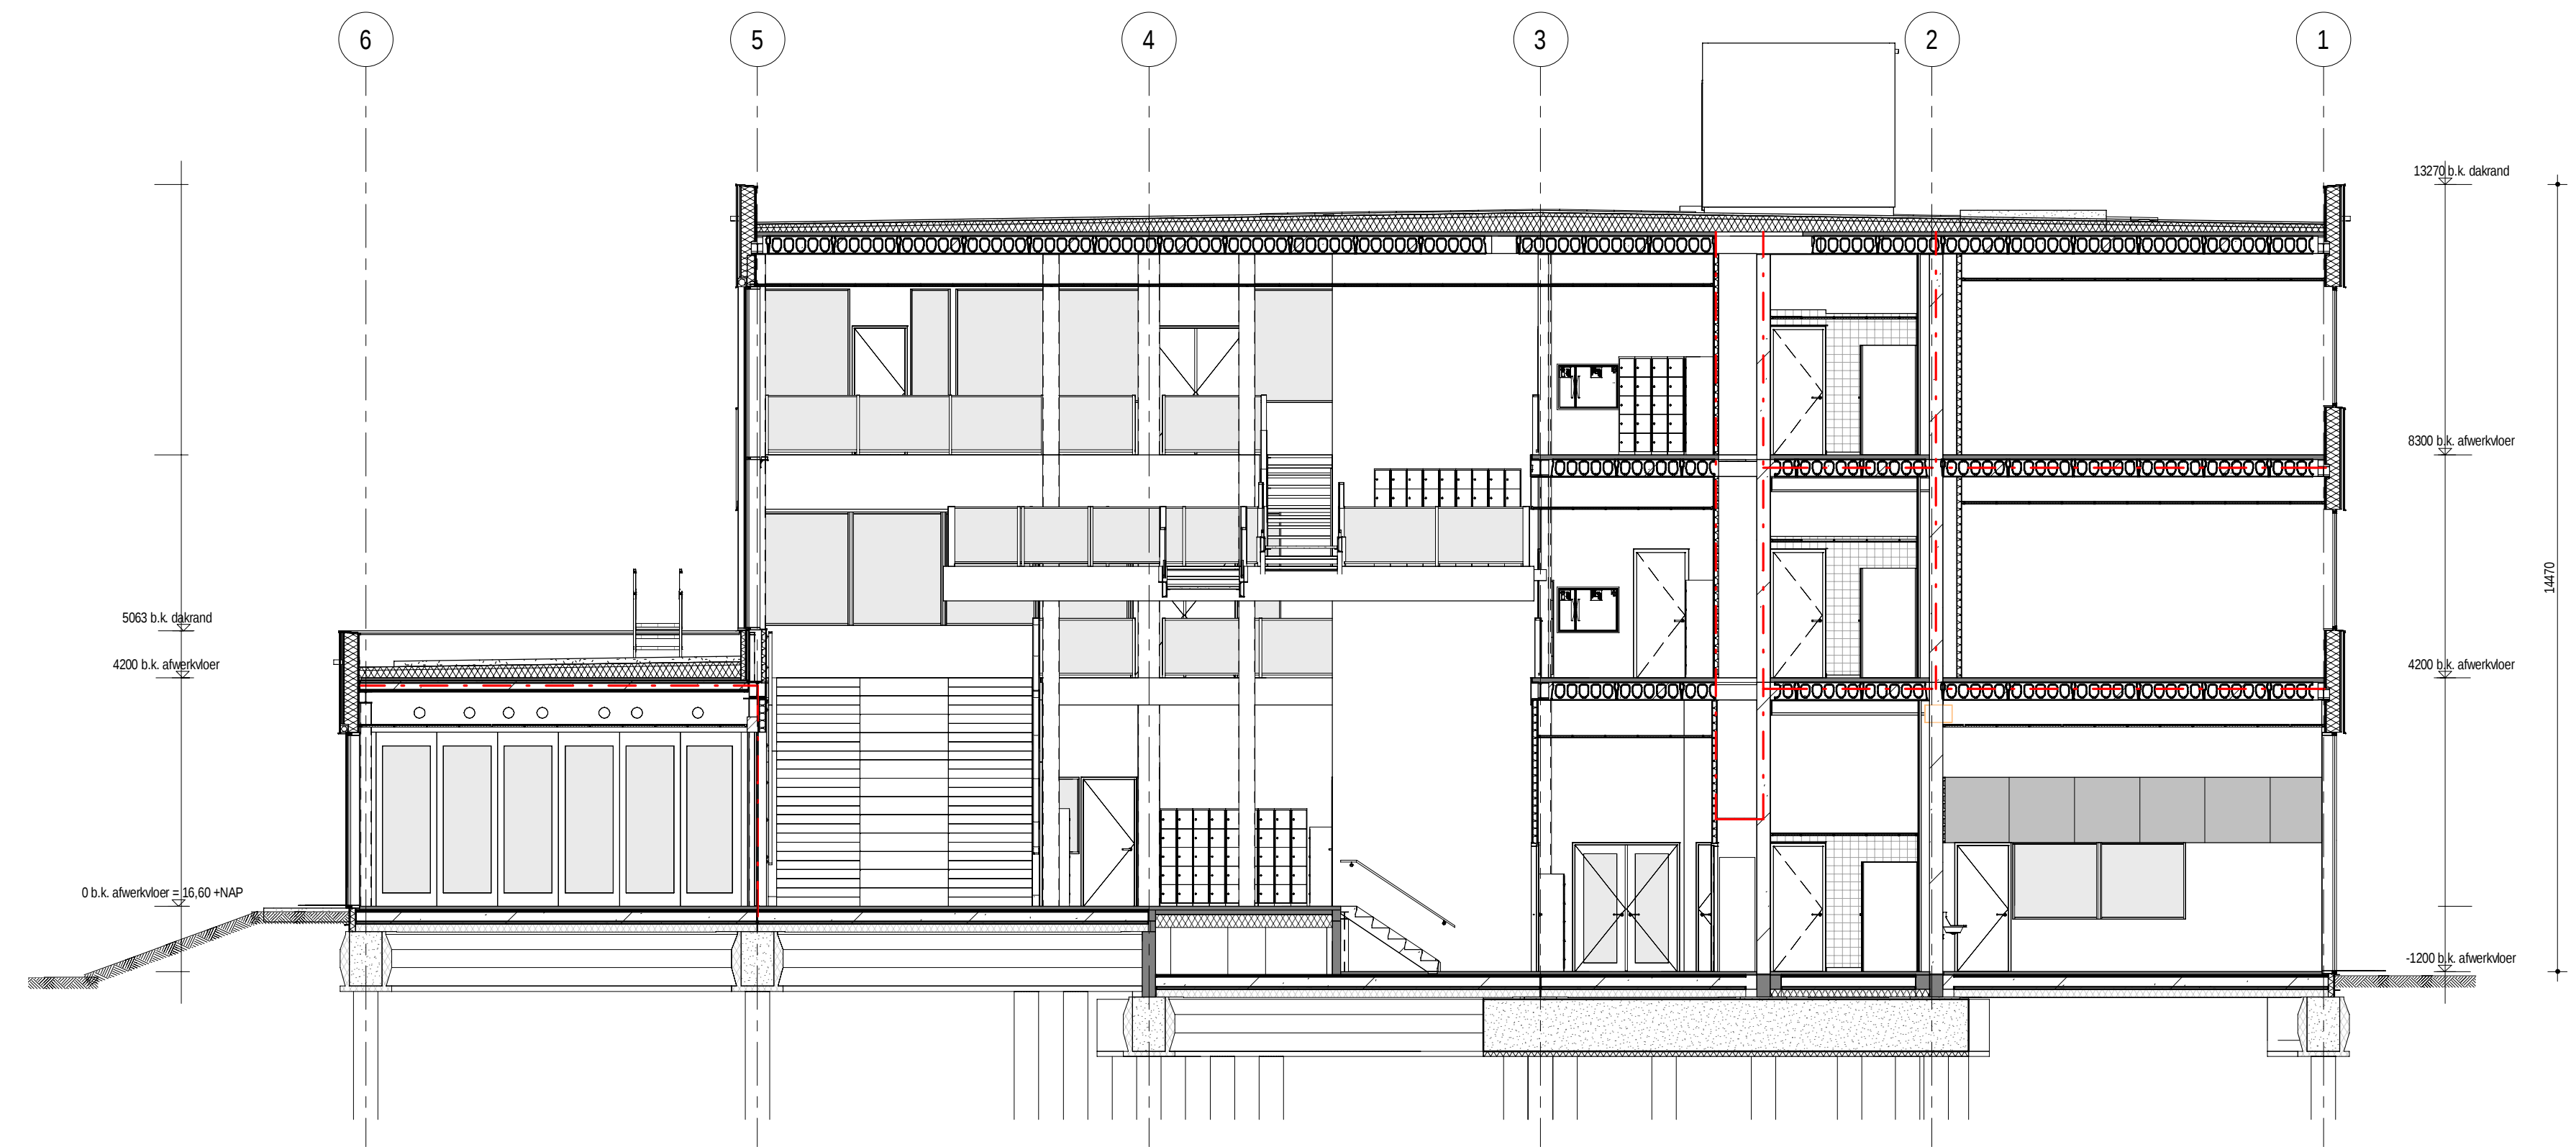


doorsnede B1 - B1

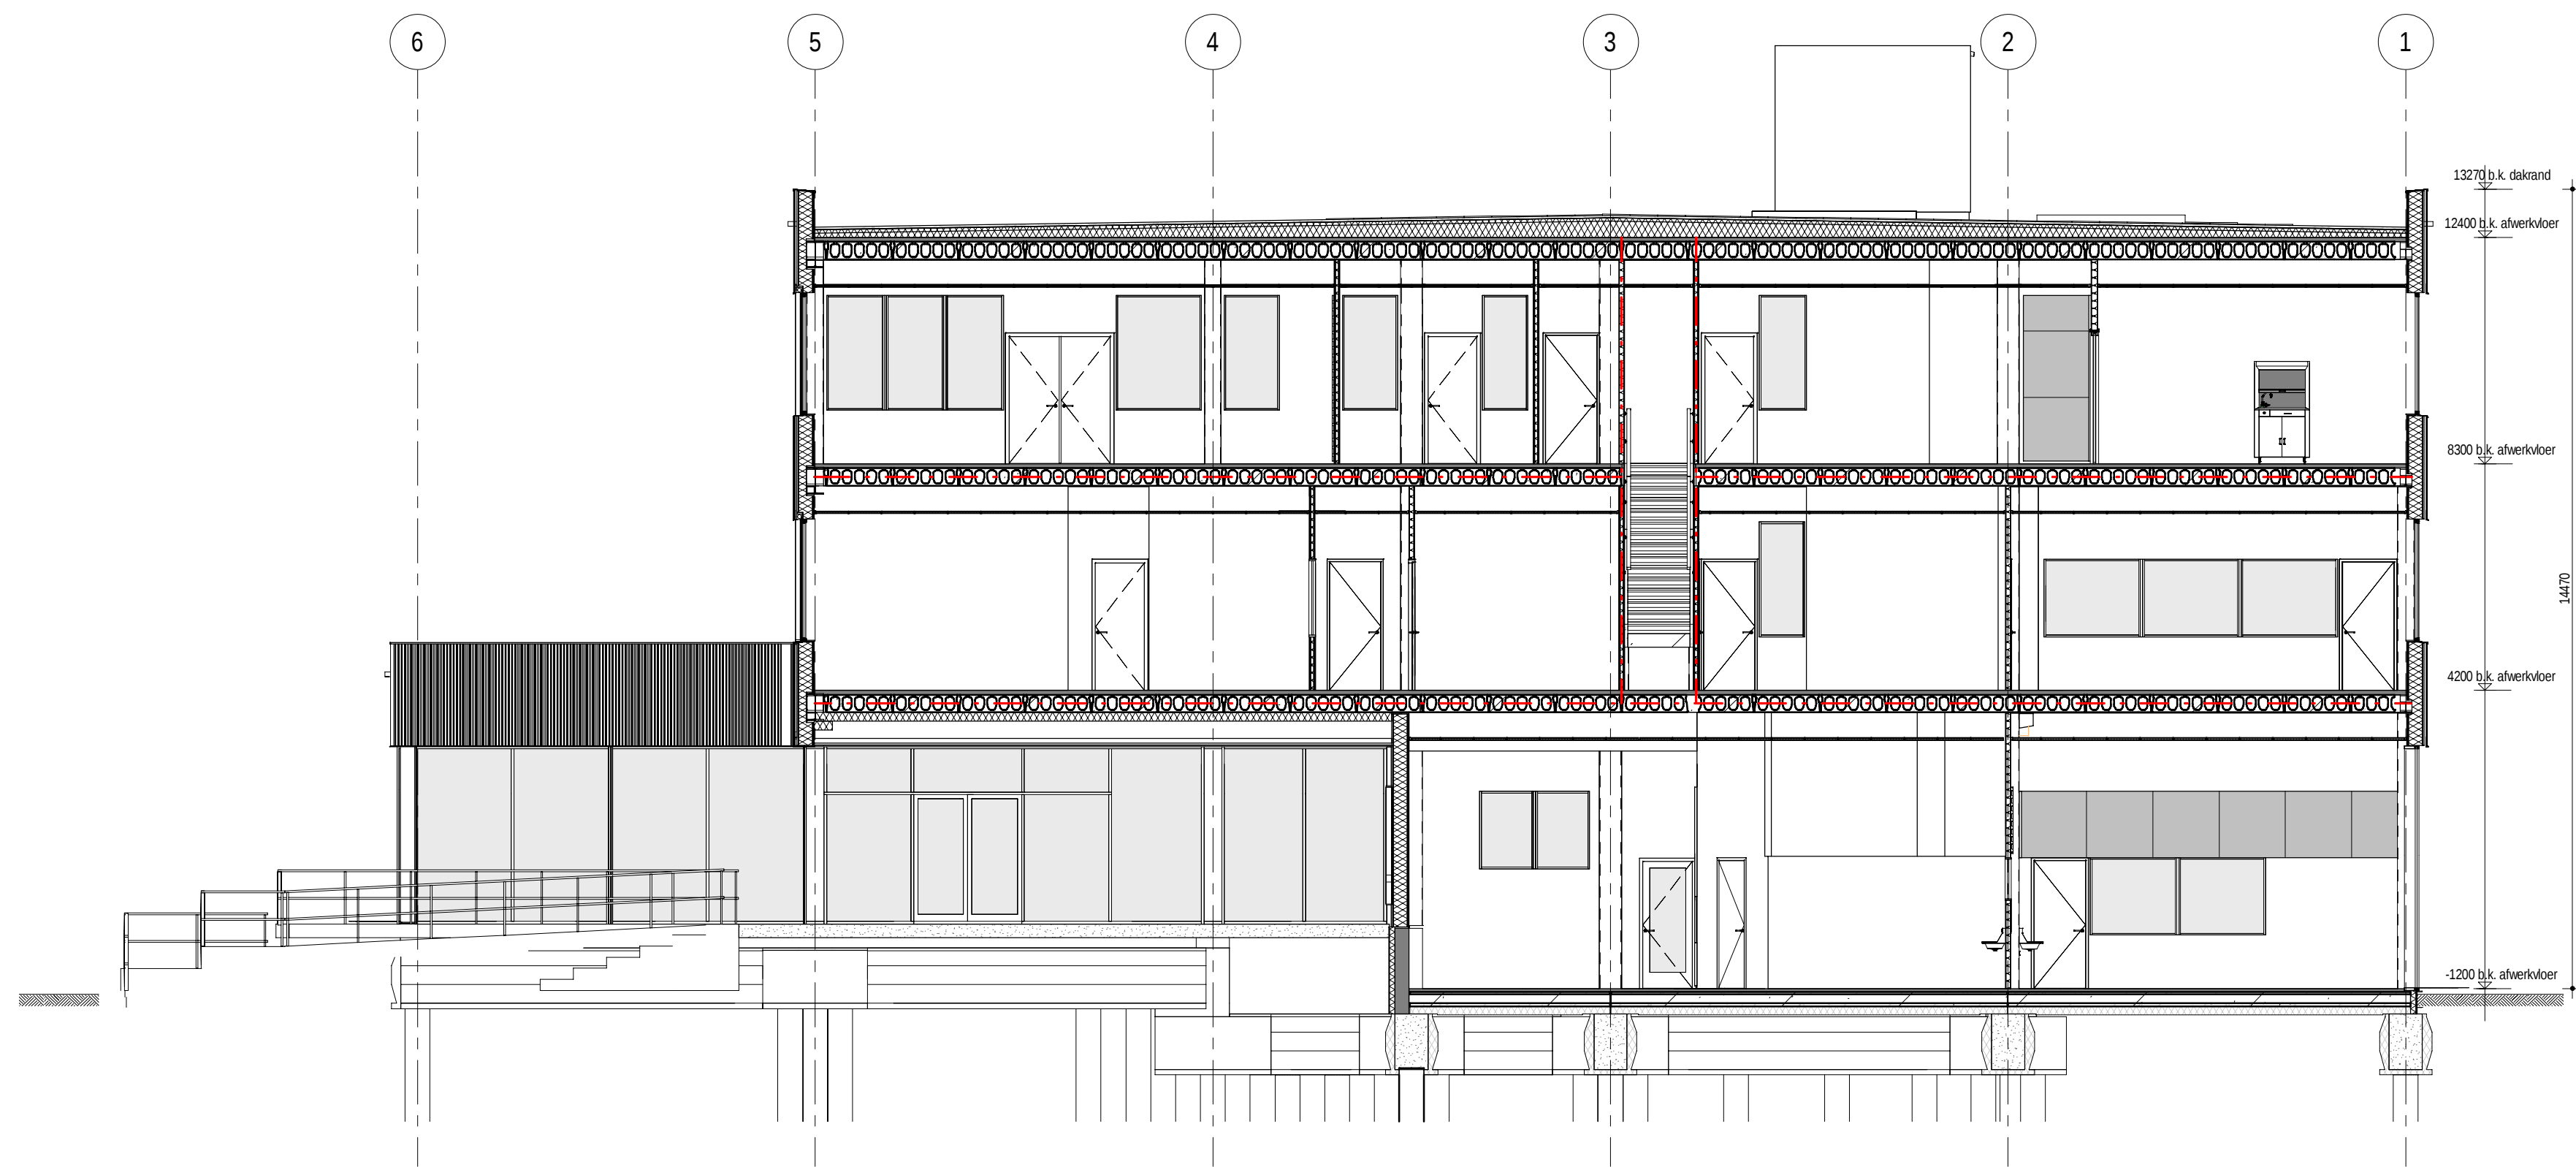

doorsnede B2 - B2

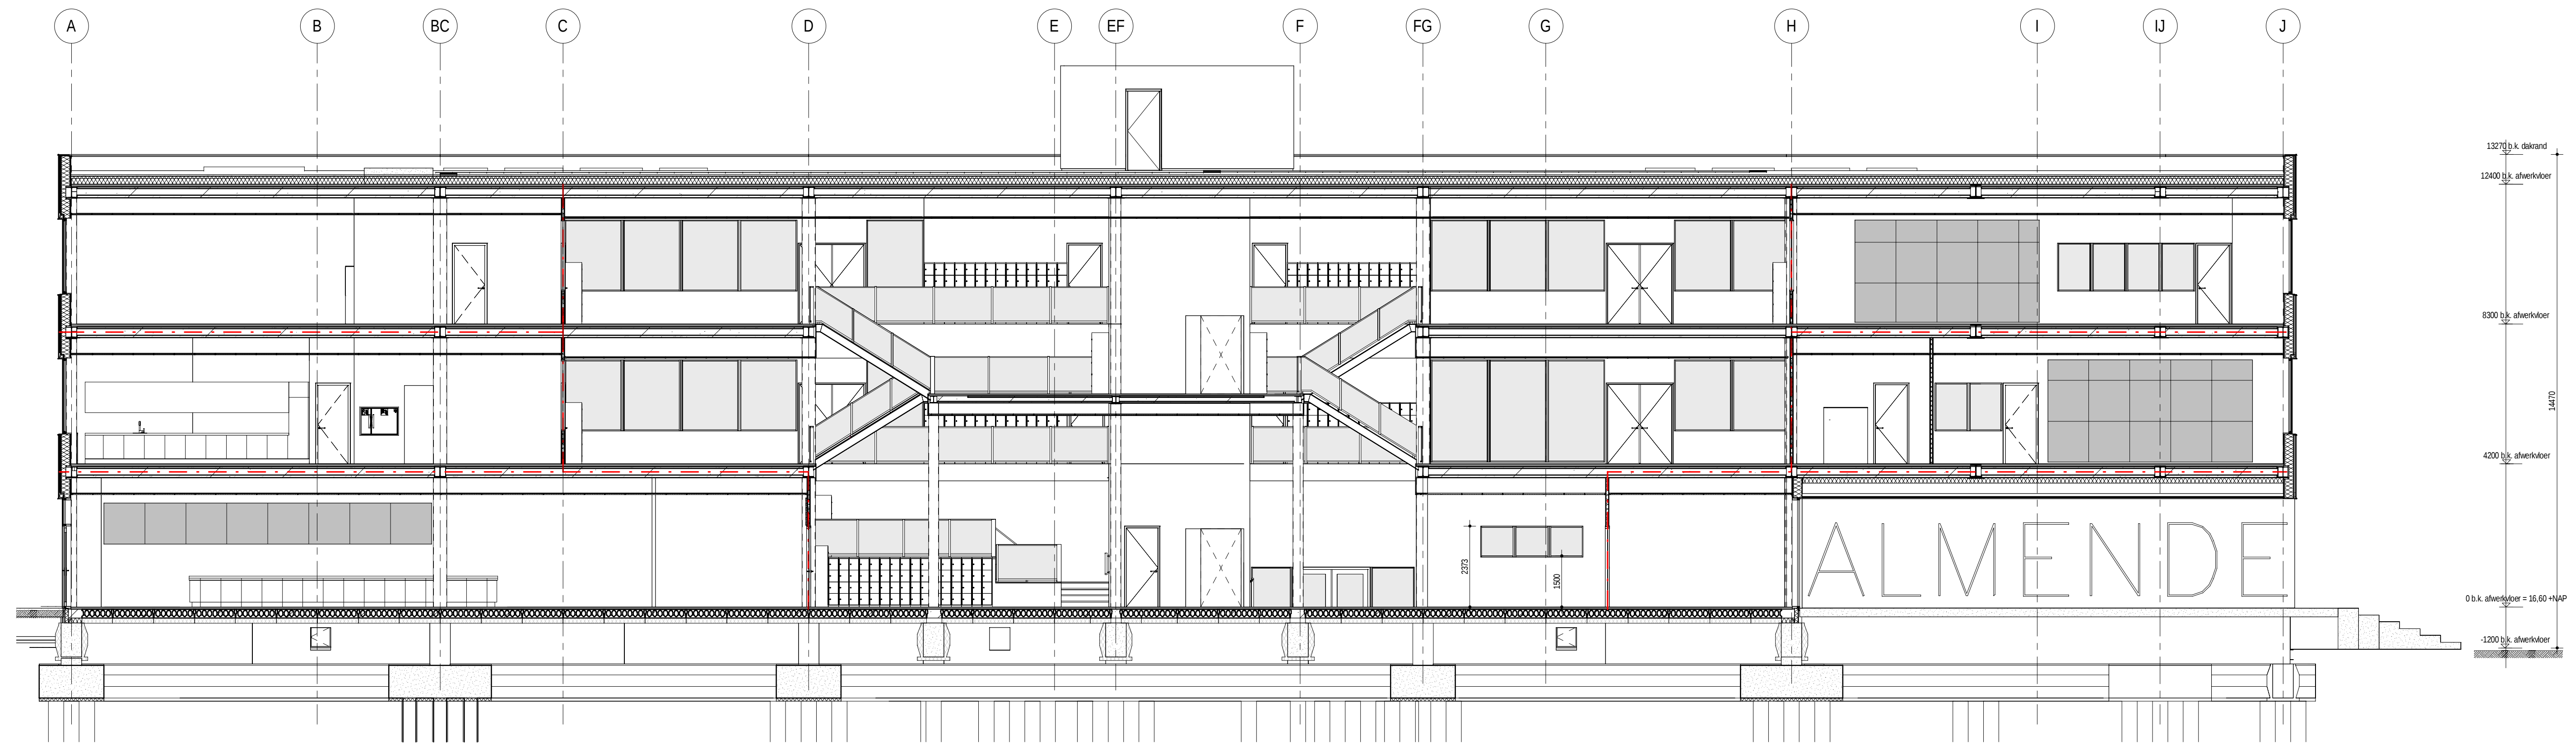

doorsnede A1 - A1

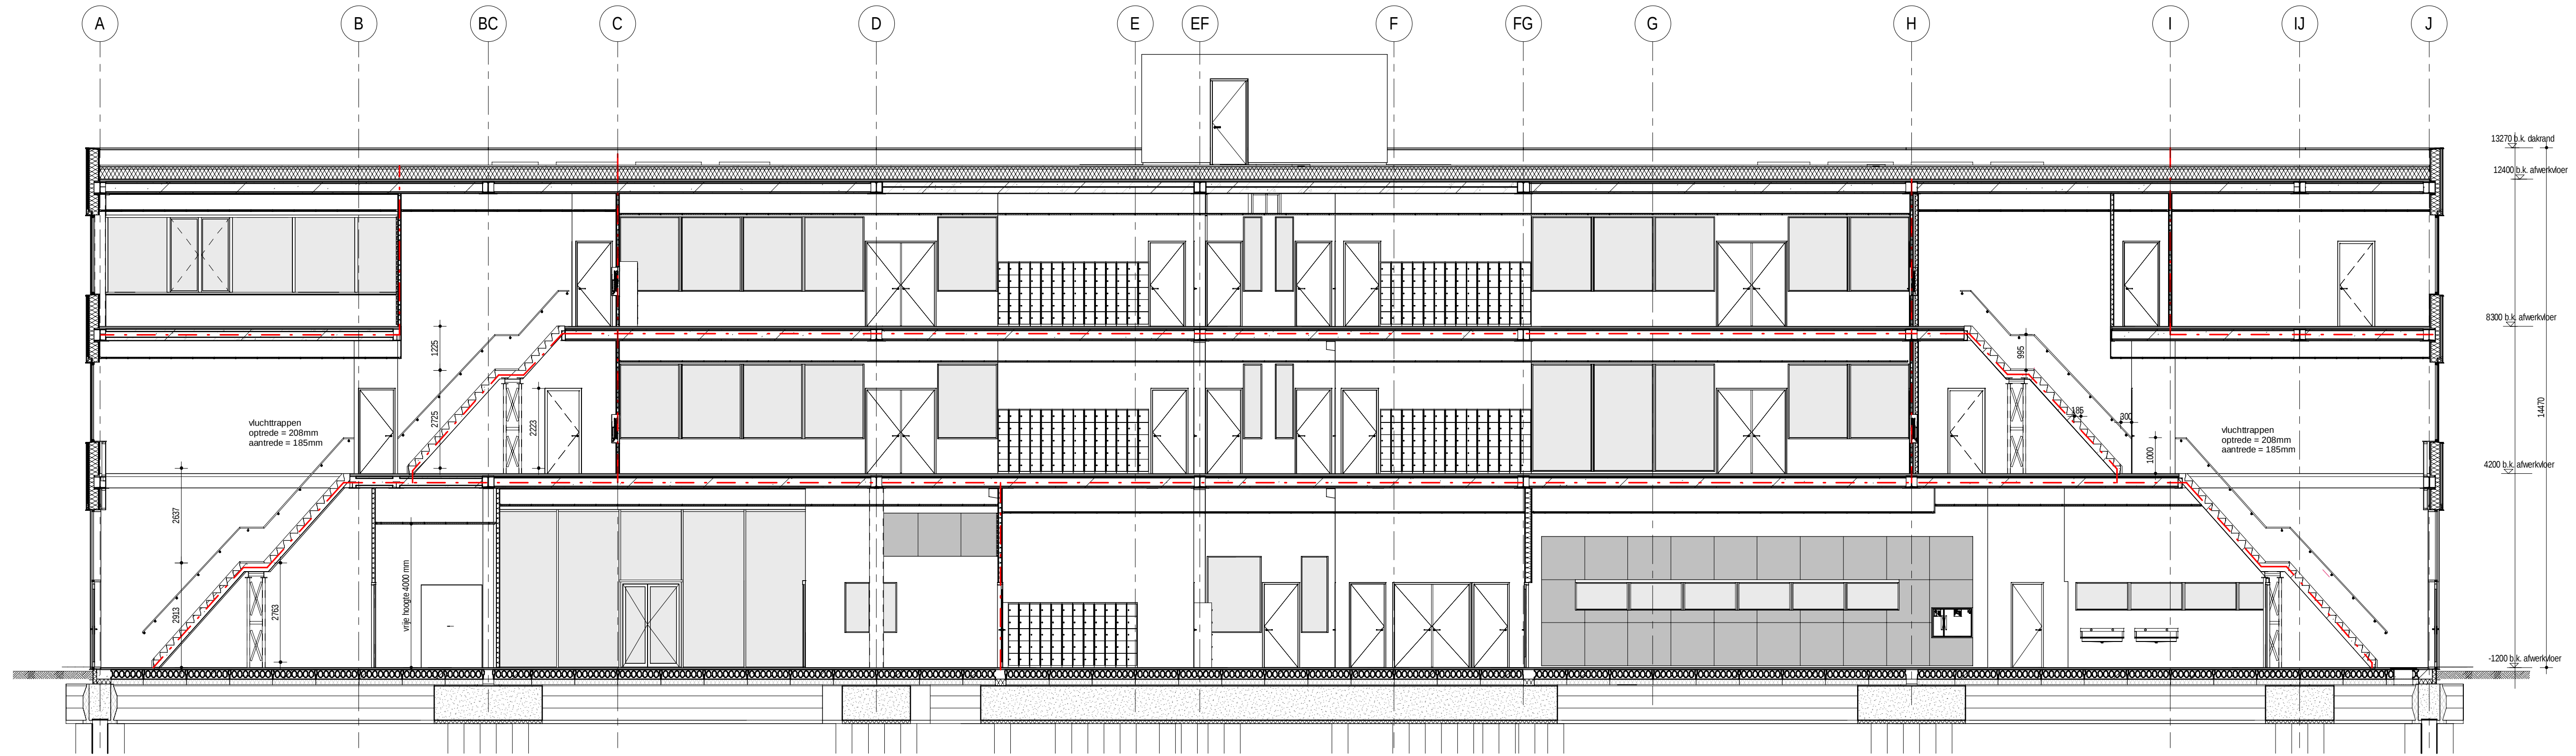

doorsnede A2 - A2