


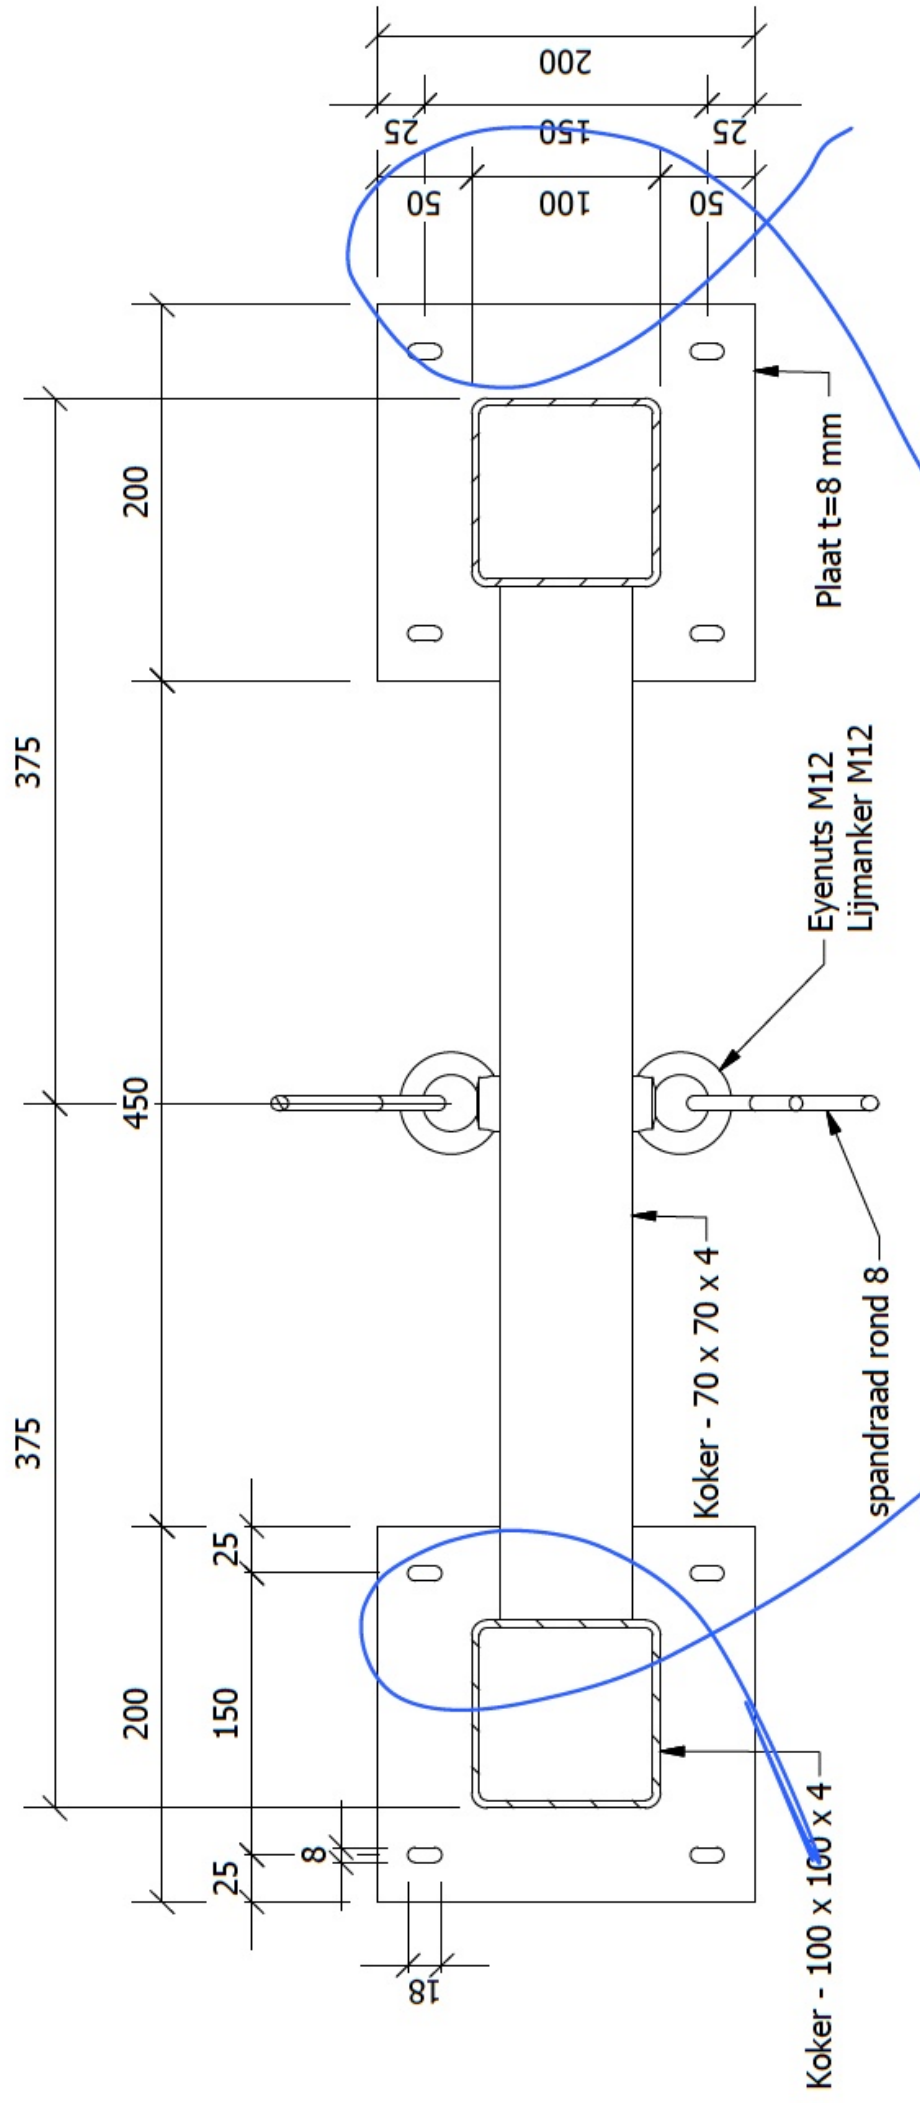

A-A ( 1:5 )