
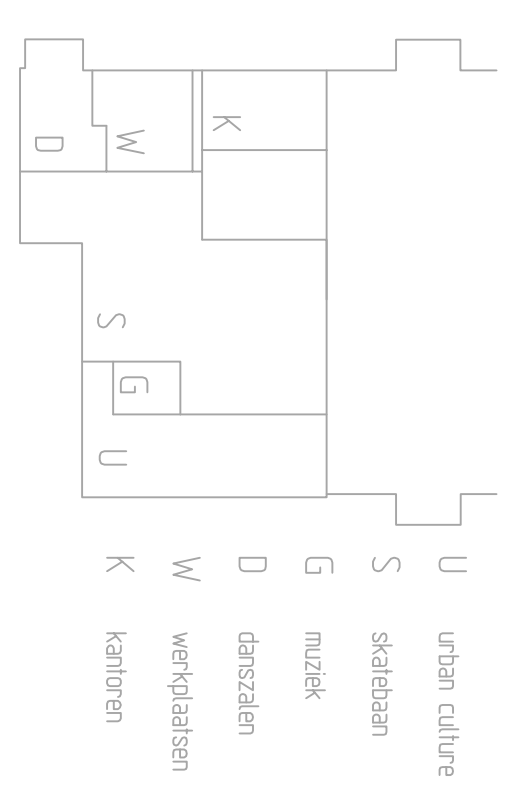


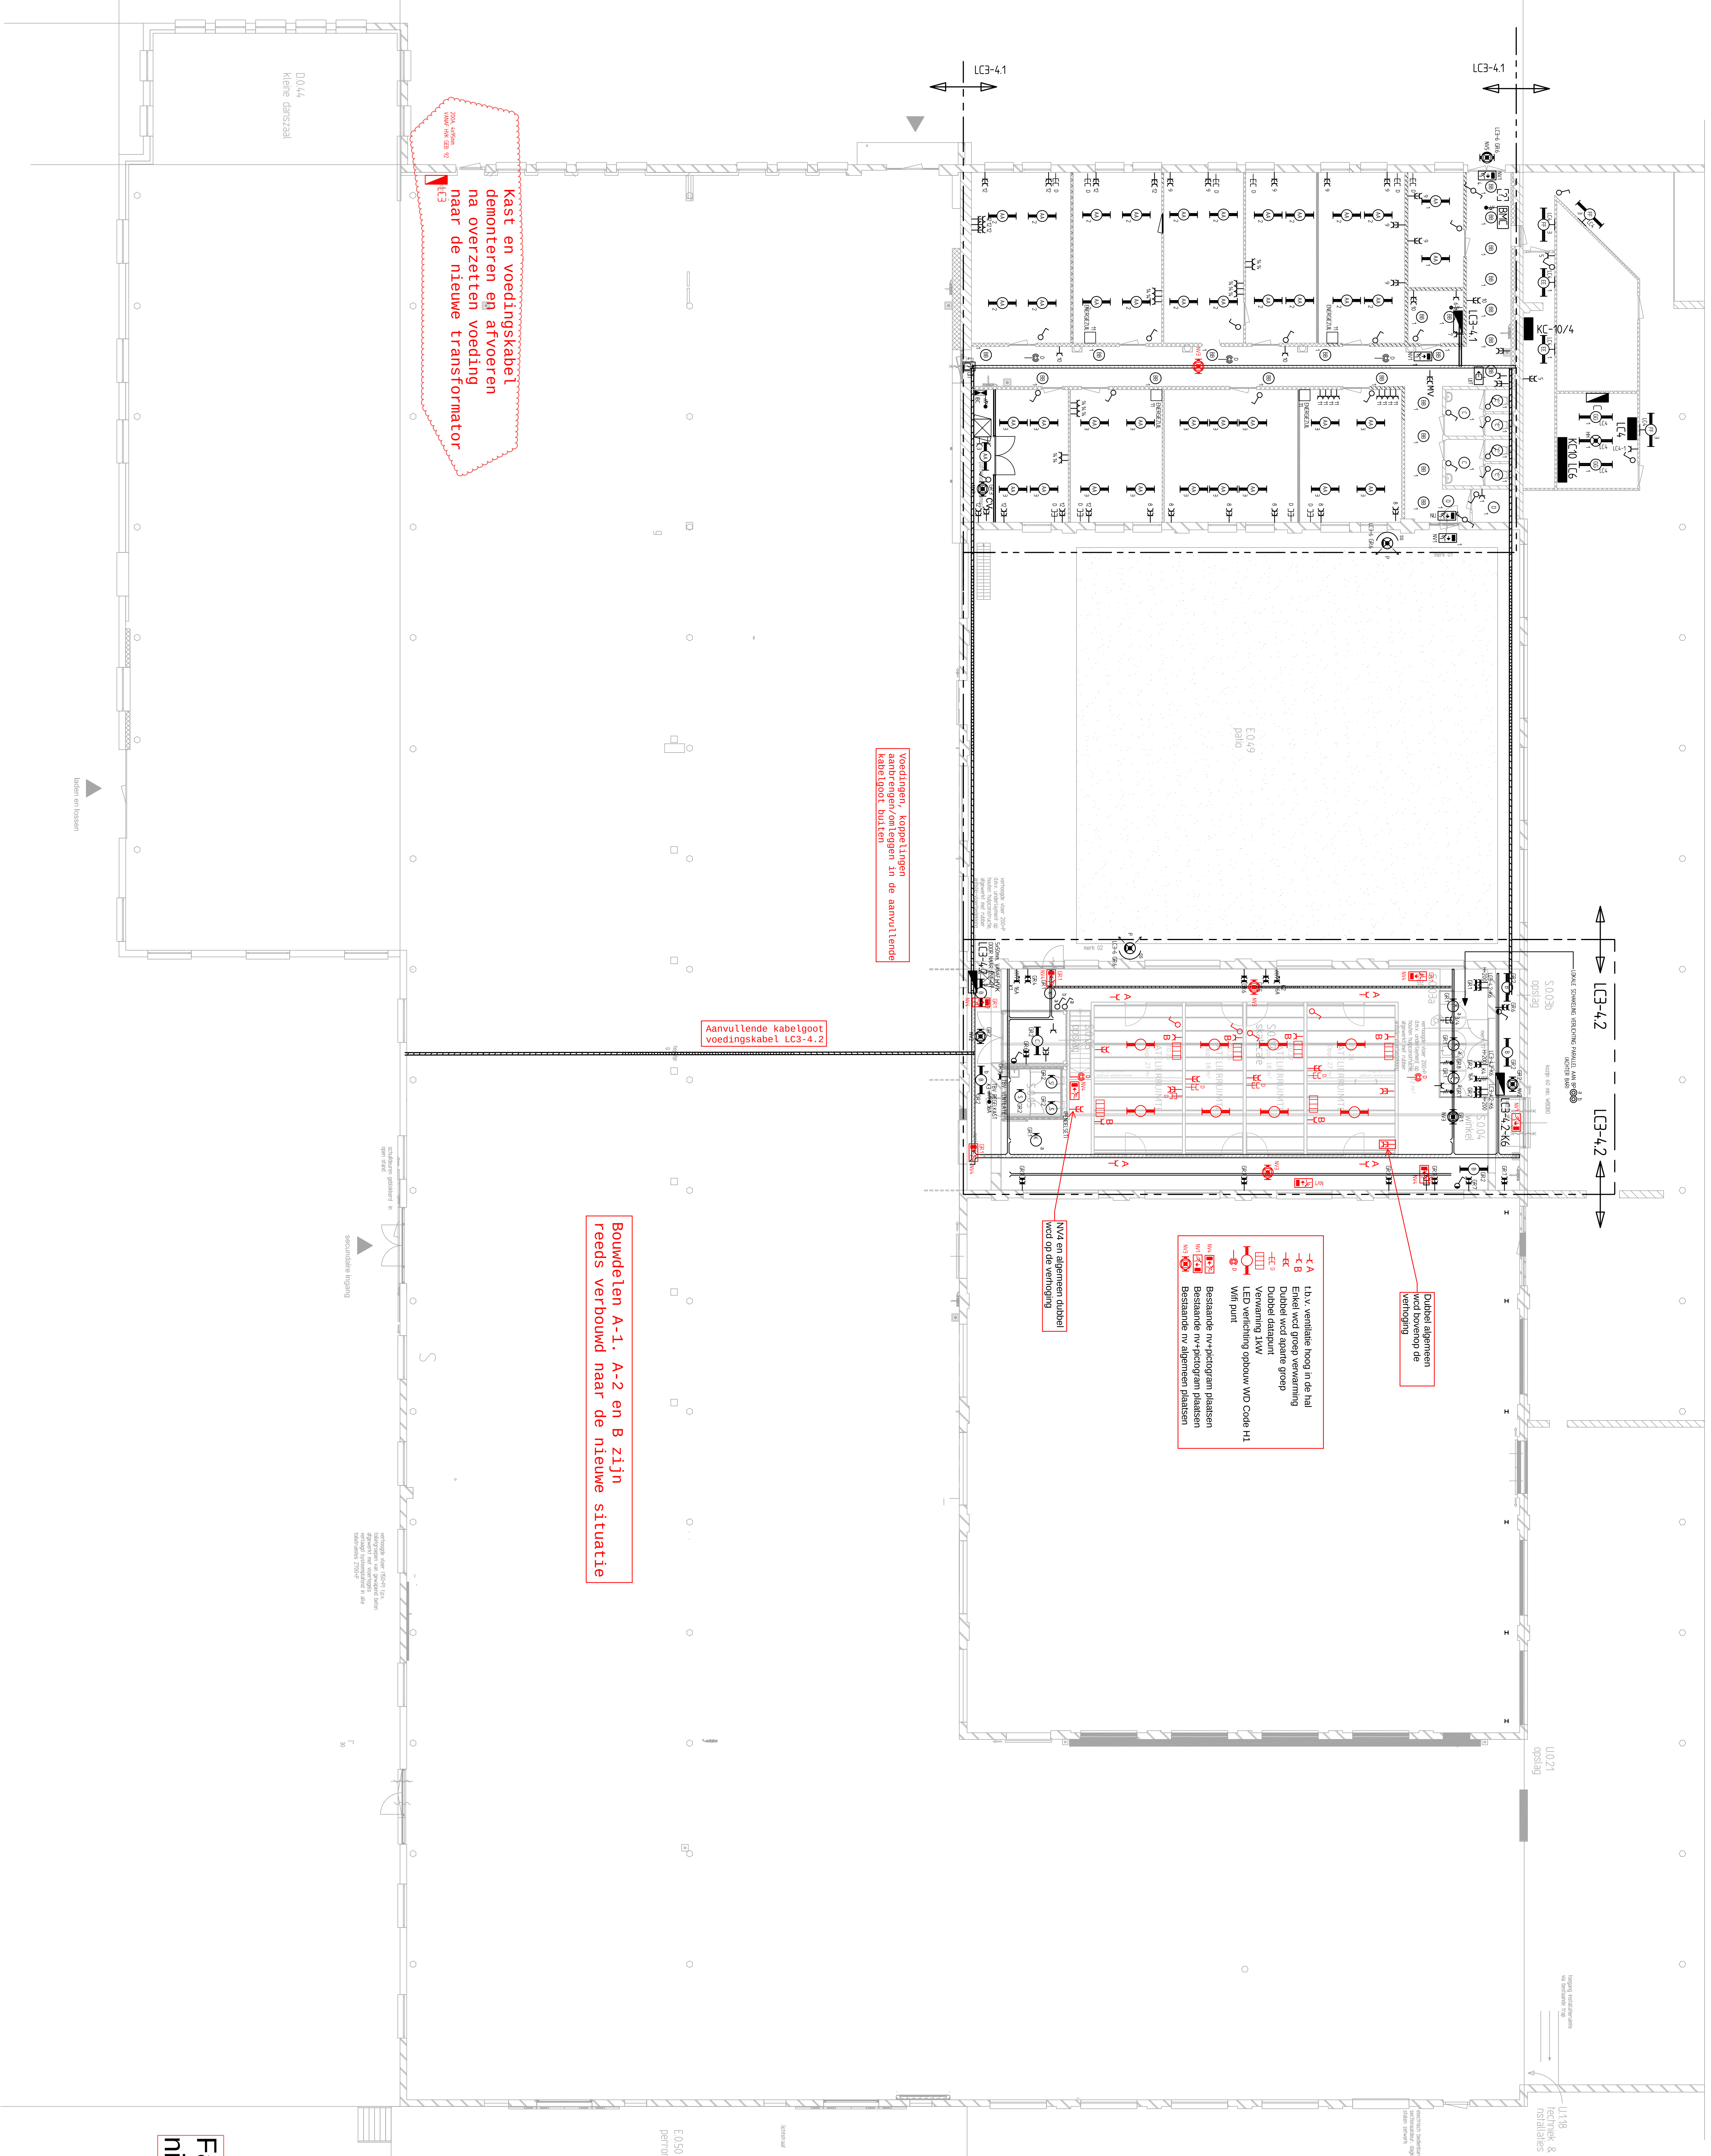

nummer1
SKATEPARK (S)
S.001a skateaan
S.001b skateaan
S.002 klingel
S.003 a
S.003a toeslag
S.004
S.005 rinkel
S.006 oost bij
S.007 skatecife
S.008 tellen
S.009 onafstand

[illegible]



DANS (D)
0044 kleine danszaal
0045 grote danszaal
0046 kleedruimte & douche

BUITEN / EXTREUR (E)
E049 patio
E050 terras

RENEW

