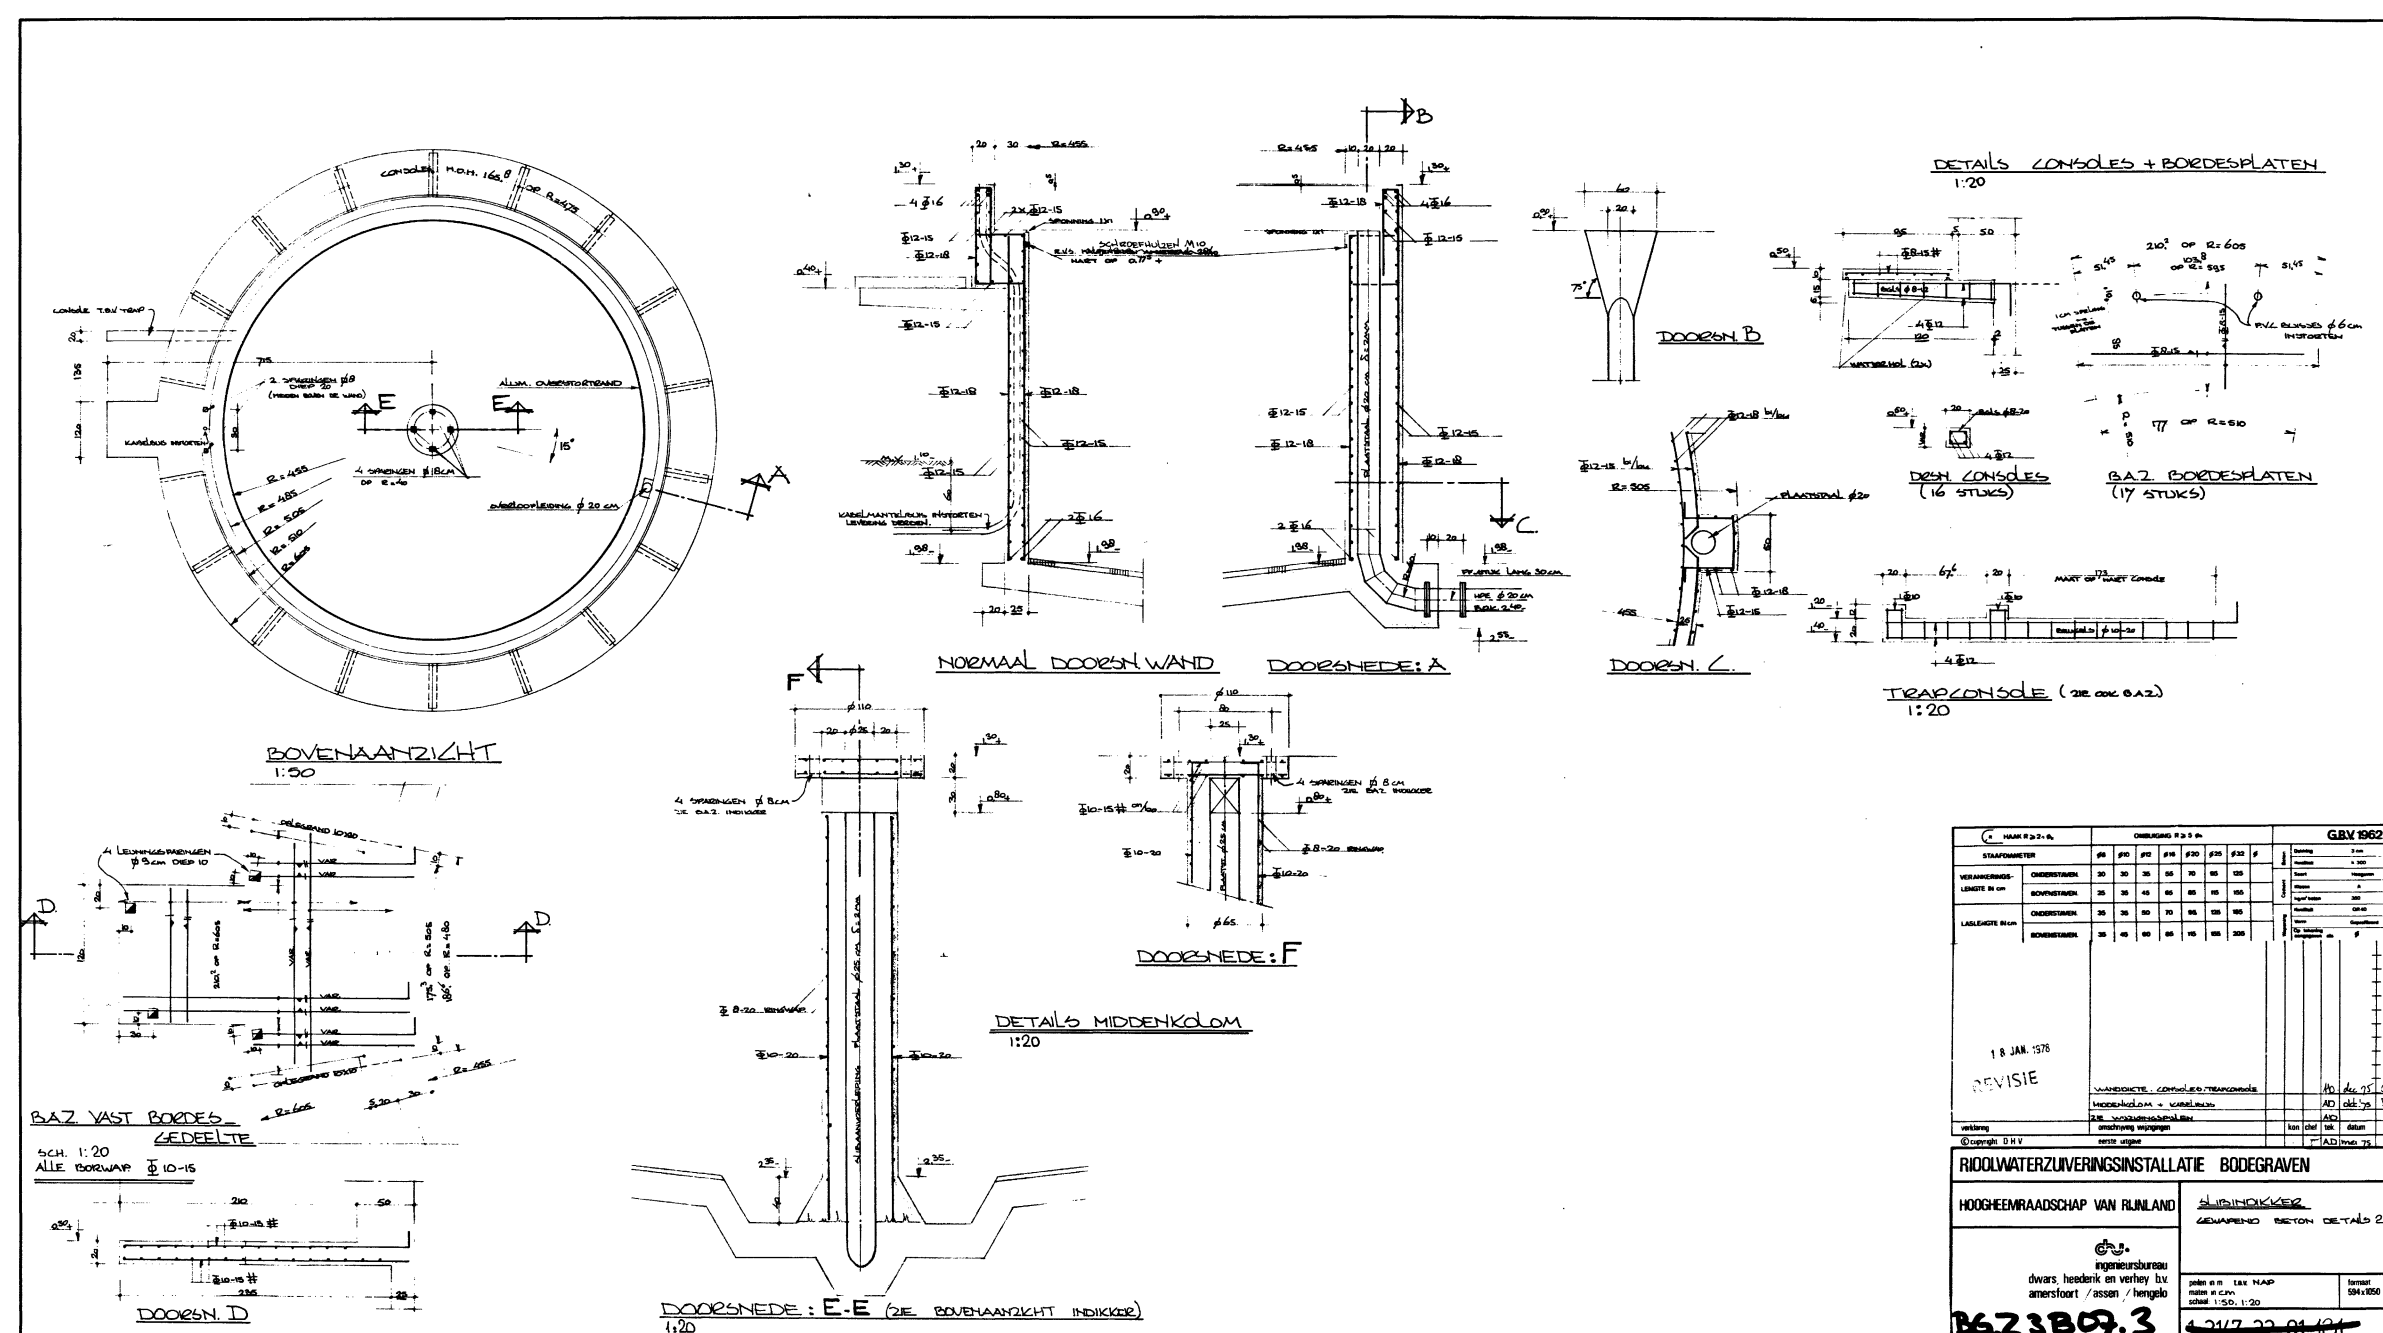


KODAK

KODAK

[illegible]