


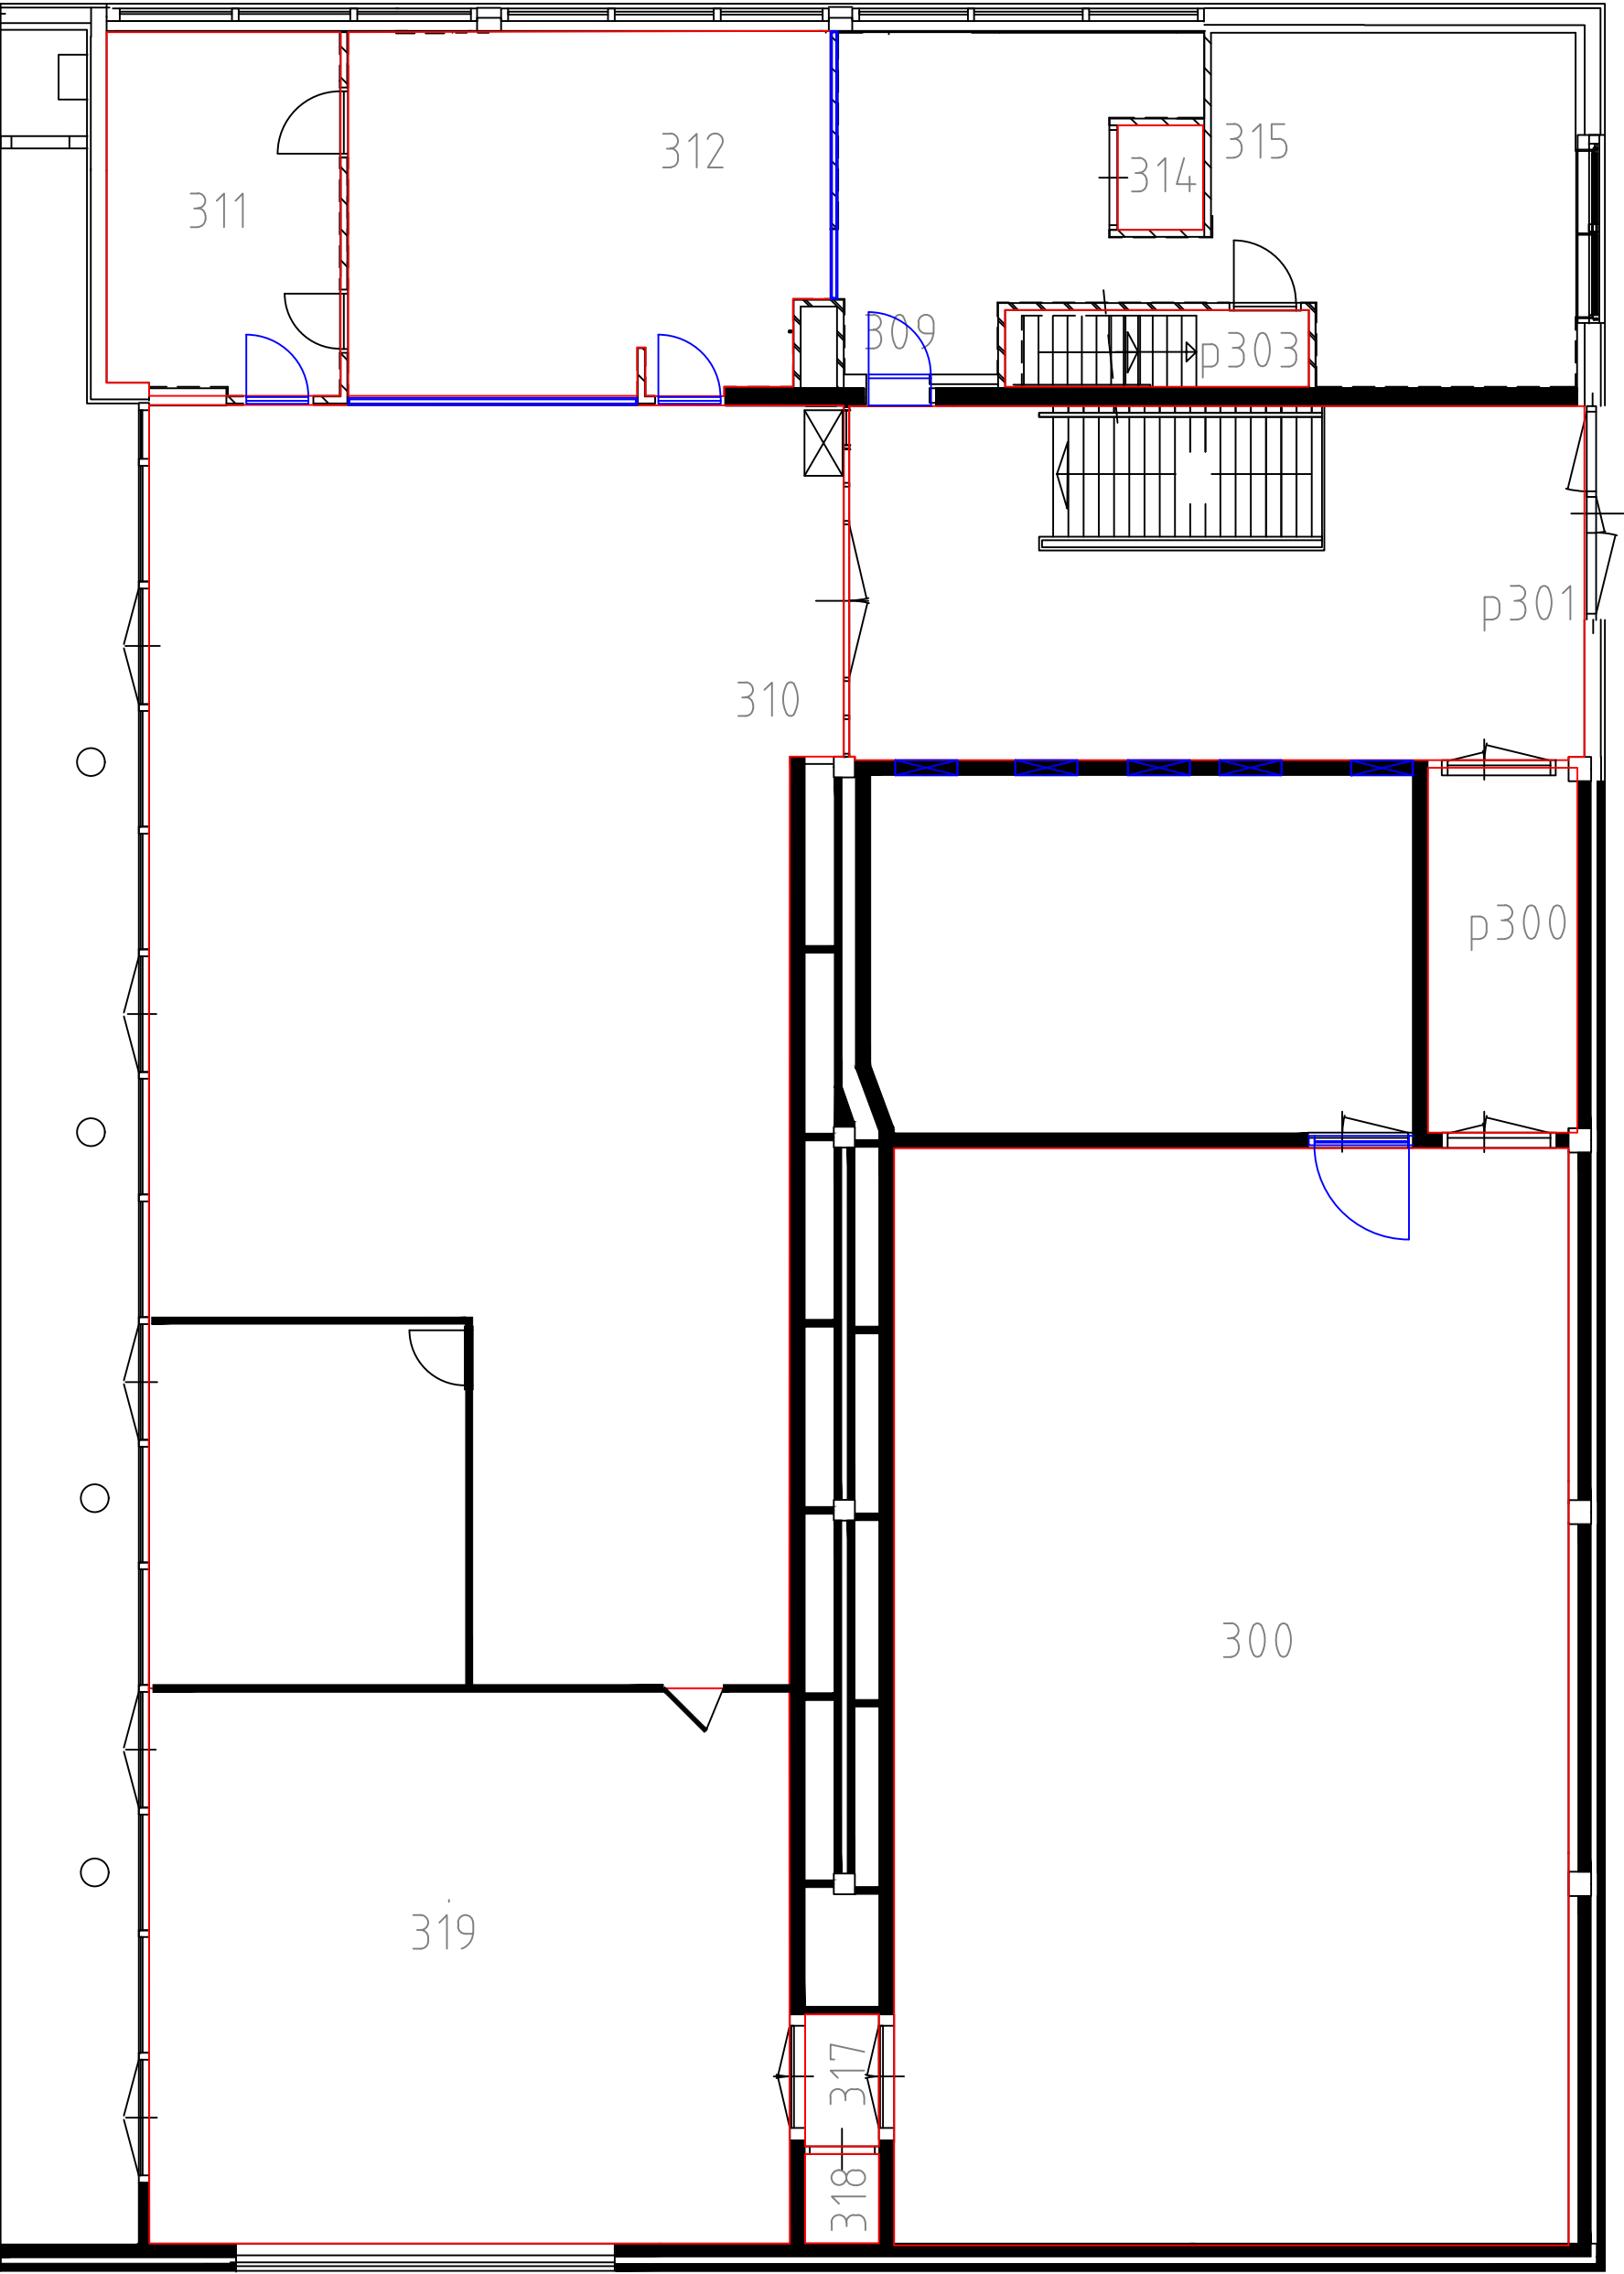

BUILDING 002 LEVEL 3