



A dam Zyde

→ . = must / niet. Los. anker.

ZIJAANZICHT

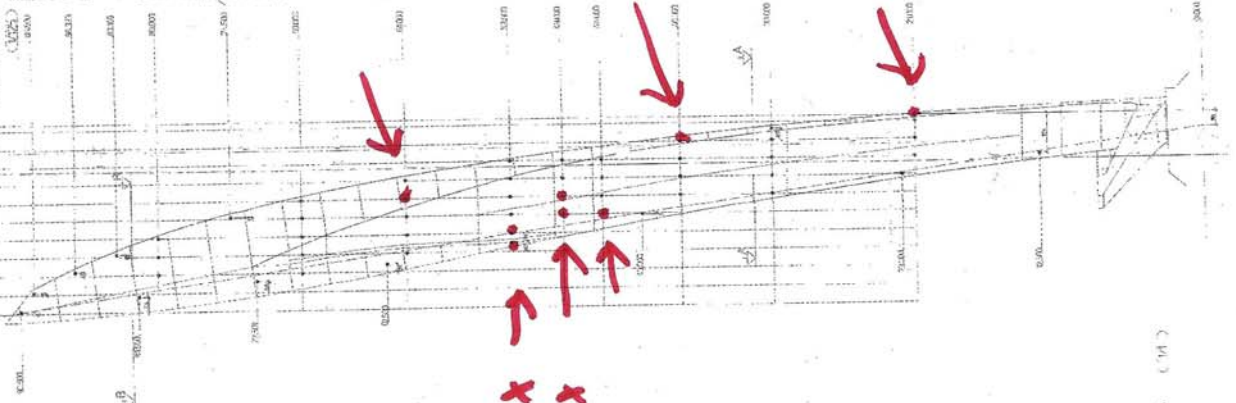


SNEDE B-B

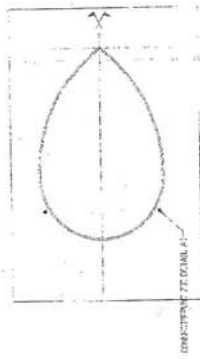

SNEDE A-A



DETAIL A

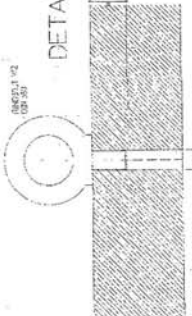

KNIKLIJN
LASNAAD IN VLAK, GESLEPEN
RAAKLIJN



A 12. Zyde.

→ = mist / niet los anker.

ZIJAANZICHT

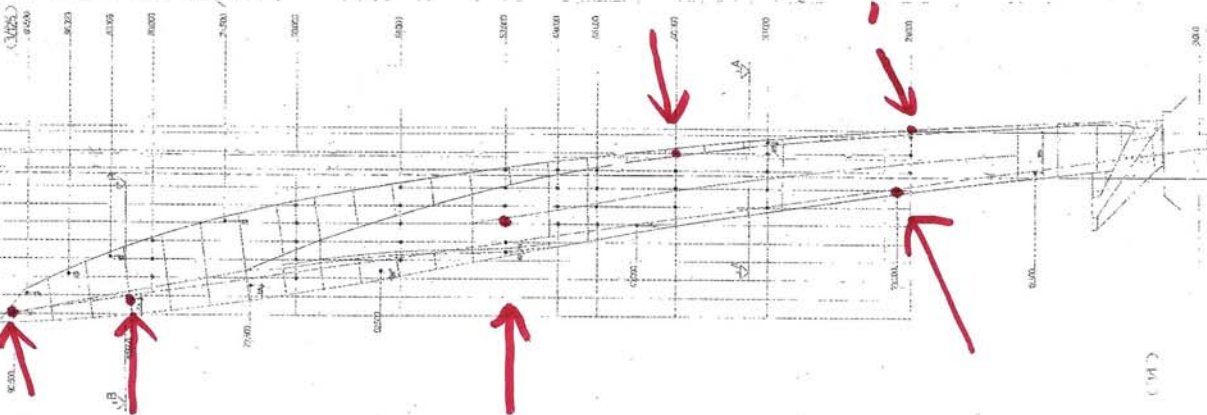

Gewenste
Jogen op
Ryloan

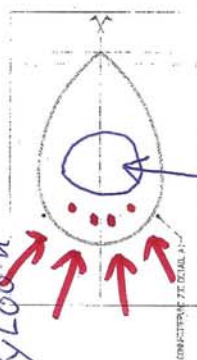

Man sat.

SNEDE A-A



DETAIL A




