


REV	DESCRIPTION	DRAWN	CHECKED	DATE
a				
b				
c				
d				
e				

# V-2-1 PROFILE DRAWING

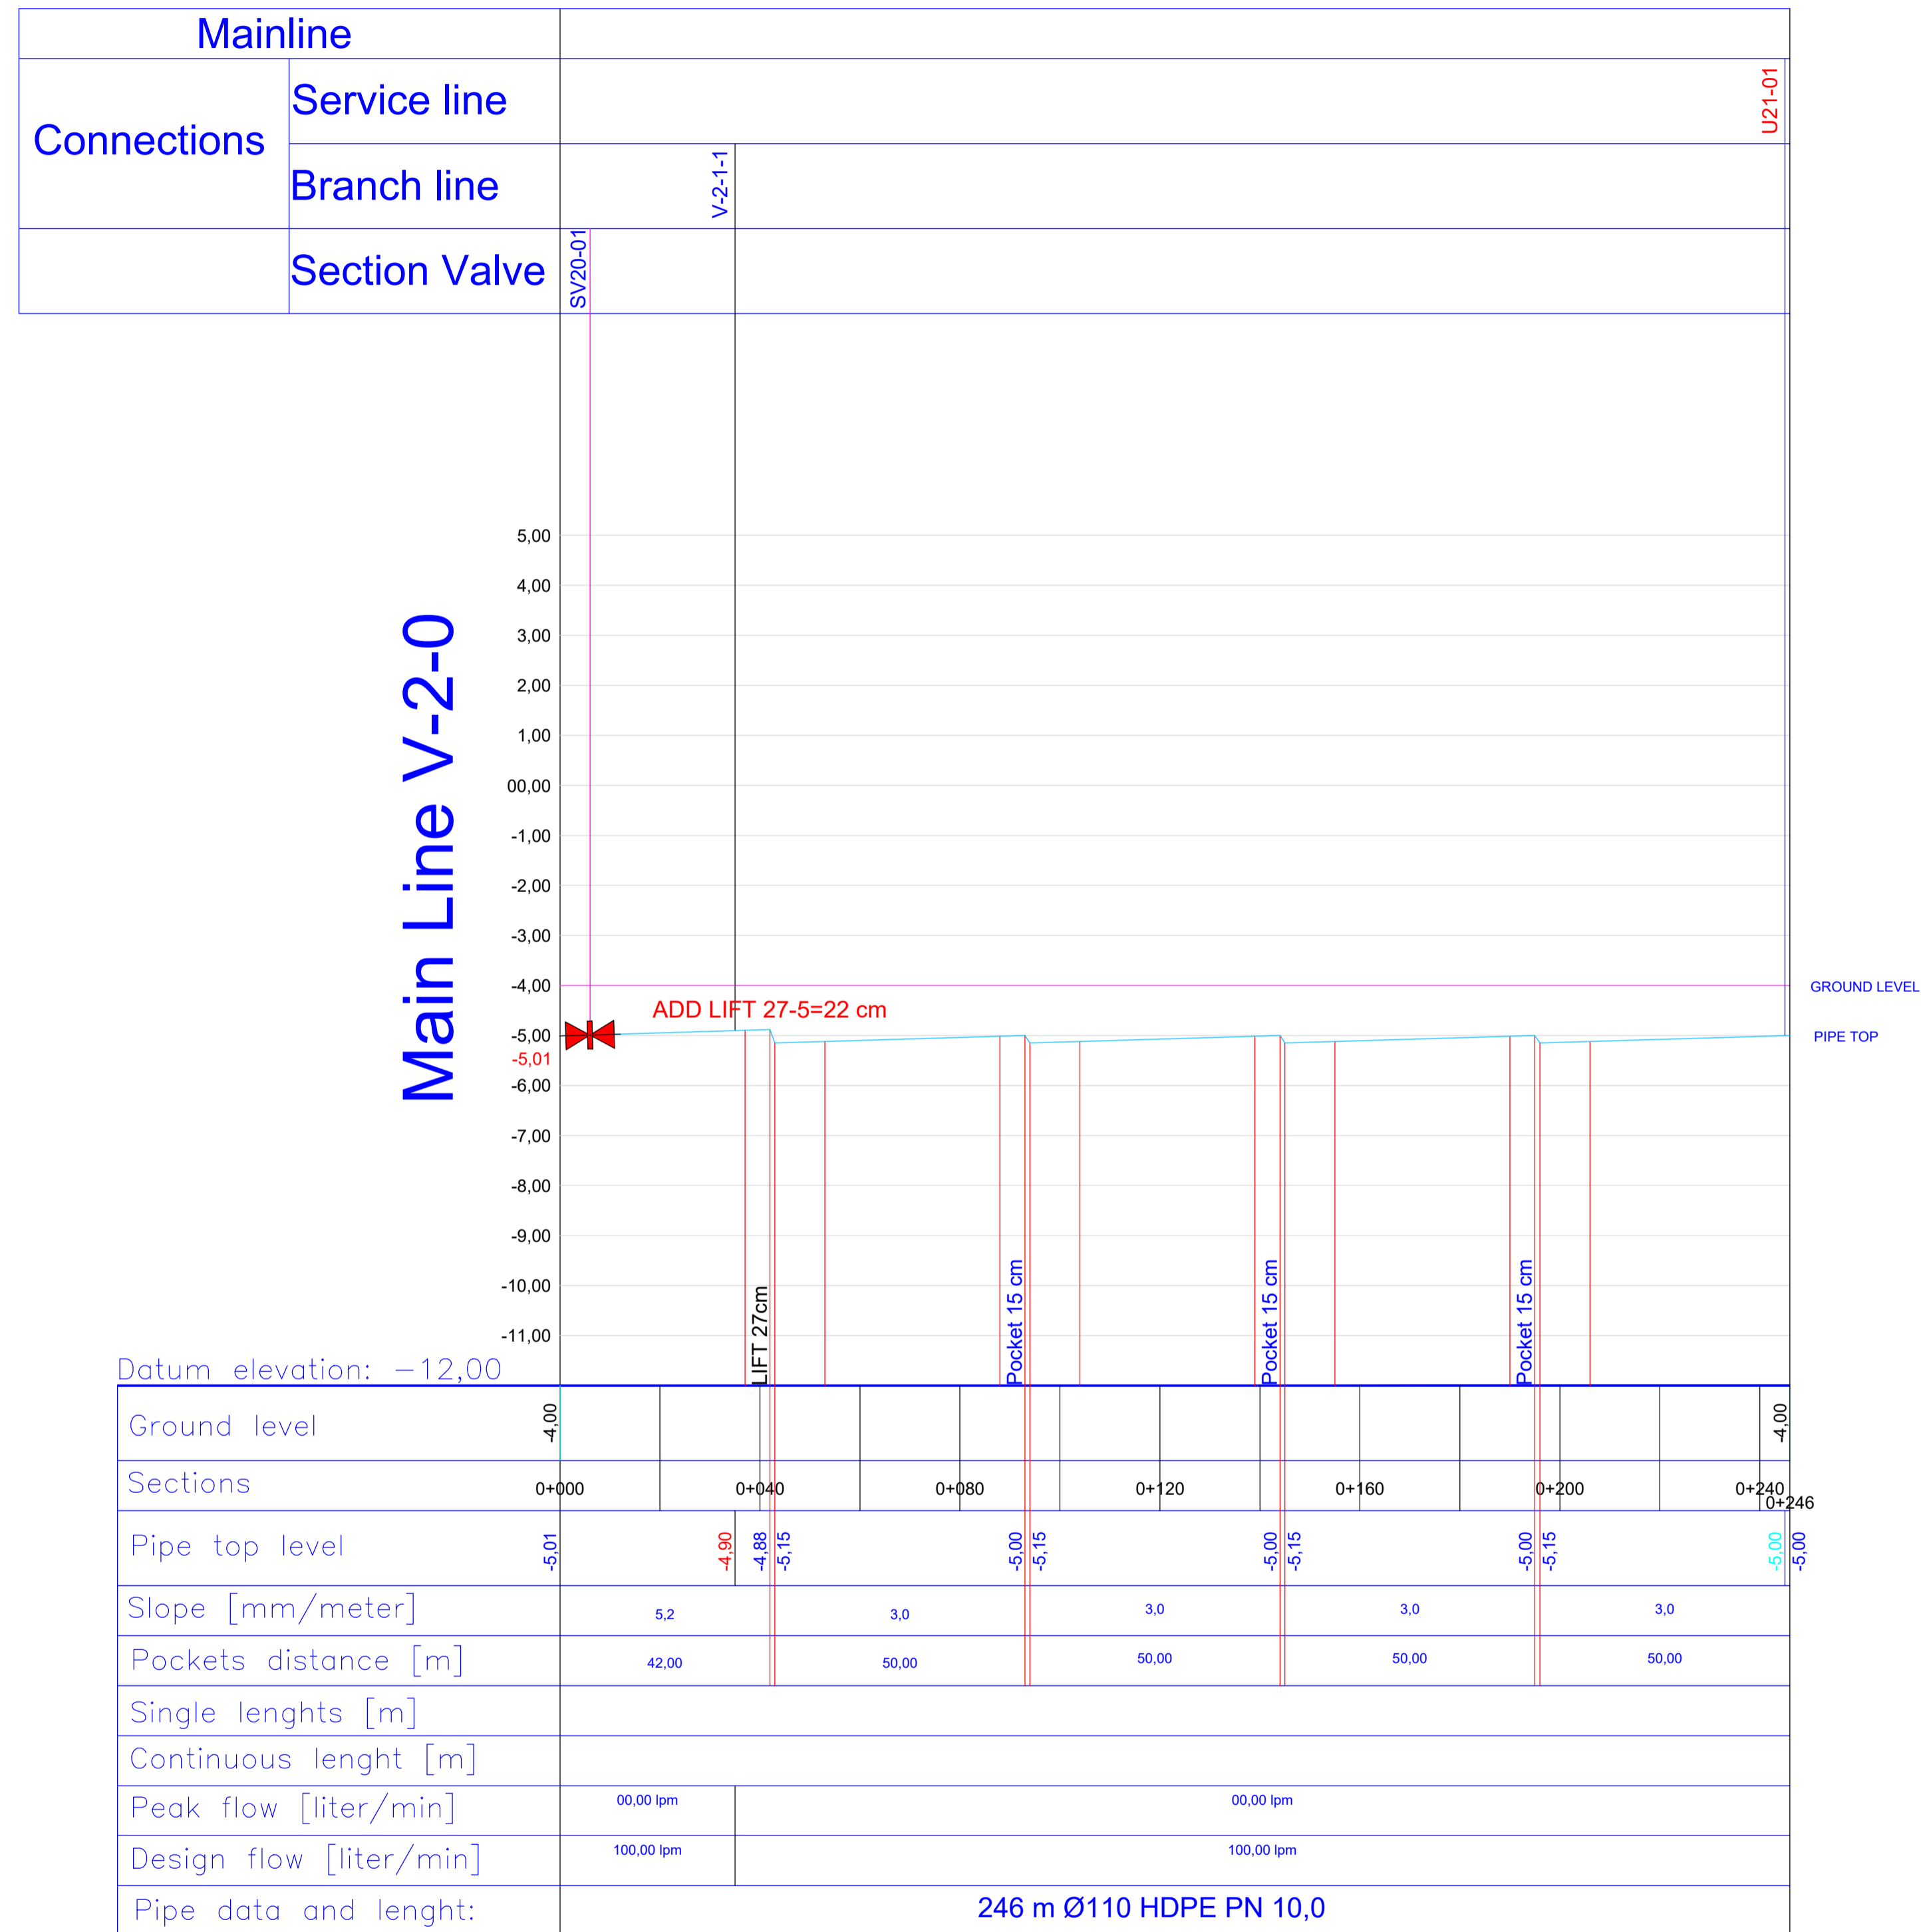

Pos. No	Quantity	Drawing No.	Description	Material	Dimensions or Remarks
			Project: Business Park Lelystad - Omala NV		Scale :
			Drawing: PROFILE DRAWING V-2-1		Drawn: G.Kamal Date: 30/09/2019
					Seen : Ashok Date: 30/09/2019
Grew.: QUA-VAC B.V. ALMERE (NL) - VACUUM SYSTEMS					Proj. No.: LD19089 ISO A0
					Drawing No.: PRO19089-210 Rev: 0