





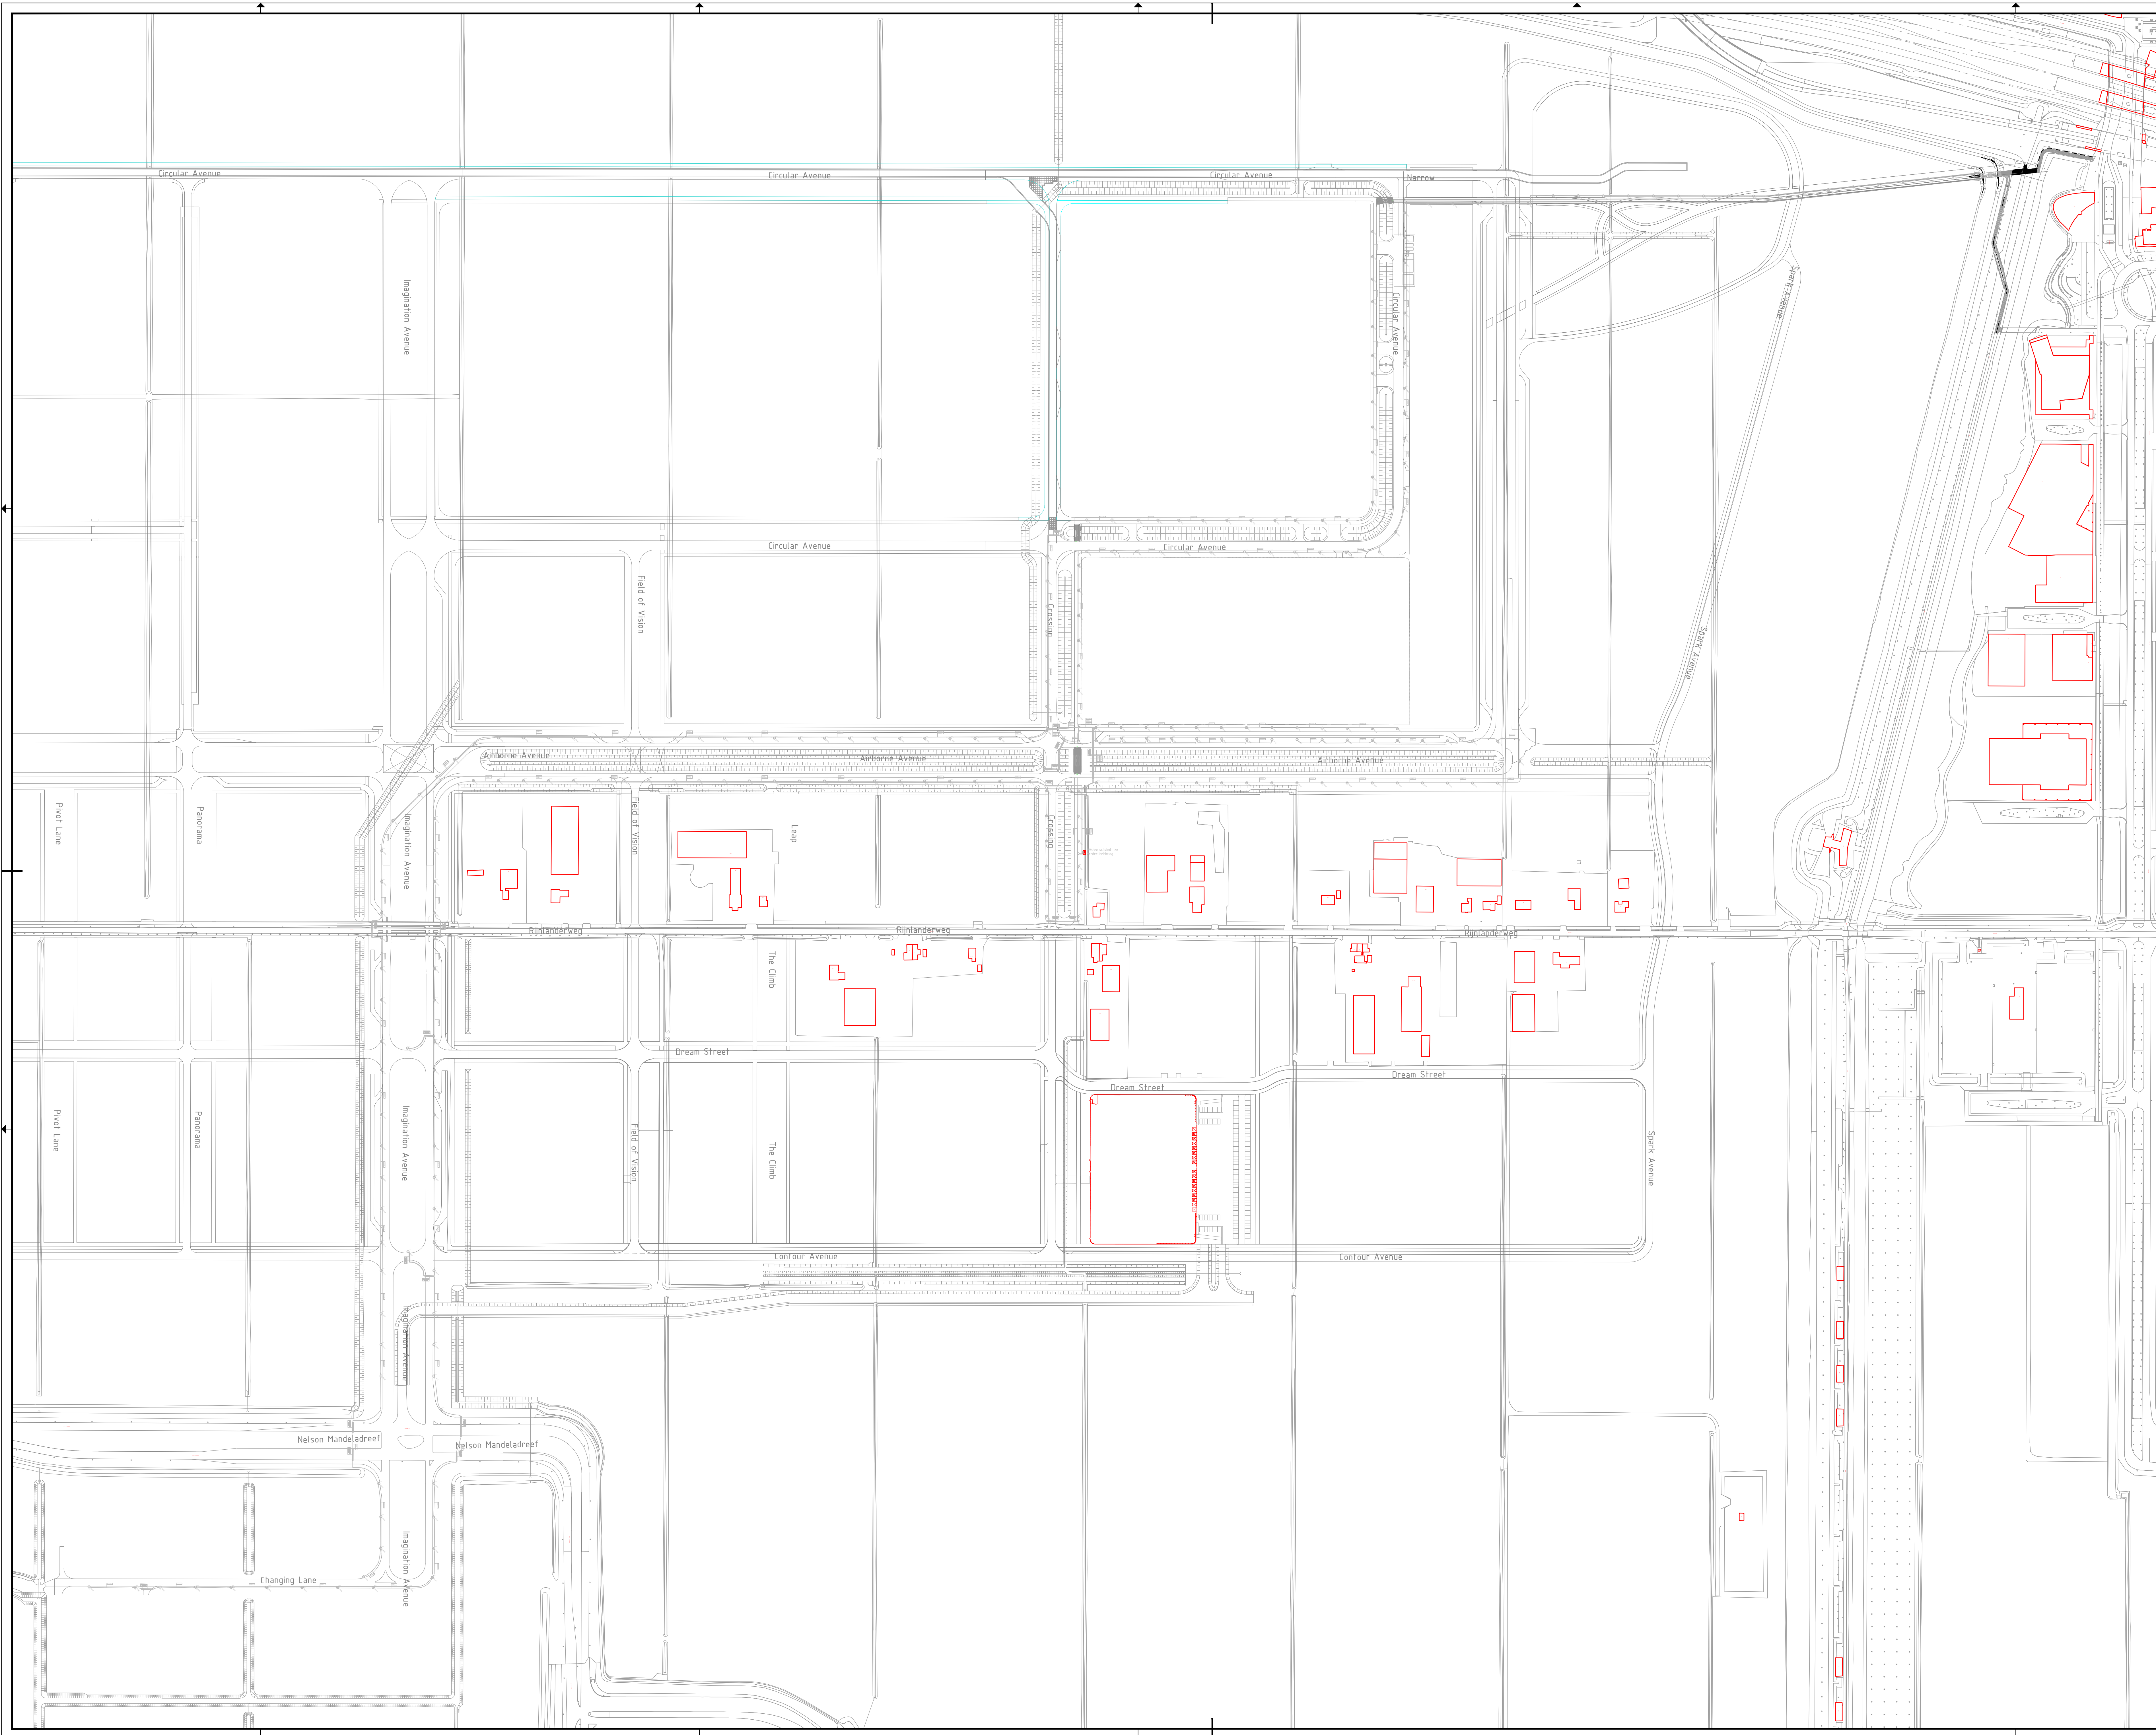

OV-Kast

— Hoofdkabel 4x4

Lichtobject/nummer/fase

Mantelbuis/gestuurde boring


Speer Infra
Energiestraat 23c
1411AR Naarden
035-6953323

datum uitvoering: 01-12-2019

datum tekening: 08-10-20

opdrachtgever : GEMA4 ZONE WEST CV

project	: 19.943
---------	----------

onderwerp : Schiphol Trade Park

School	: 1-2000	Onderdeel	: OVL
Blootformaat	: A0	Status	: Definitief
Gedownload	: D. van den Bosch	Projectleider	: M. van den Brink
Tekeningnummer	: 1 van 1	Gecontroleerd	: E. Batavier
			Versie : 1