

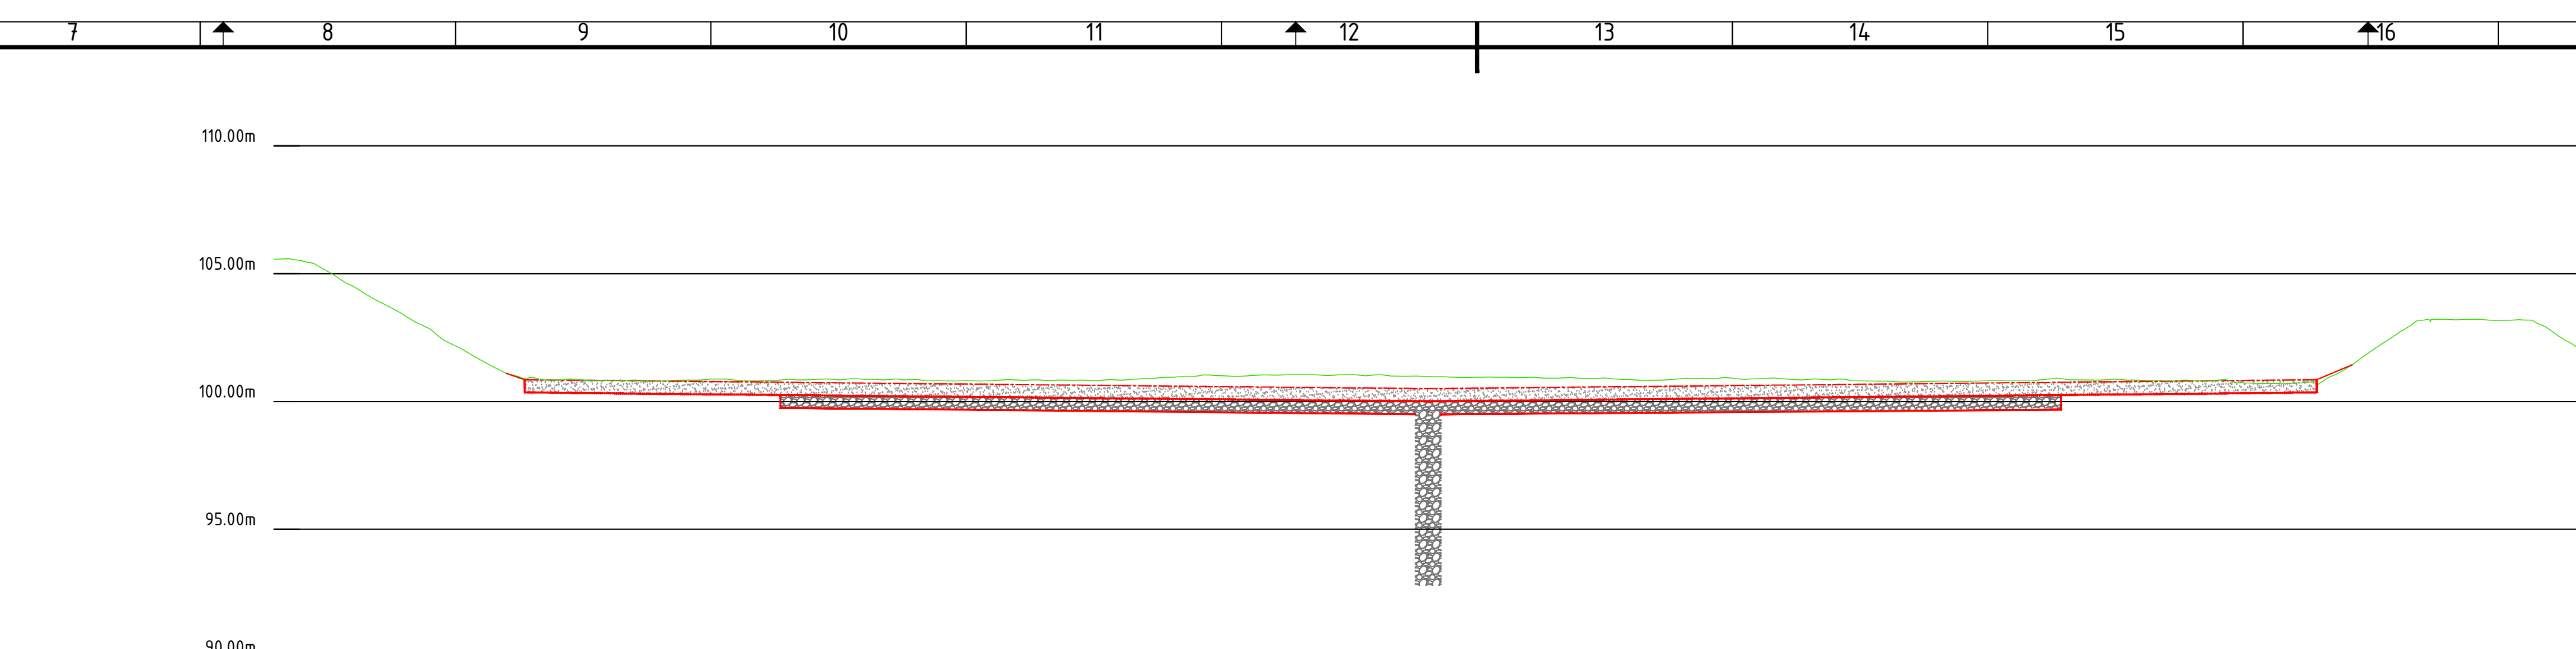
 
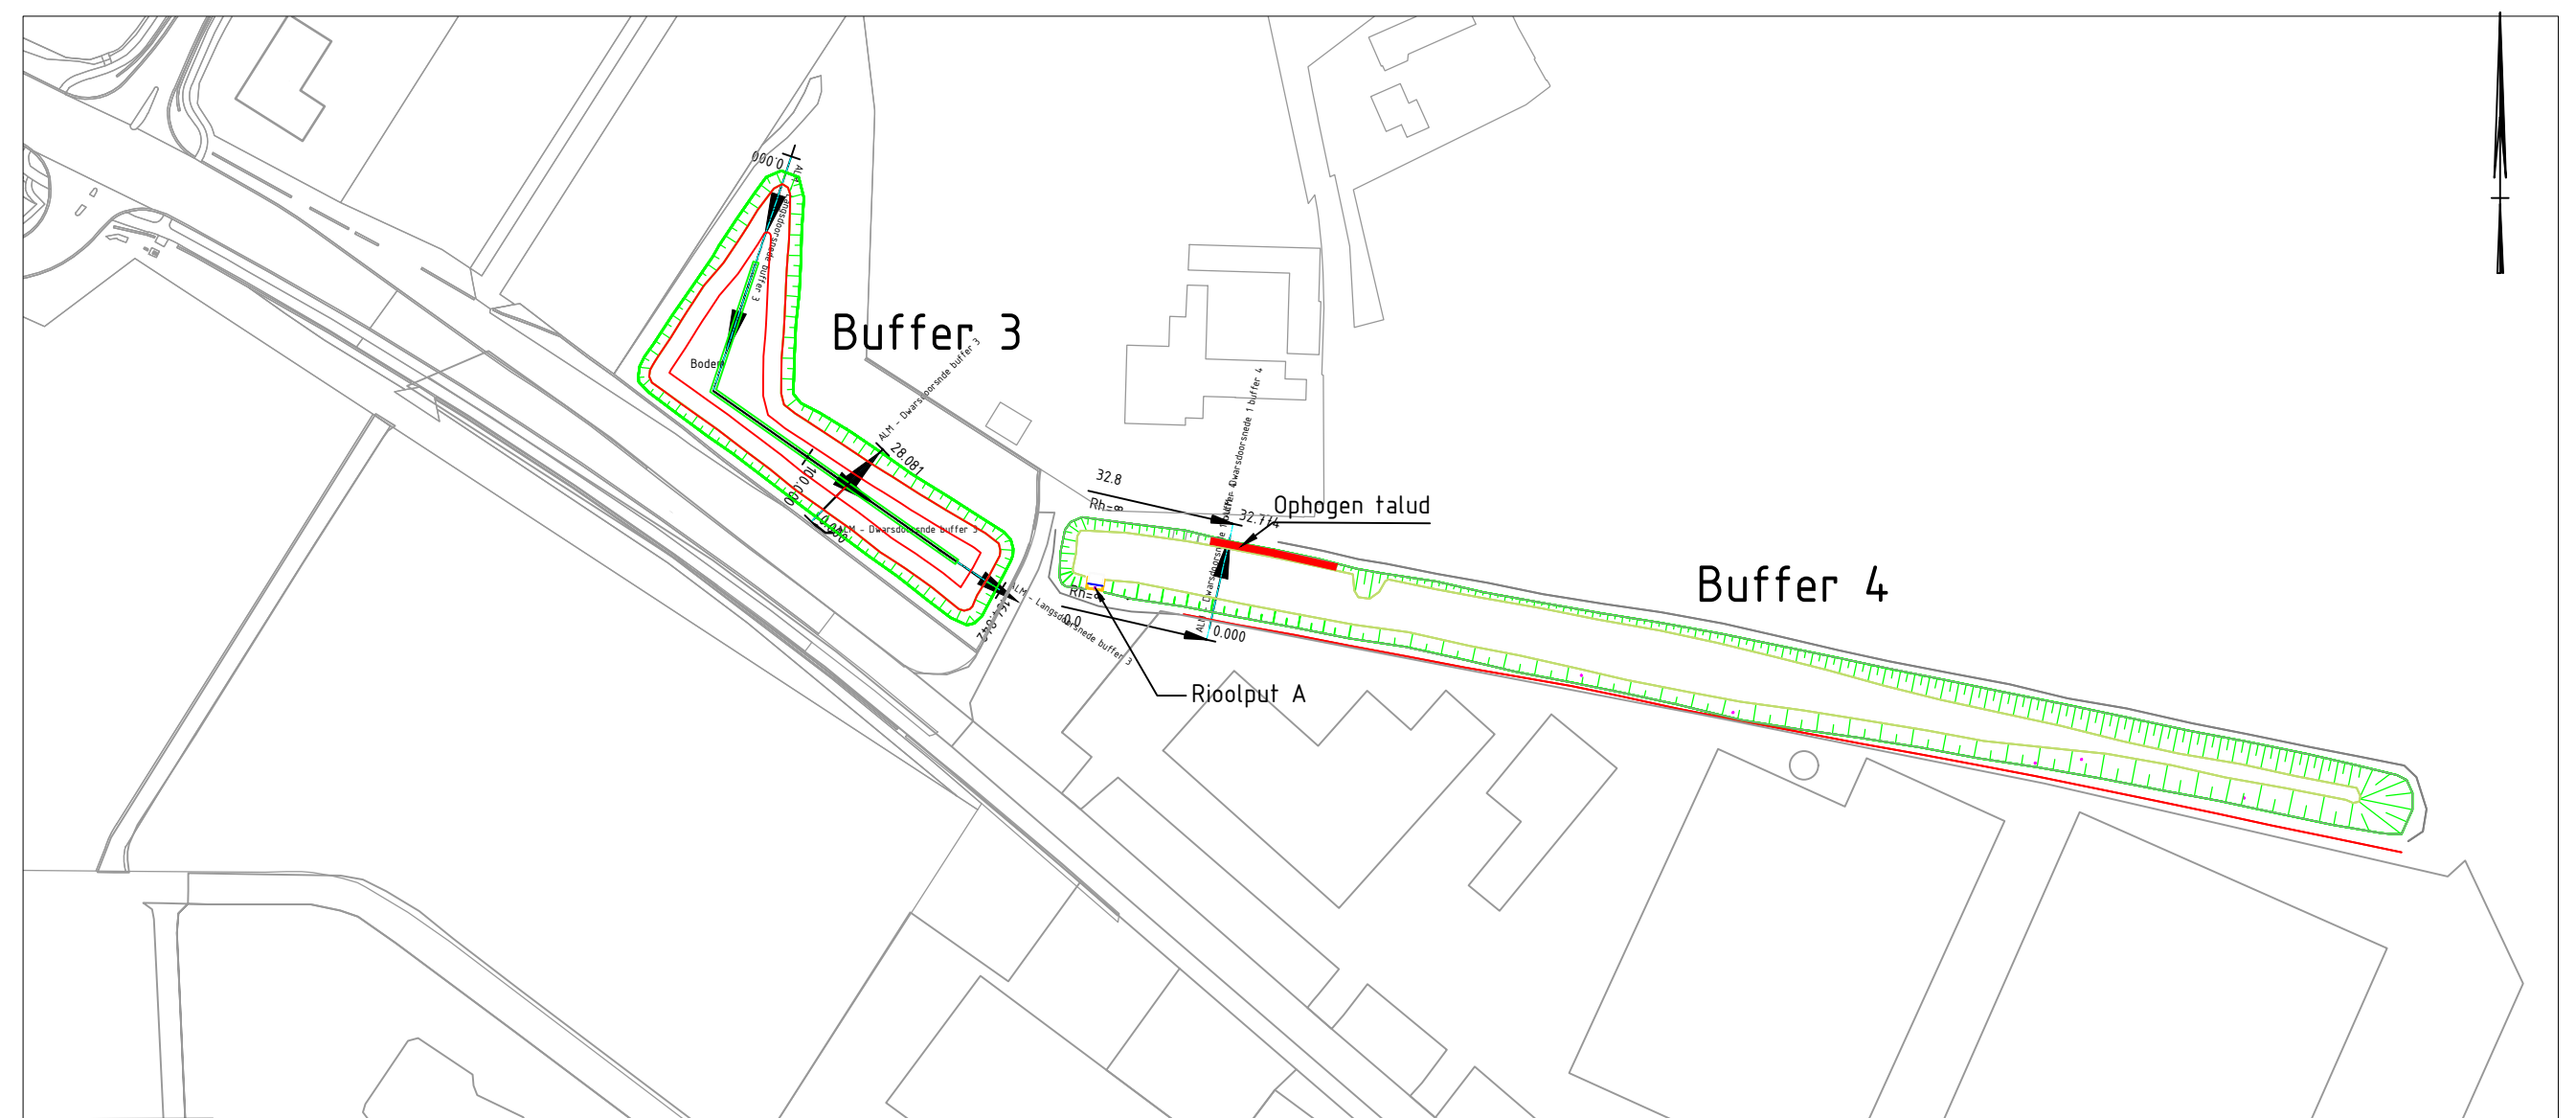
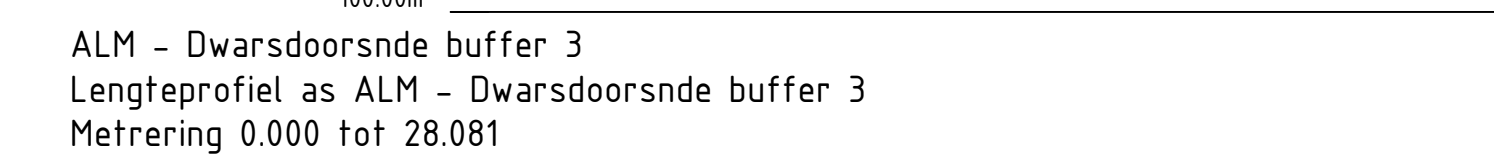
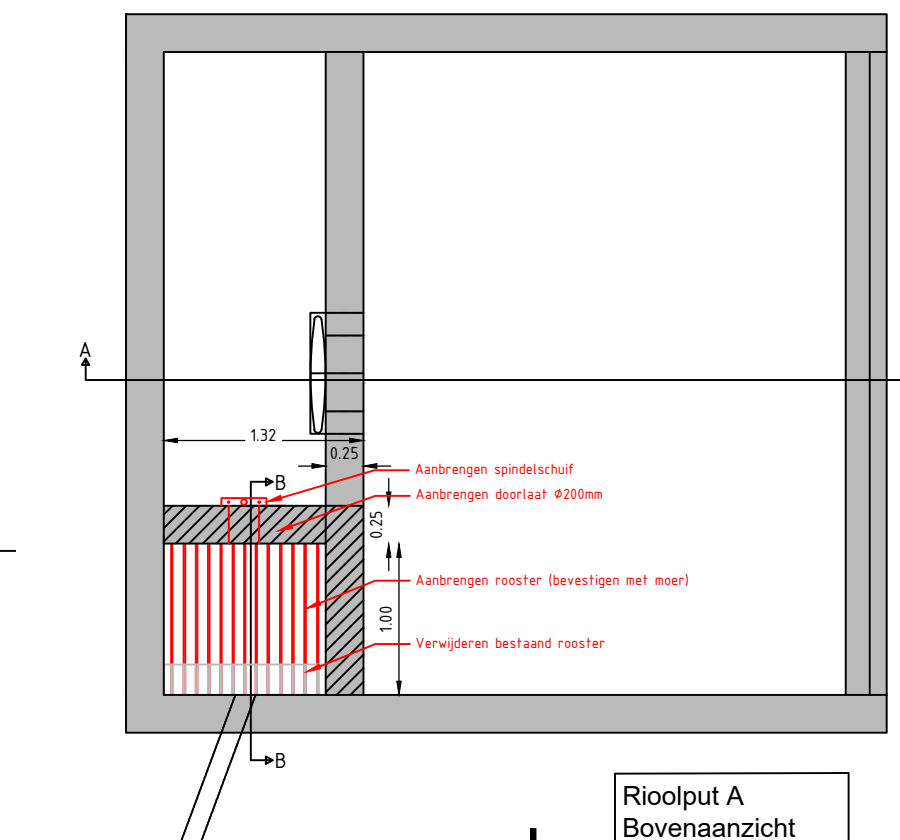
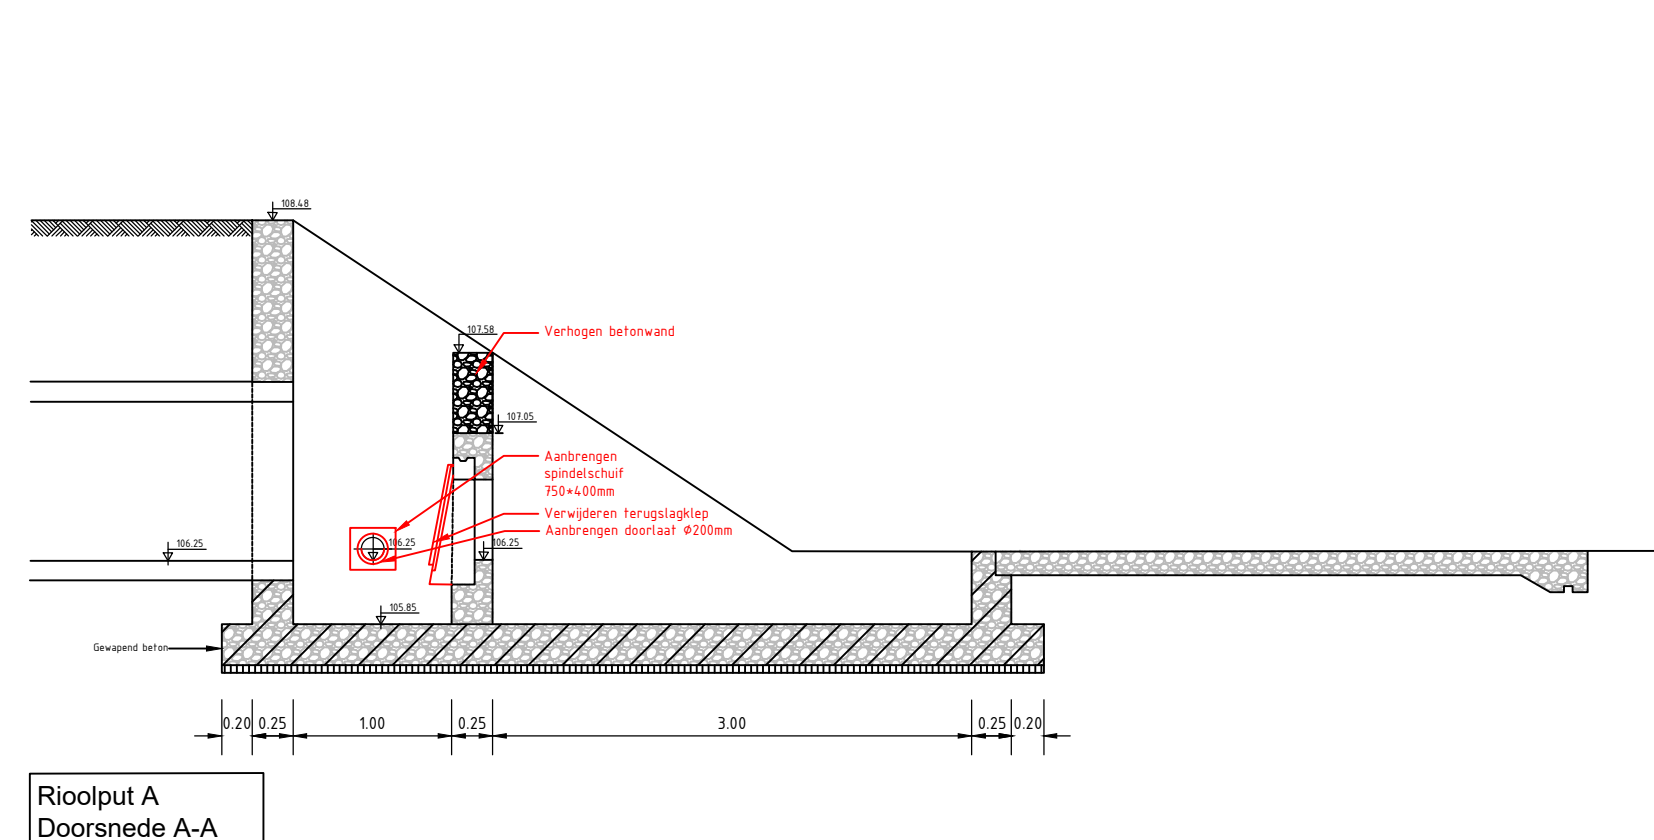
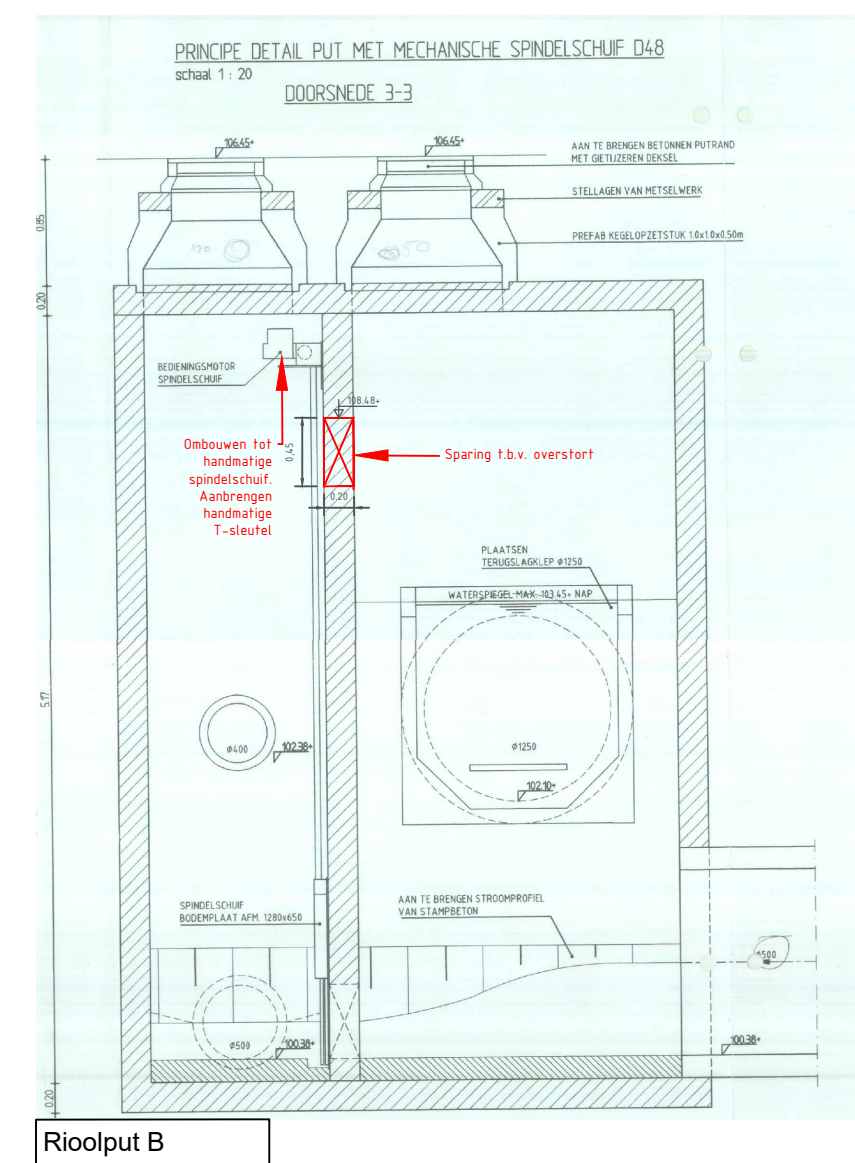
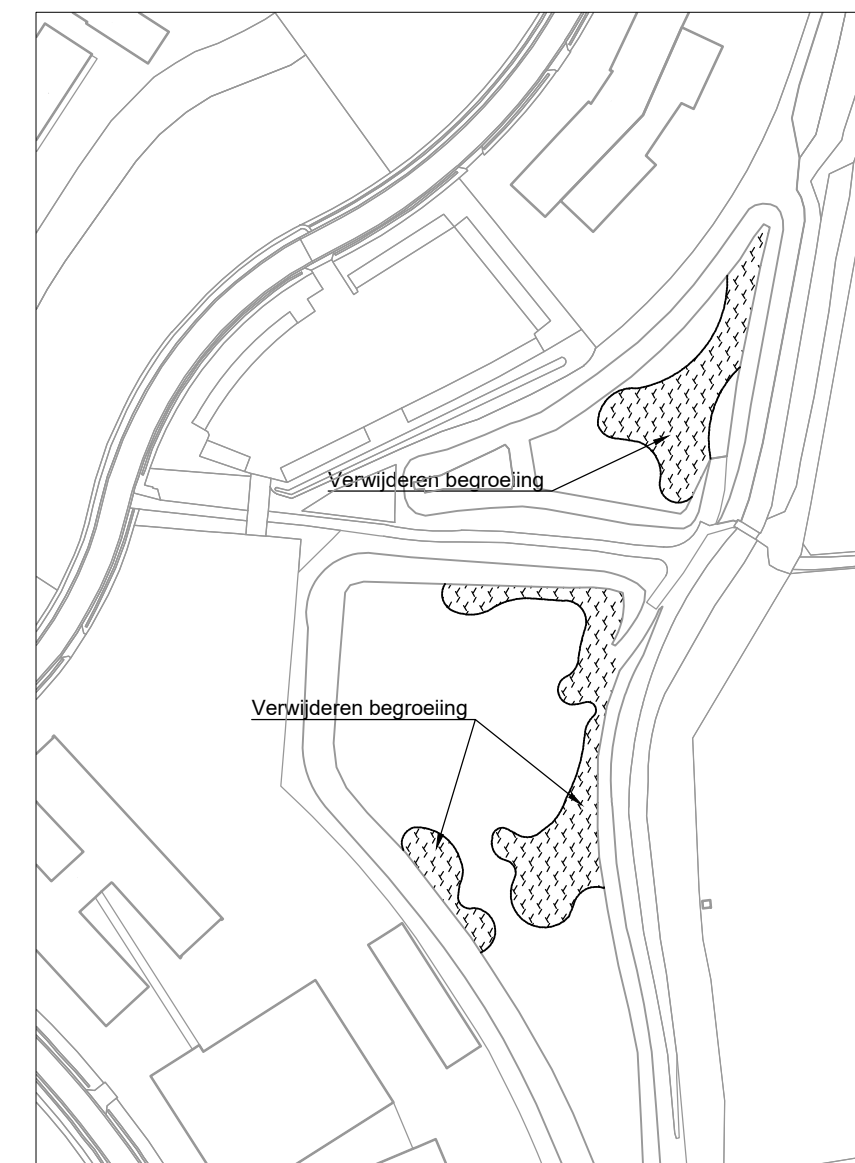
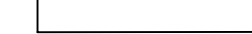
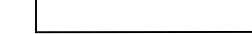


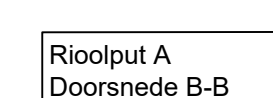

Metreering	0,000	20,000	30,000	40,000	50,000	60,000	70,000	80,000	90,000
Horizontaal verloop	L=90,380m								
Verticaal verloop	 $P=-1,0\%$ $L=35,383m$				 $P=1,0\%$ $L=30,195m$				

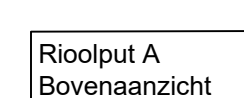

Nieuwe situatie
Schaal 1:2000

[illegible]

revisie	omschrijving	geplaatst	gecontroleerd	afgeord	datum

opdrachtgever

Gemeente Beek

project	 Royal HaskoningDHV Enhancing Society Together HaskoningDHV Nederland B.V. Transport & Planning				
Buffers TPE					
omschrijving	Situatietekening, lengteprofiel, dwarsprofiel, detail				
formaat	schaal	afmetingen	bestand	bladzijde	van
		A 4	20190106	1	1
documentdata		documentversie			
Definitief		1.0			
projectnummer / bestaatsnummer					
T.R.D.HV.7322 100_101					