
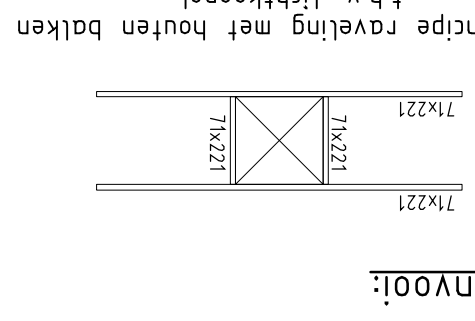


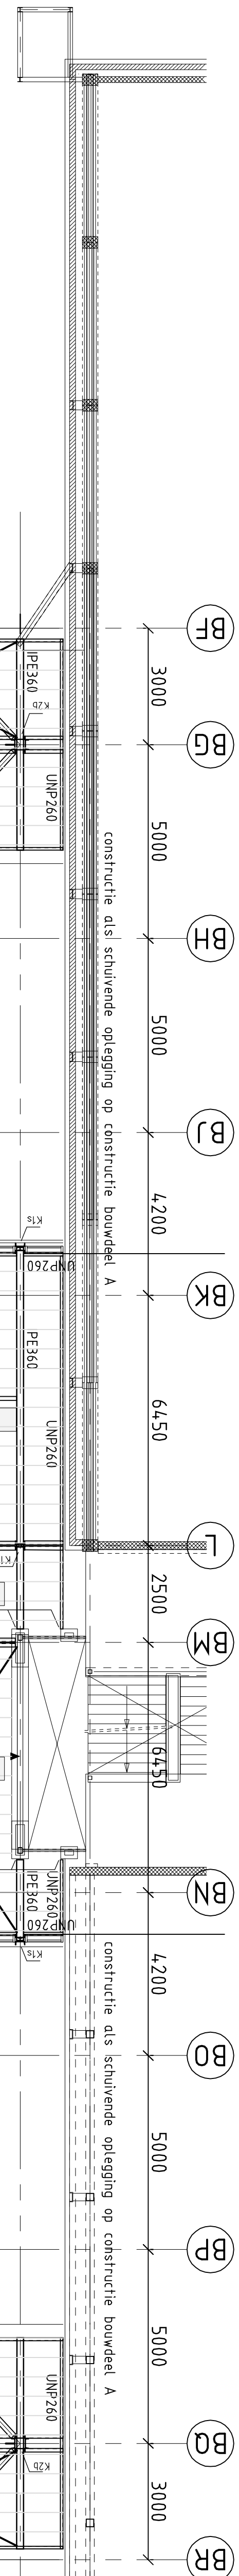



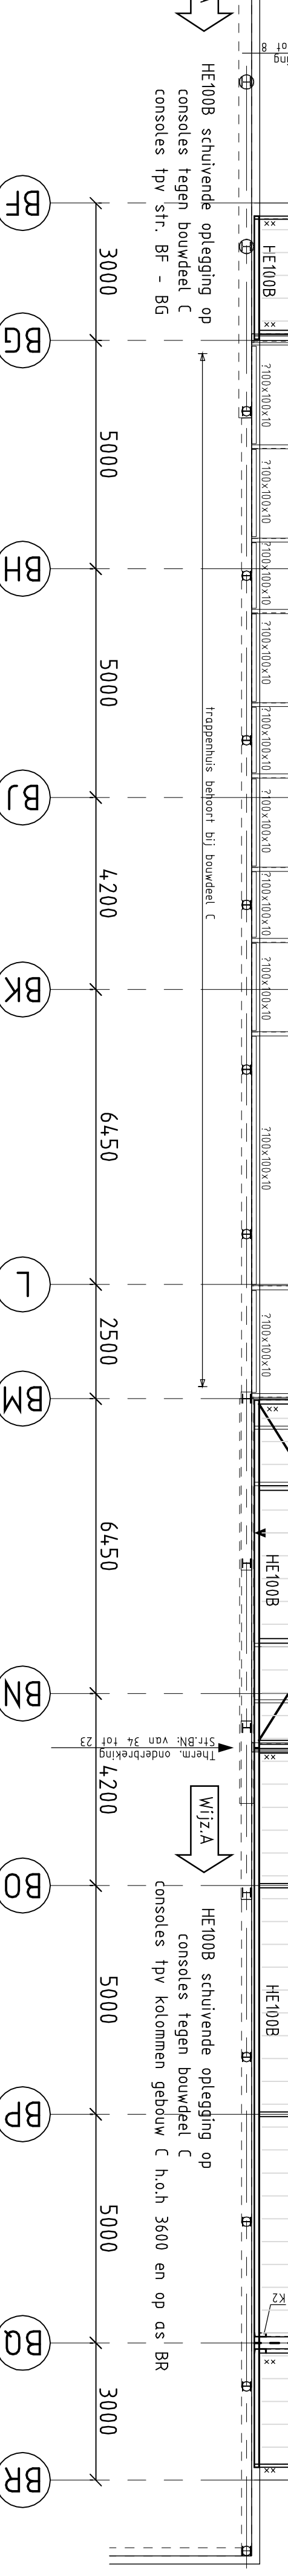
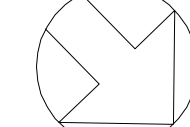



[illegible][illegible]

|                 |                                         |  |
|-----------------|-----------------------------------------|--|
| Project         | Nieuwbouw onderwijspaviljoen Venlo Zuid |  |
| Afzender        | a/d Hooftrouveng te Venlo               |  |
| Opdracht        | Duijns & Meyer I.v.o. de Maasticht      |  |
| Overname        | Dakvloer                                |  |
| Staat           | 1:100                                   |  |
| Scale           | 1:100                                   |  |
| Def. ont.       | 16-09-2005                              |  |
| Gepl. M.v.d.    | 04-09-2005                              |  |
| A.3.3.0.1.0.105 |                                         |  |
| Bestandnr.      | W-B-05                                  |  |
| Werknummer      | 04081                                   |  |