


10" 500 M3

Hydrostal


970282

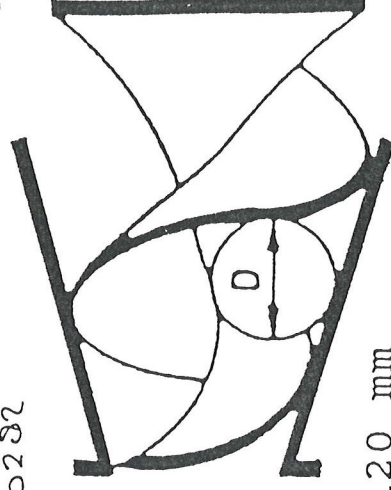

φ 120 mm

F10K-HD — 1460 min⁻¹
— 960 min⁻¹
--- 730 min⁻¹

Bestel nr. 3-dienst g7
AFVOER KWELWATER

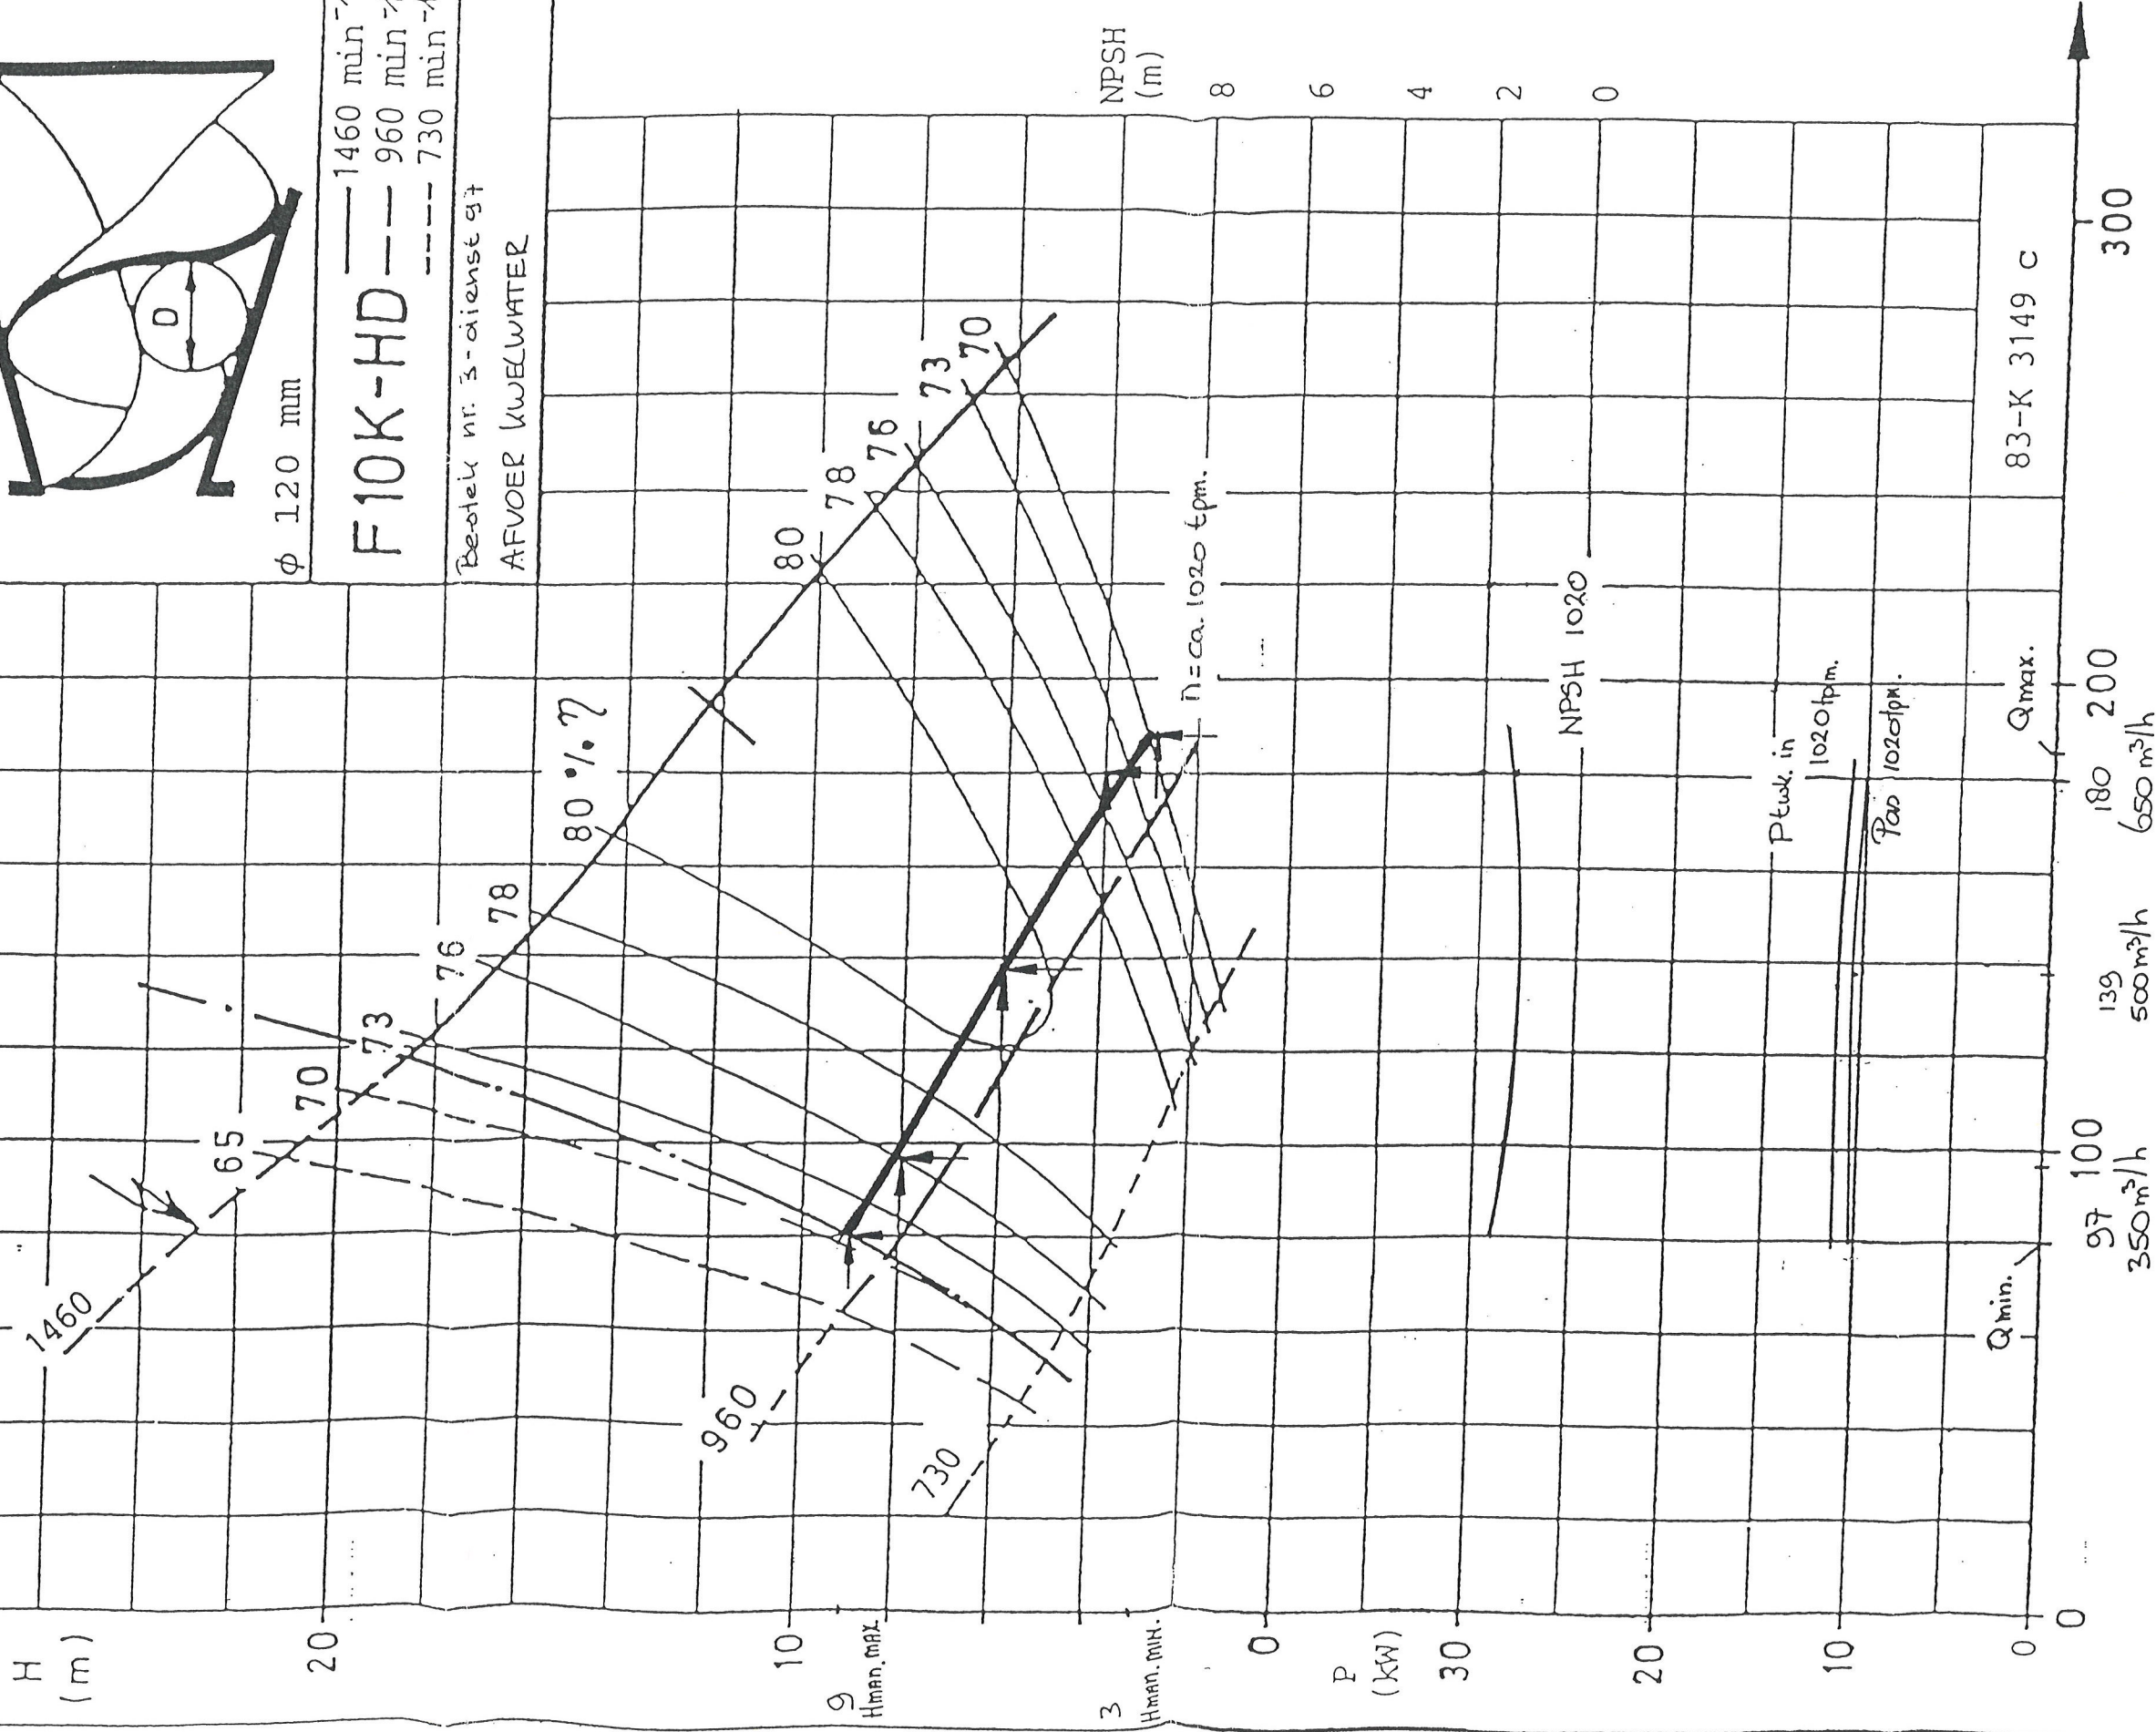

Kurve vlg. ISO 2548 kl. C

1.5.85 / 25.7.86 / 9.4.87

83-K 3149 c