


Belsy

Hidrostat

BEARING FRAME PUMP
LAGERSTUHL PUMPE

H12K-SD


— 1460 min⁻¹
- - - 970 min⁻¹
- - - 730 min⁻¹

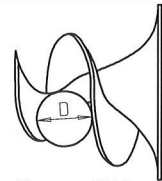

D = 150mm

Tandwielkast
overbrenging 1:51

Max.

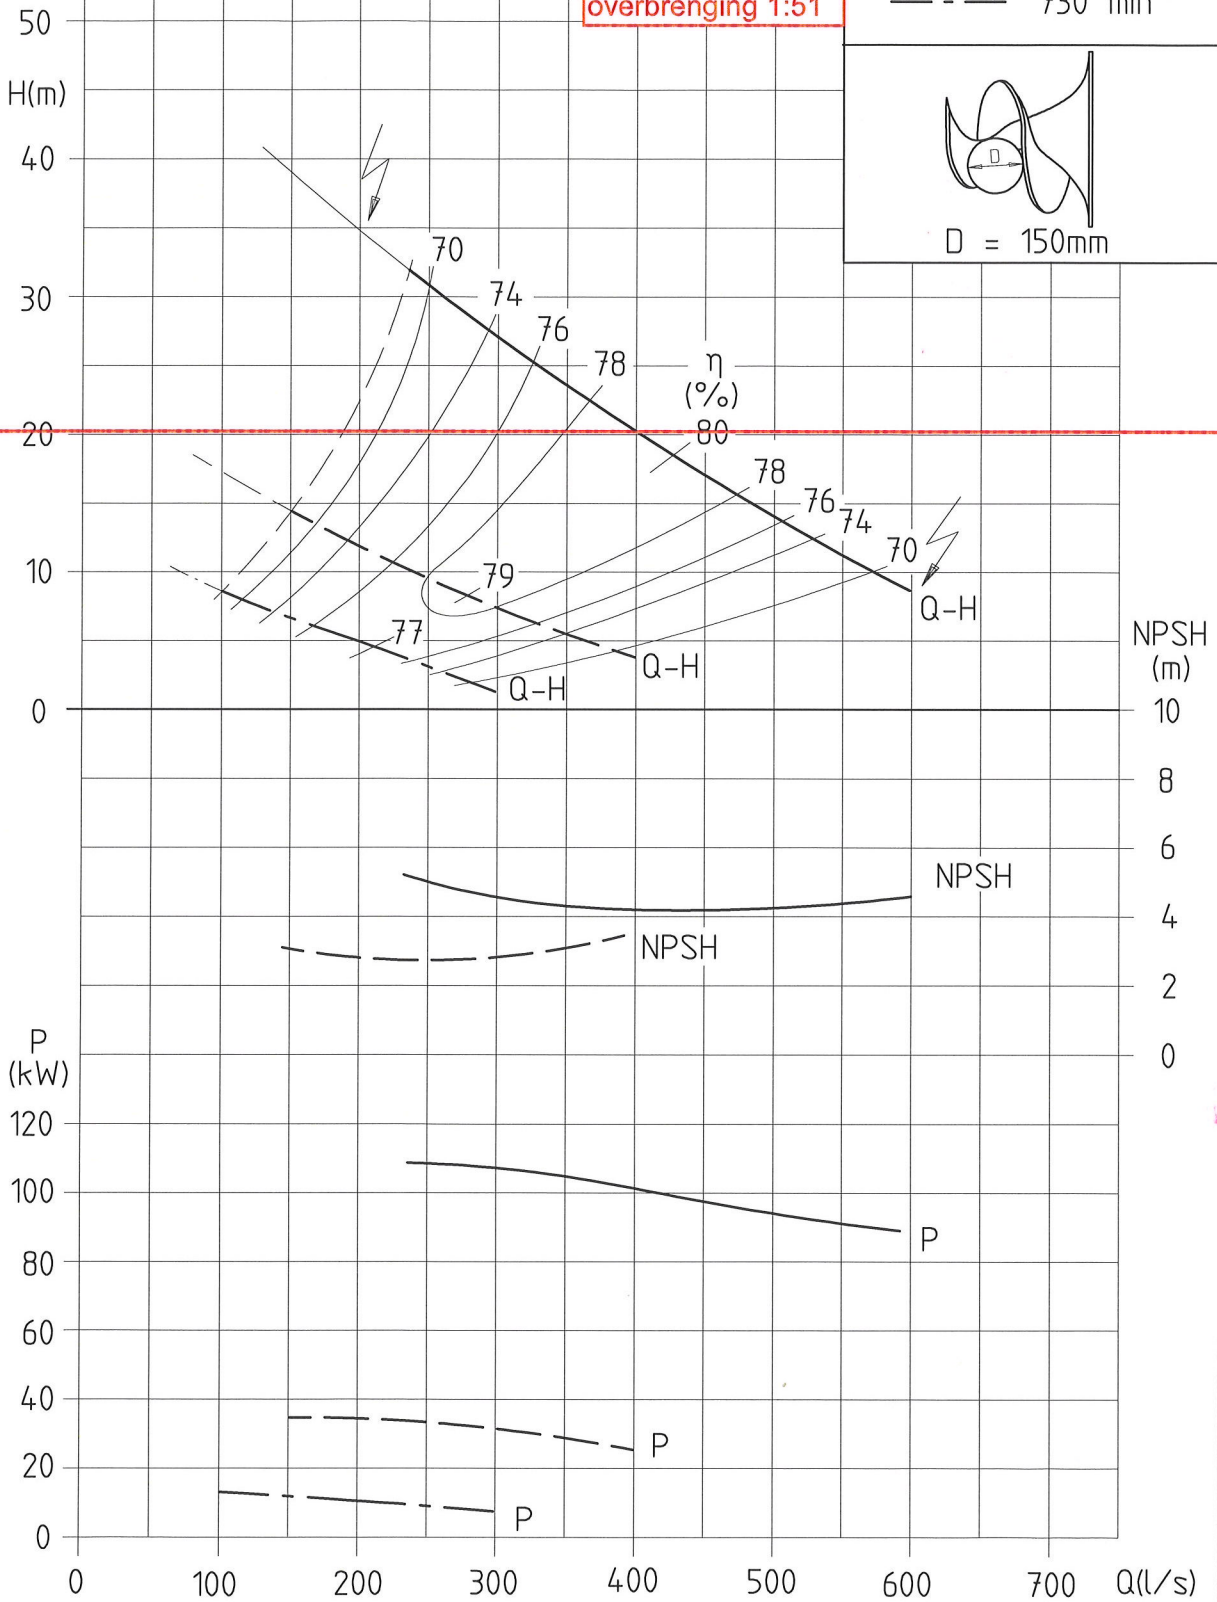

A e n d . :

Drawn by/Bearb. Dat.Vis. : 12.11.96 PK
Approved by/Gepr. Dat.Vis. : 13.11.96 HF

N o : 83-K3151b