
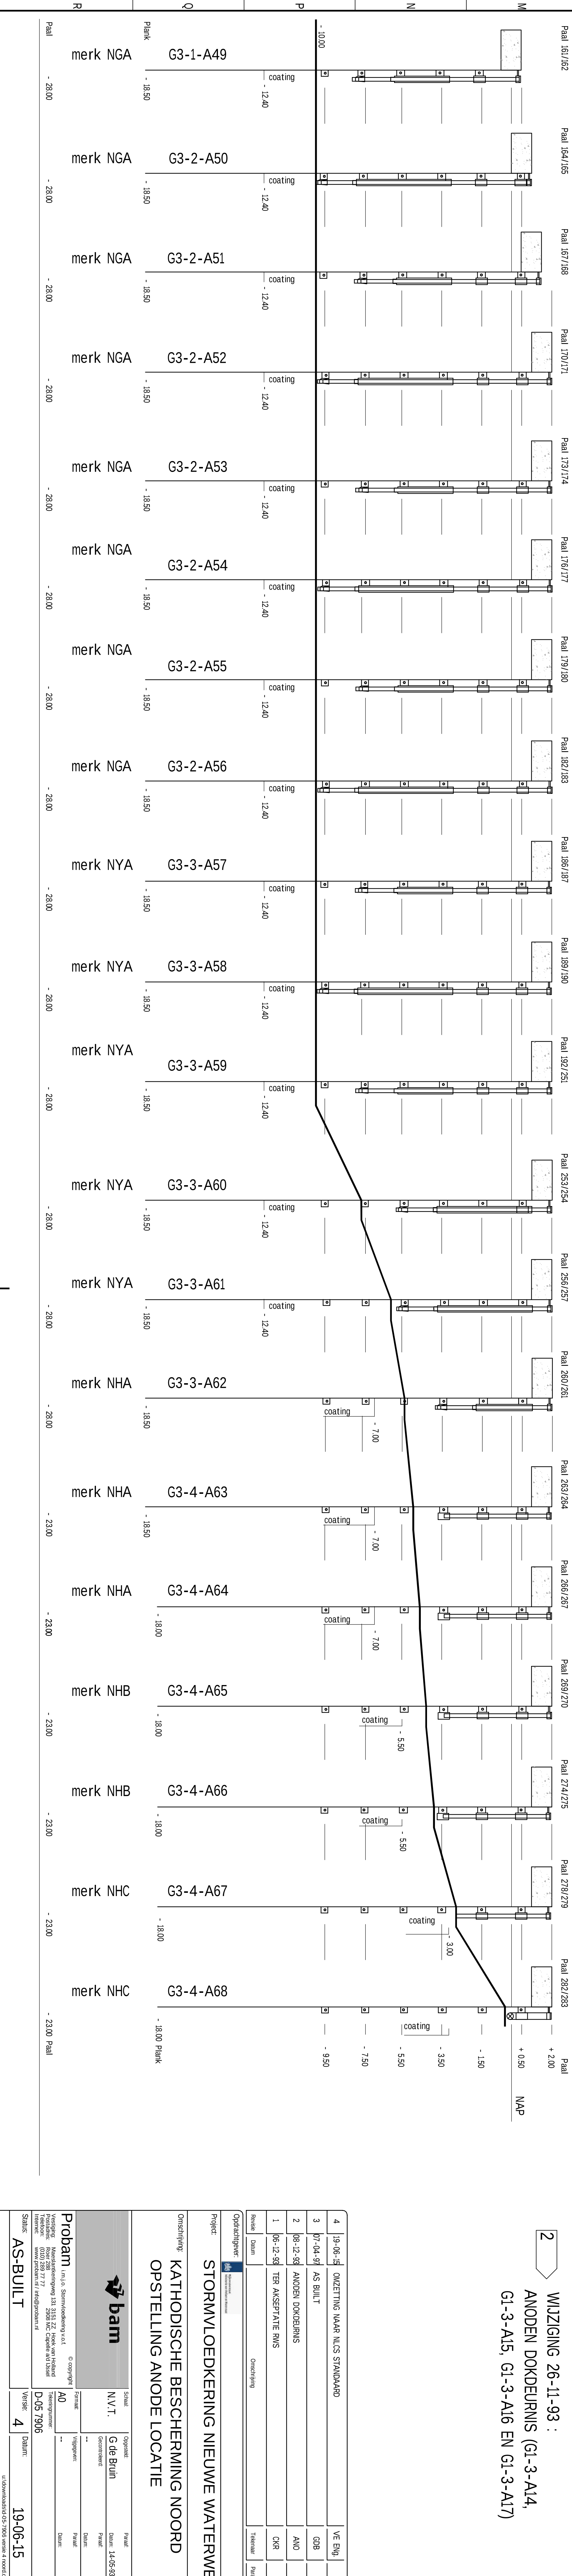
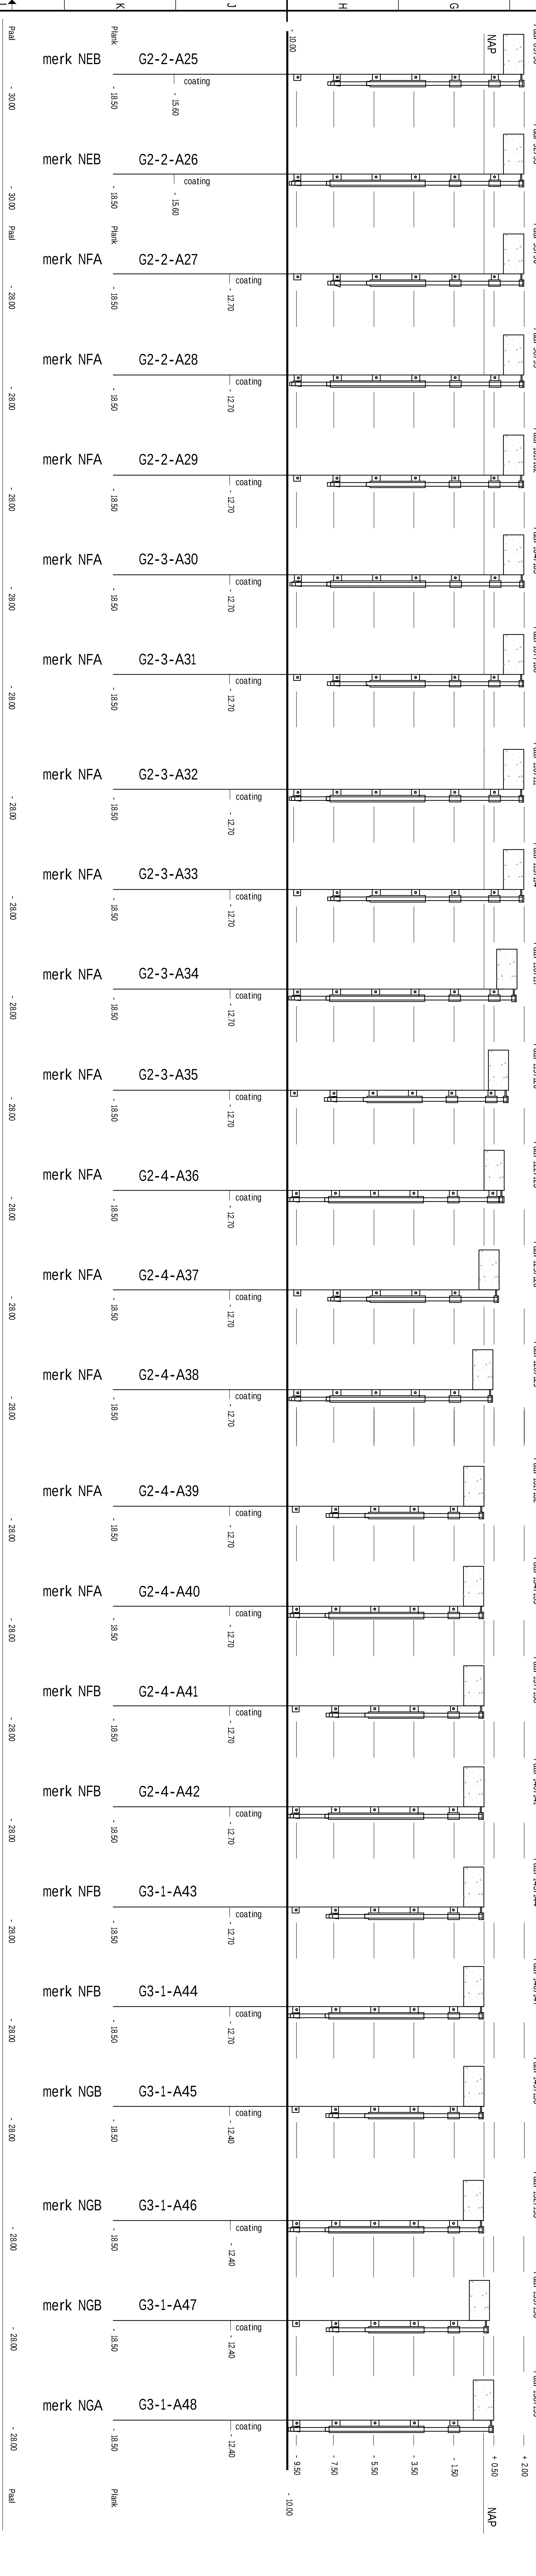


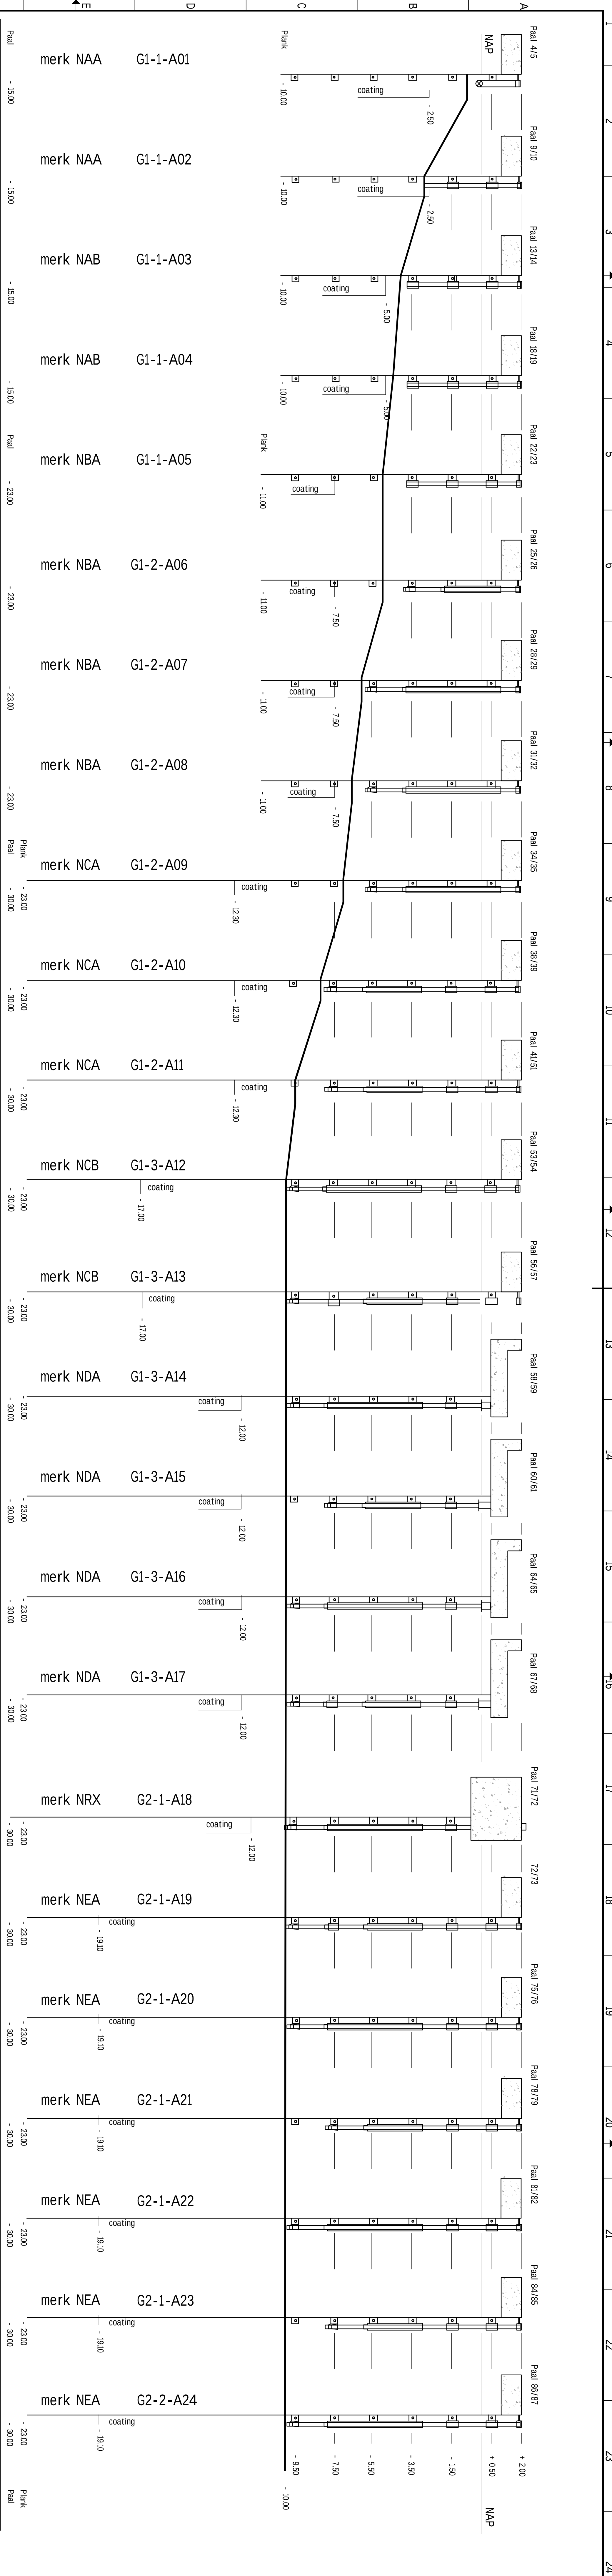

2

WUZZINGS 26-11-93 :
ANDEN DOKDEURNIS (G1-3-A14,
G1-3-A15, G1-3-A16 EN G1-3-A17)

4

19-06-15


VE Eng

3

17-04-91

AS-BUILT

GB

2


ANDEN DOKDEURNIS

AND

1



CR










Designing

Kathodische Bescherming Noord
Opstelling Ande Locatie

Scale

N.V.T.











Version

4

Date

19-06-15