




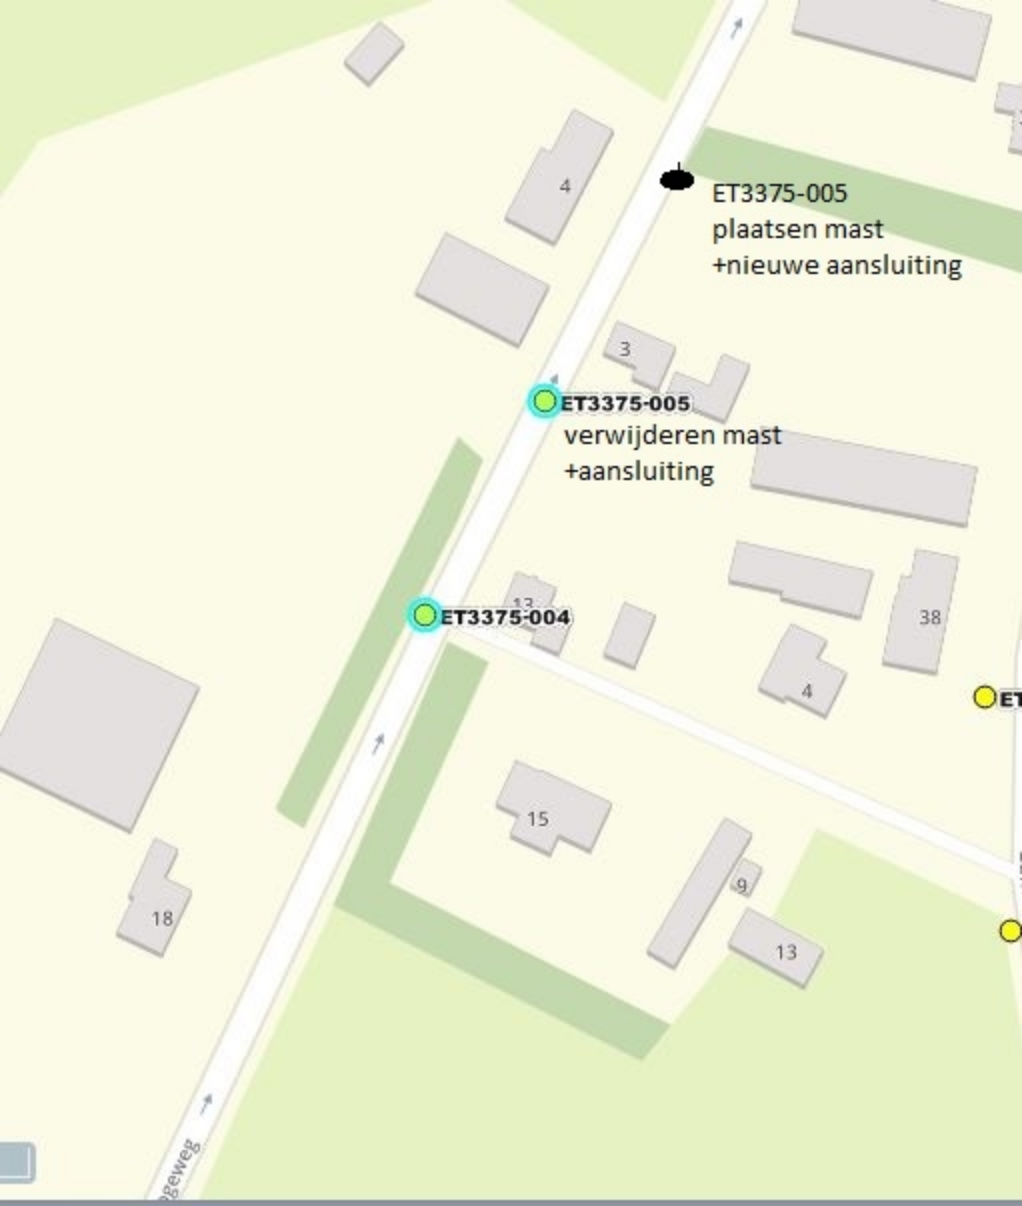

ET3375-005
plaatsen mast
+nieuwe aansluiting

This map shows a residential area with several buildings labeled with numbers: 4, 3, 13, 38, 4, 15, 9, 13, 18, and 13. A road labeled 'Breweg' runs diagonally from the bottom left towards the top right. Two utility locations are marked with green circles: ET3375-005 and ET3375-004. ET3375-005 is located near building 3, and ET3375-004 is located near building 13. A black dot is also present near building 4. The map includes green areas representing grass or parks and grey shapes representing buildings.

ET3375-005
verwijderen mast
+aansluiting

ET3375-004