



Afgeleverd 20-01-06

Coördinaten paalfundering duiken Centrumlijn Noord

Damwand

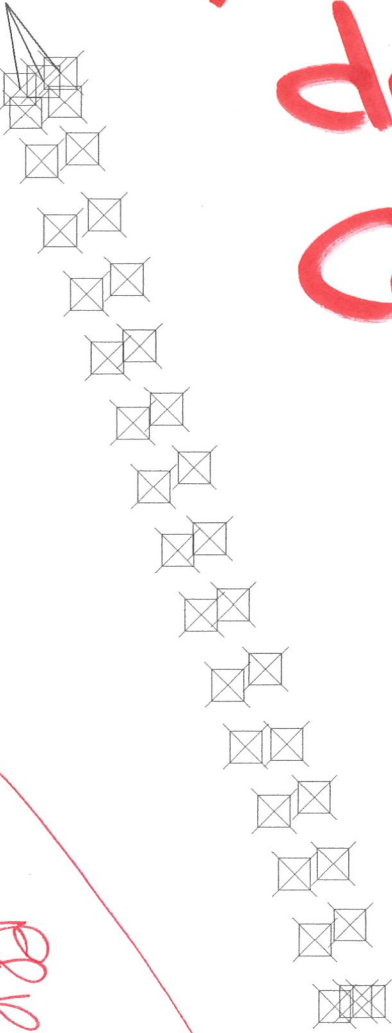

PER

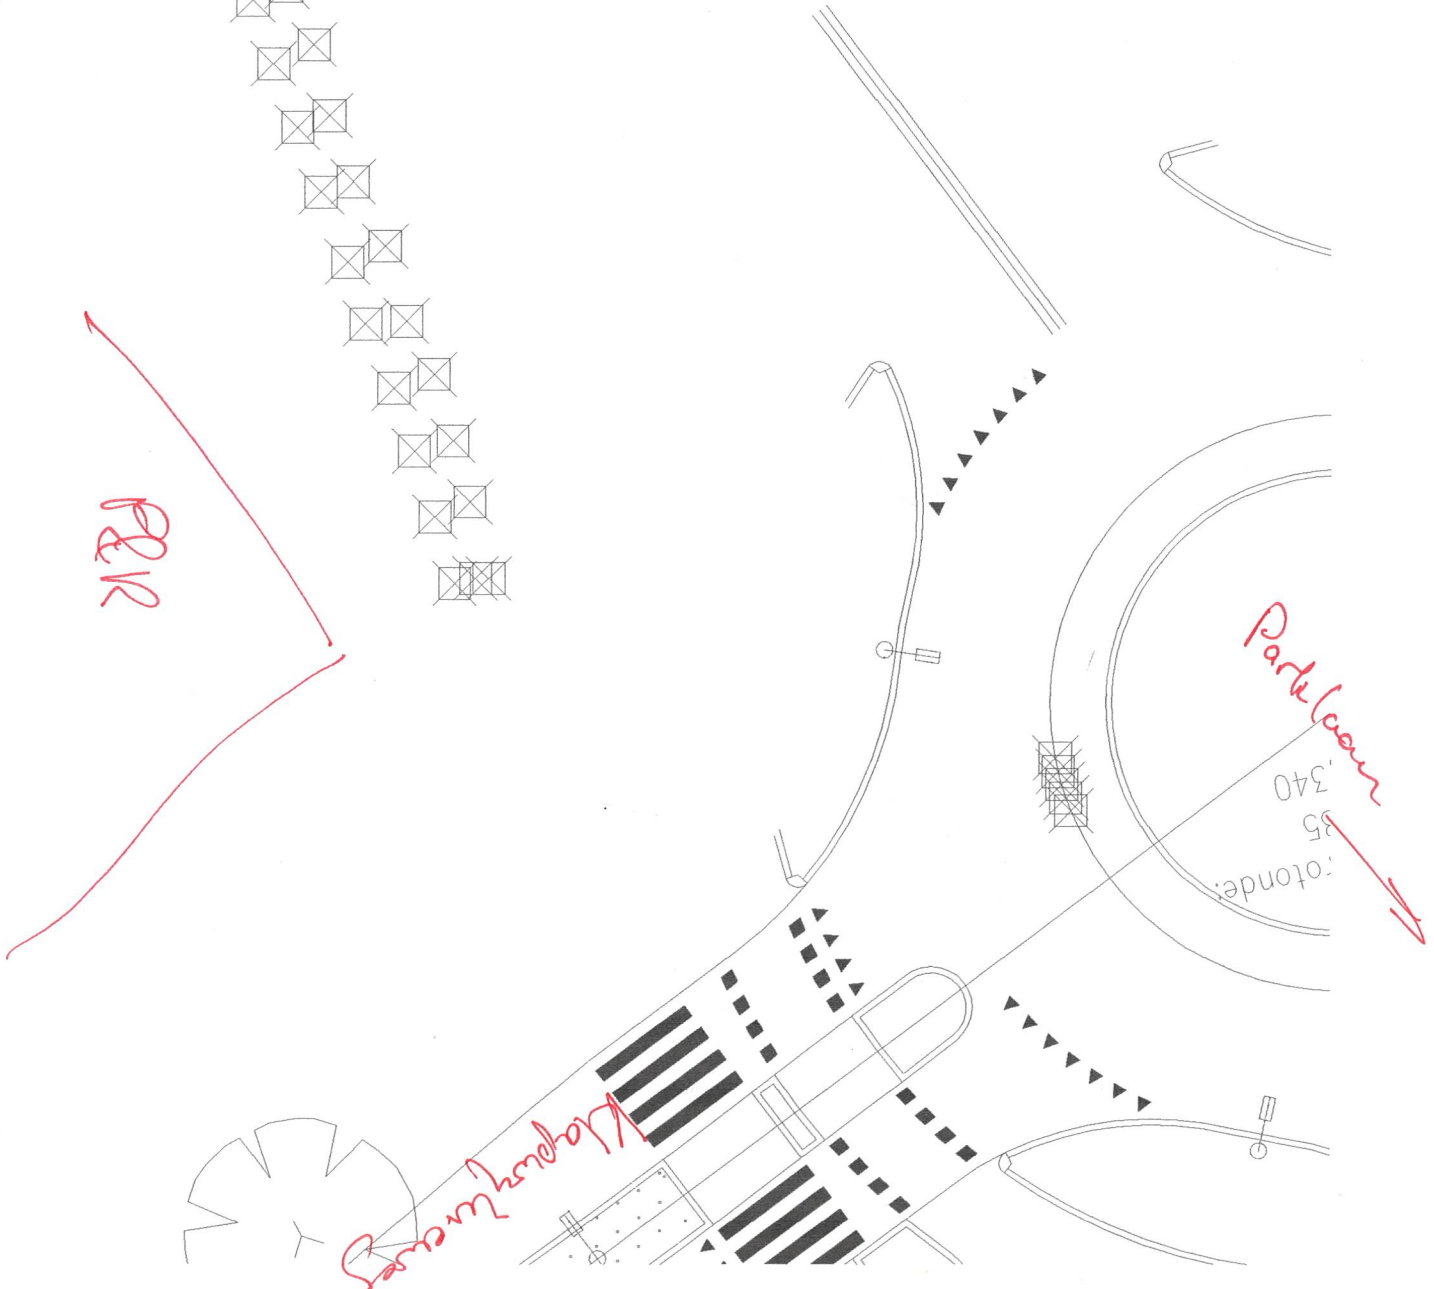

Parklaan

340

55

afstand

Wageningen

3x is scheepvaart

Heipalen verwijderde duiker 21-04-2005

90420.154,446866.436,-4.743	
90419.970,446867.191,-4.771	
90419.970,446867.677,-4.946	
90417.727,446865.716,-4.479	
90417.183,446866.995,-4.864	
90414.956,446866.378,-4.414	
90415.329,446864.963,-4.473	
90413.047,446864.229,-4.395	
90412.536,446865.680,-4.434	
90410.603,446864.676,-4.376	
90410.694,446863.195,-4.371	
90408.456,446862.546,-4.395	
90407.867,446863.906,-4.445	
90405.520,446862.738,-4.432	
90405.890,446861.587,-4.387	
90403.548,446860.749,-4.436	
90403.114,446861.890,-4.667	
90401.231,446859.867,-4.495	
90400.538,446861.331,-4.579	
90387.625,446855.272,-4.432	
90387.226,446856.678,-4.585	
90388.939,446857.312,-4.468	
90389.387,446855.852,-4.439	
90391.927,446856.522,-4.404	
90391.344,446858.088,-4.451	
90393.691,446858.909,-4.449	
90394.225,446857.468,-4.459	
90396.541,446858.218,-4.401	
90396.104,446859.354,-4.549	
90398.417,446860.347,-4.643	
90398.910,446859.125,-4.529	
90386.757,446855.075,-4.142	damwand
90386.483,446855.912,-4.105	damwand
90386.178,446856.534,-4.119	damwand