


- ASBEST-CEMENT

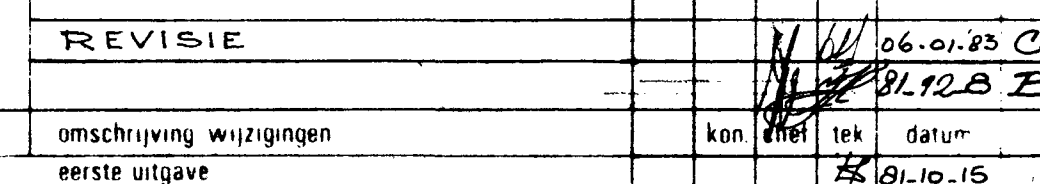

1_2977_17_01_13