
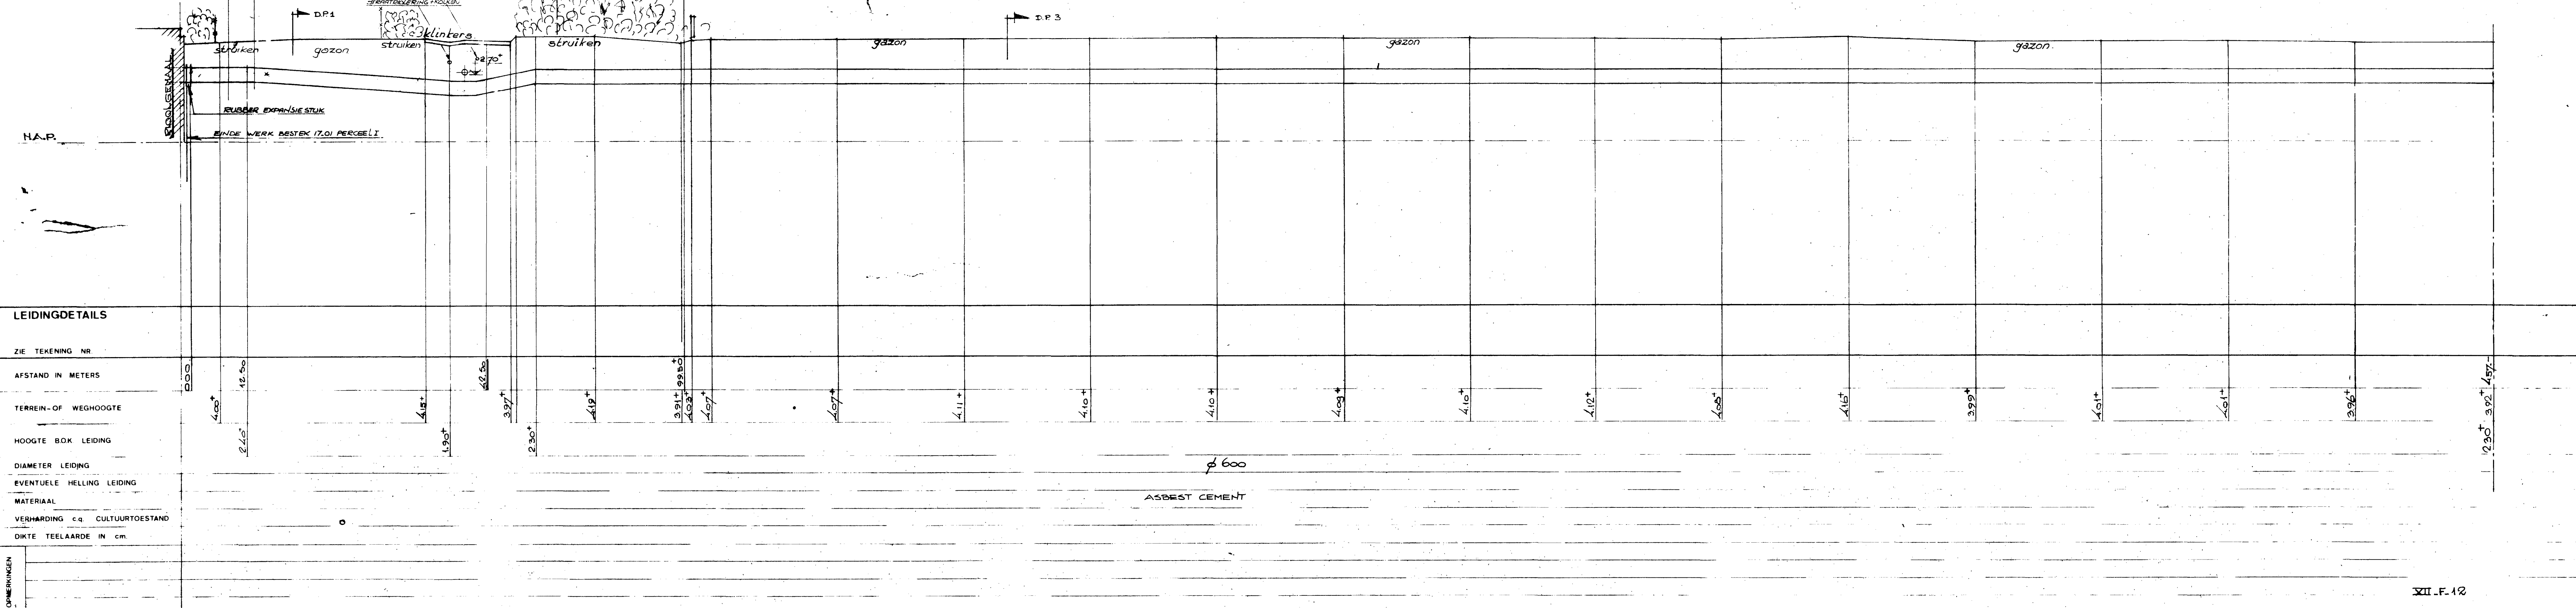


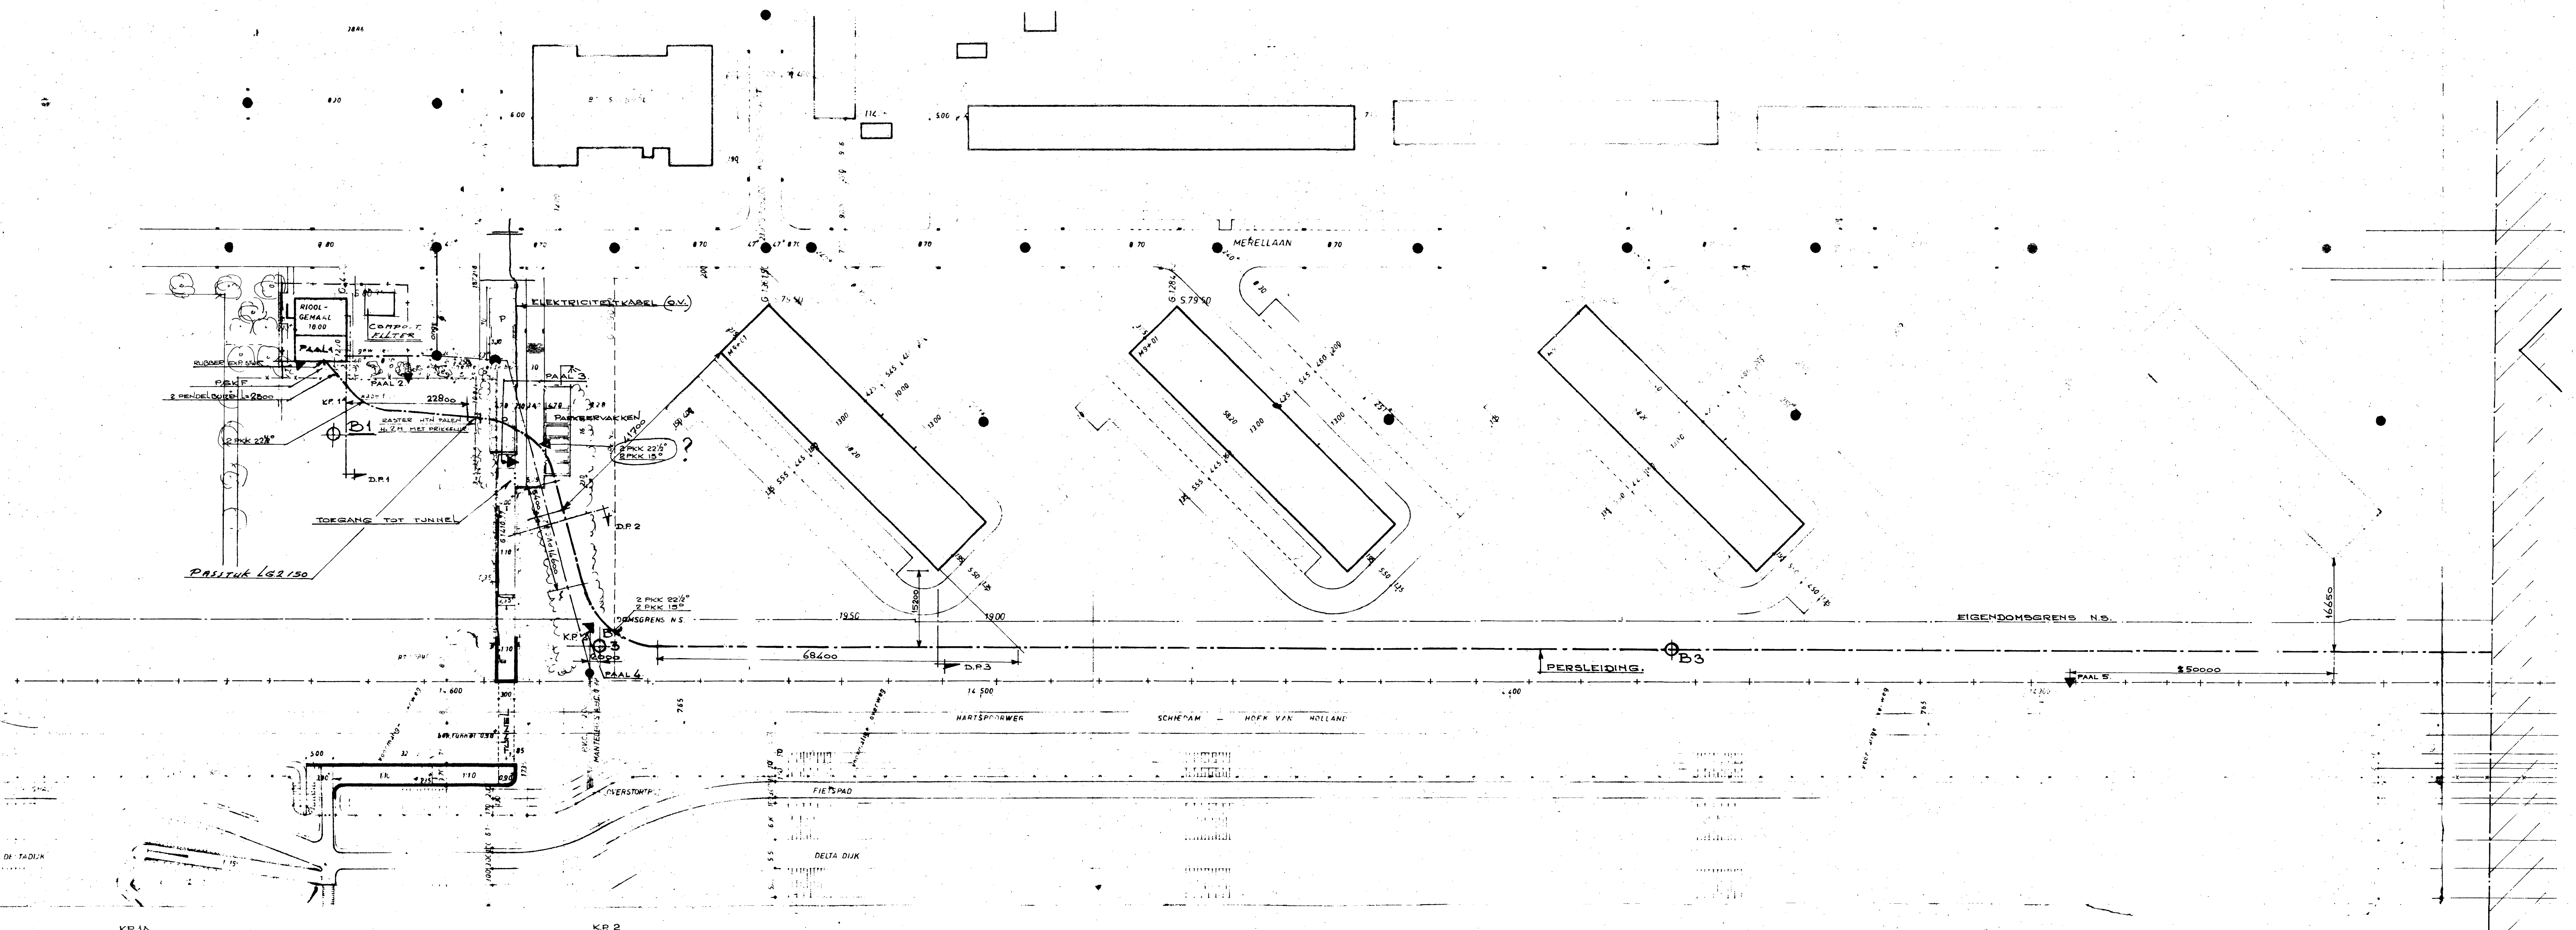

<