

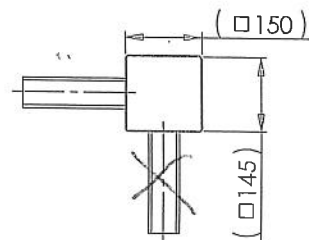
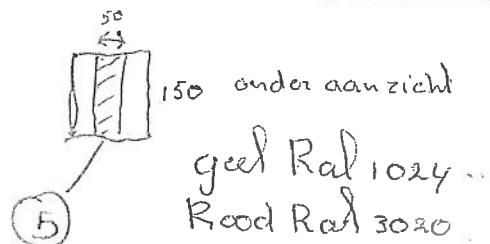


Thermusich Verzinkt


Verkeerspaal

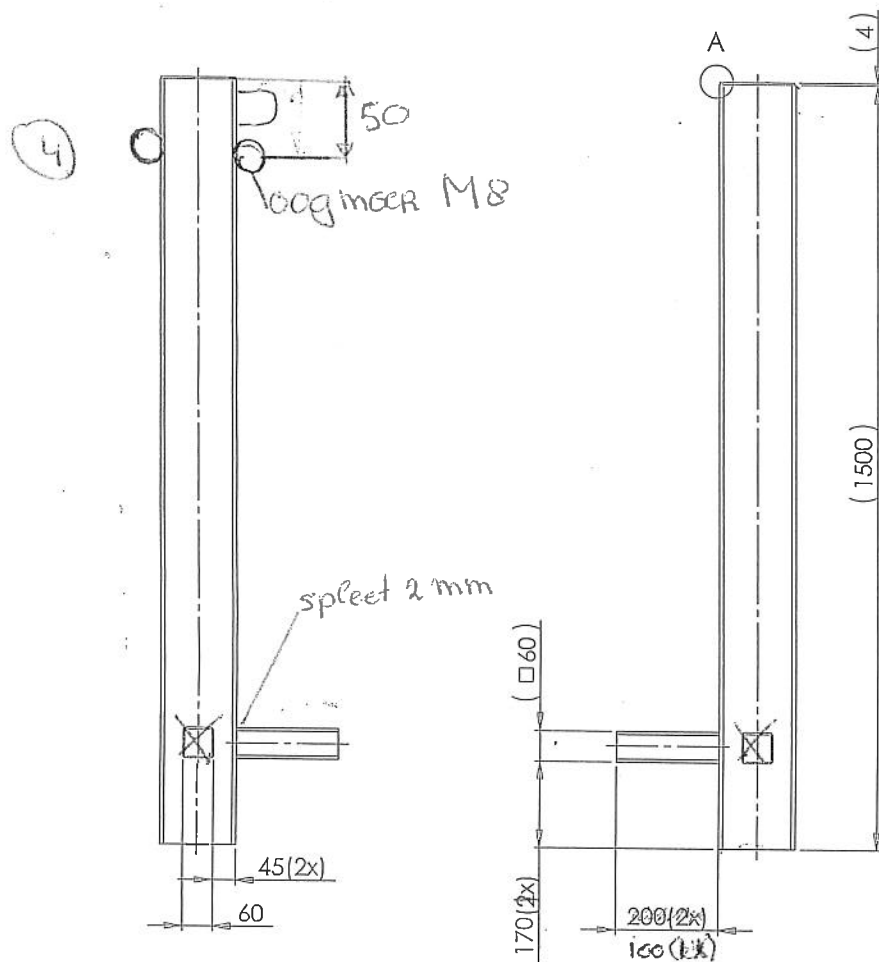

DETAIL A
SCALE 1:2

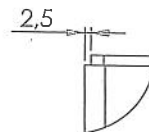

φ12(2x) 20x20 mm

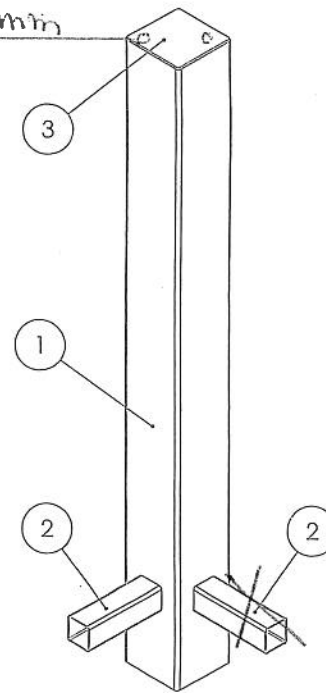

- Onderdelen rondom aflassen

Koker 150x150x4 mm

NR 1: 6 meter : 4 = 1.490 mm

NR 2: 1x uitvoeren

NR 3: 143 x 143 mm x 3 mm

NR 4: 160 100 000 001 Fabry

NR 5: Standaard 50x150x5 mm

	Material		
	S235JR		
	S235JR		
	S235JR		
AMER. PROJ.	FORM.	A3	
SCALE: 1:10	MASS: 3.8 kg		
Tolerancing principle ISO 8015			
Non-Indicated tolerances ISO 2768 mK			
PG/PGS 1/1			
DRAWING NAME			
Sam Verkeerspaal			
PROJECT			
Verkeerspaal			
DRAWING NO.			
VP-1-100			
REV.			

File: VP-1-100 Verkeerspaal.slddw