


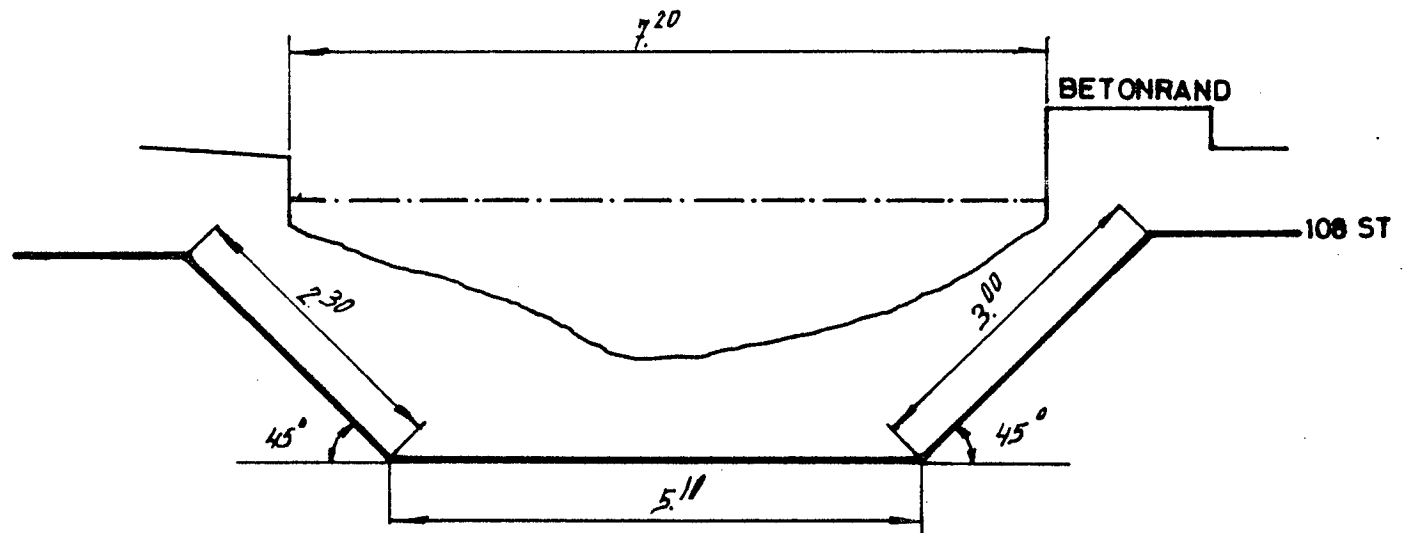

8259 Z 11.0 11