



Legplan en stringverdeling dak 1

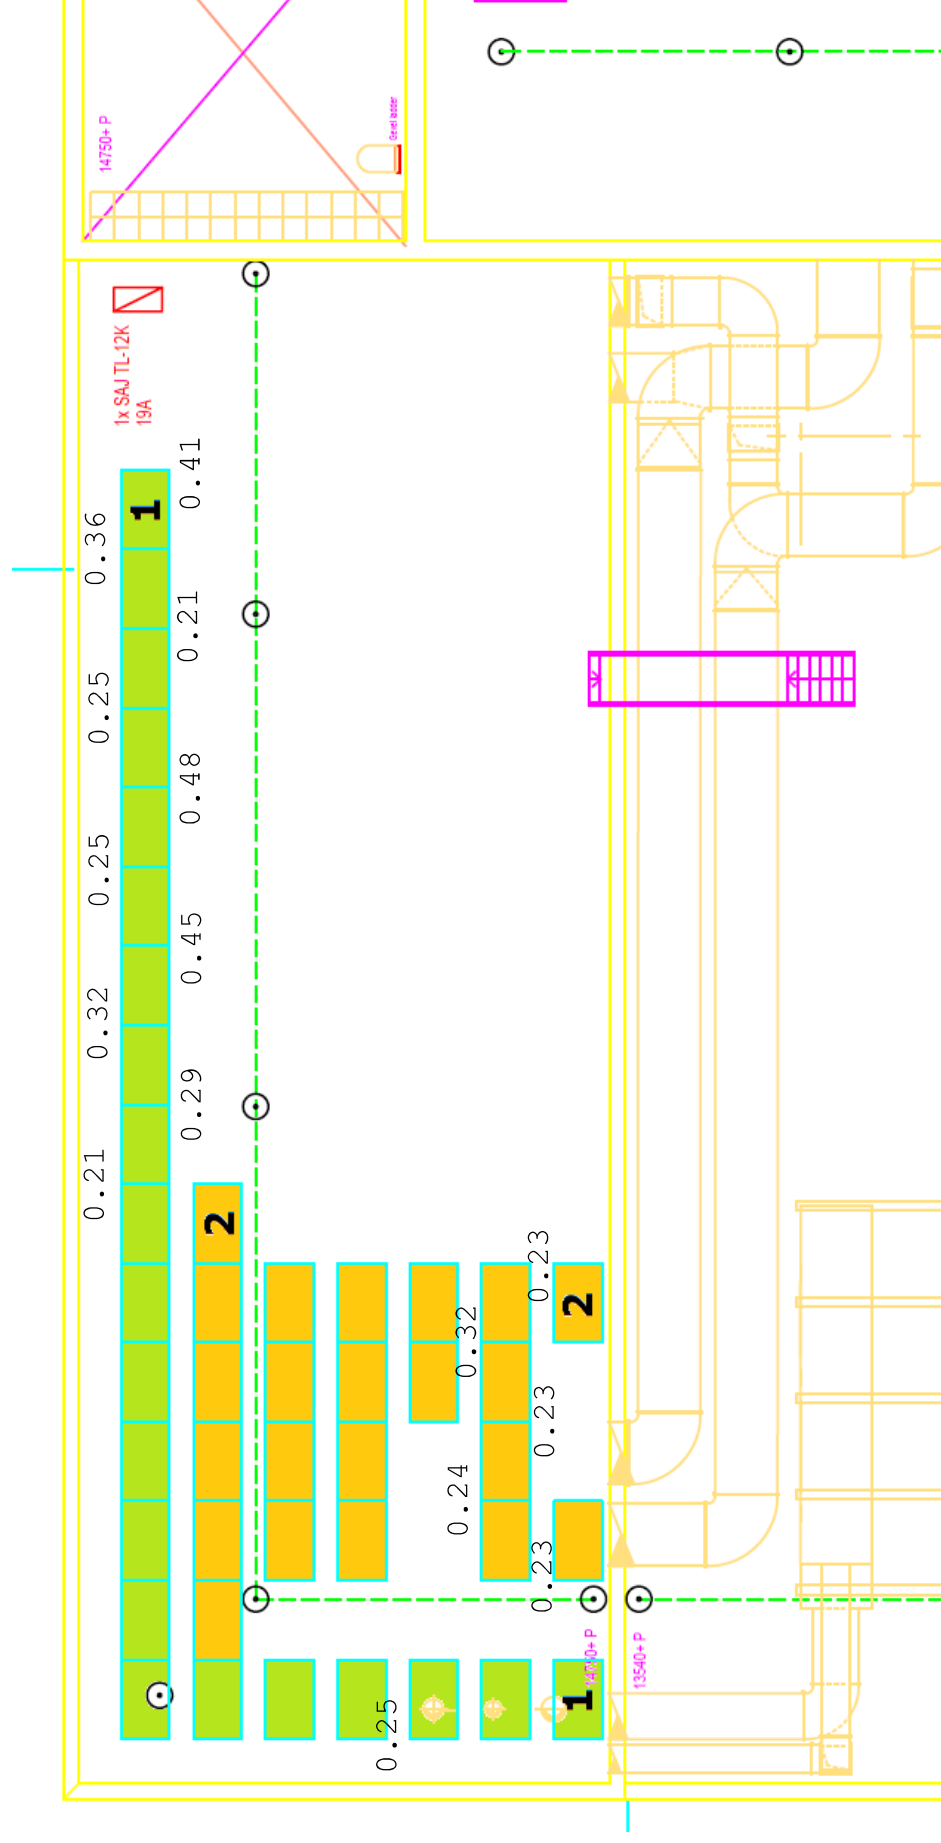

SAJ Suntrio TL12K
MPP1: String 1 (22 panelen)
MPP2: String 2 (22 panelen)

Legplan en stringverdeling dak 2

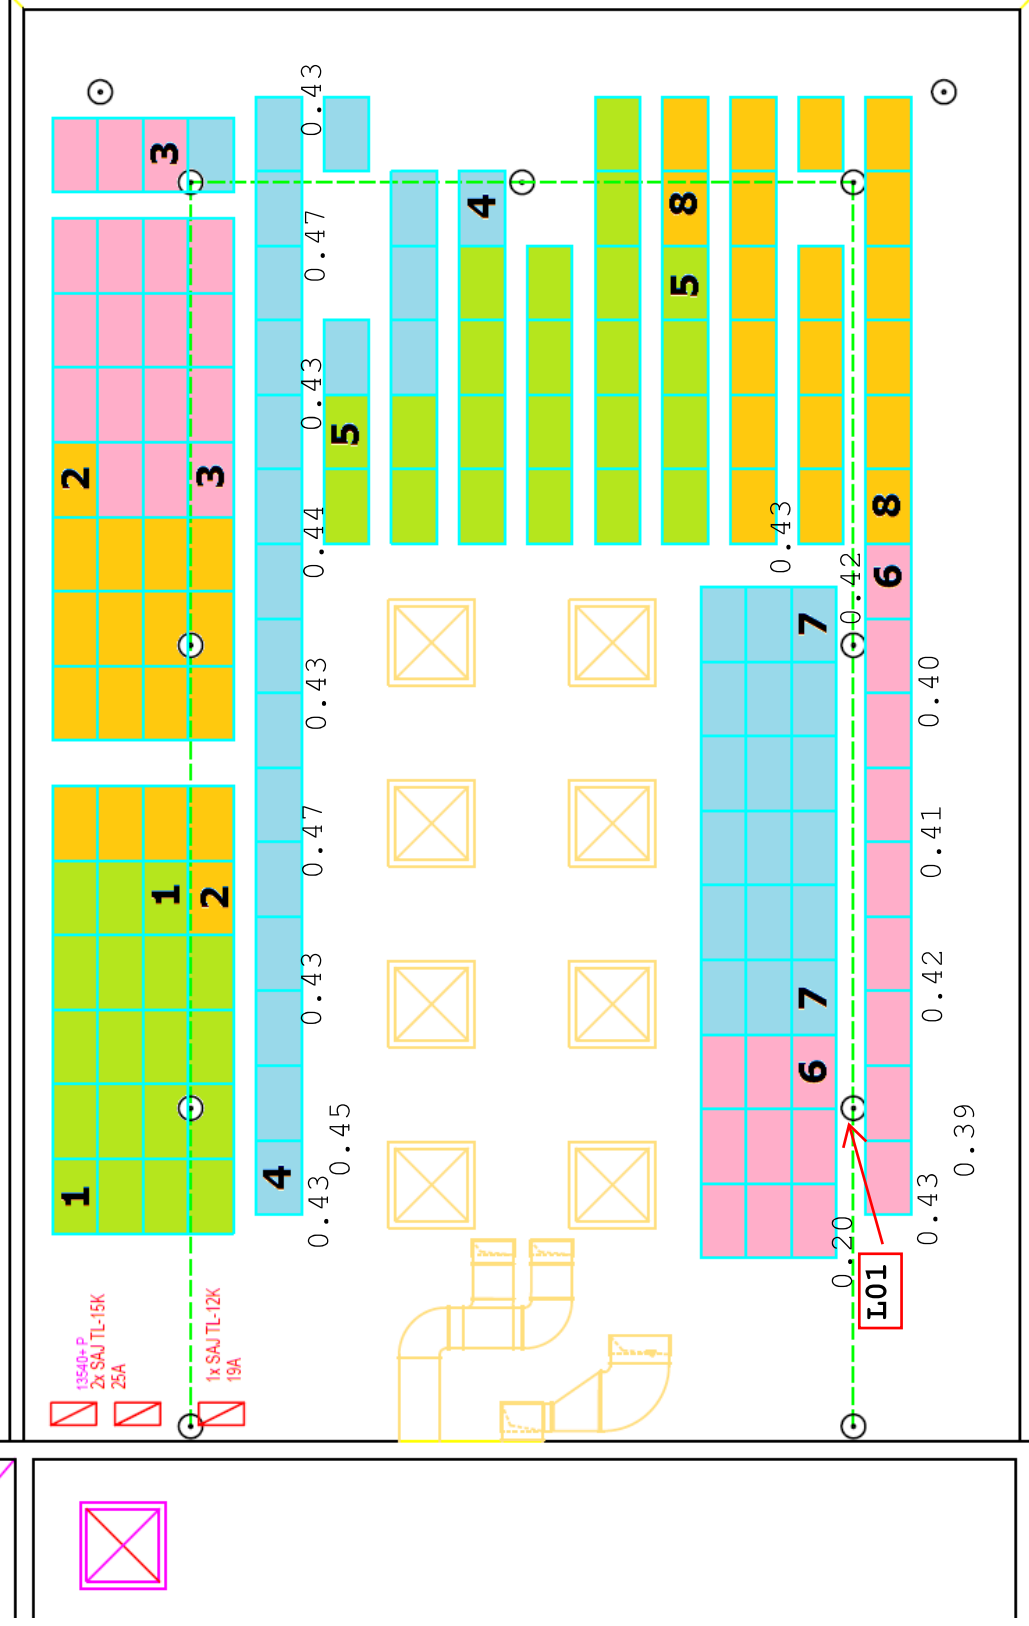

SAJ Suntrio TL15K(1)

MPP1: String 1 (19 panelen)
MPP2: String 2 + 3 (18 panelen)

SAJ Suntrio TL12K

MPP1: String 4 (22 panelen)
MPP2: String 5 (22 panelen)

SAJ Suntrio TL15K (2)

MPP1: String 6 + 7 (18 panelen)
MPP2: String 8 (19 panelen)