


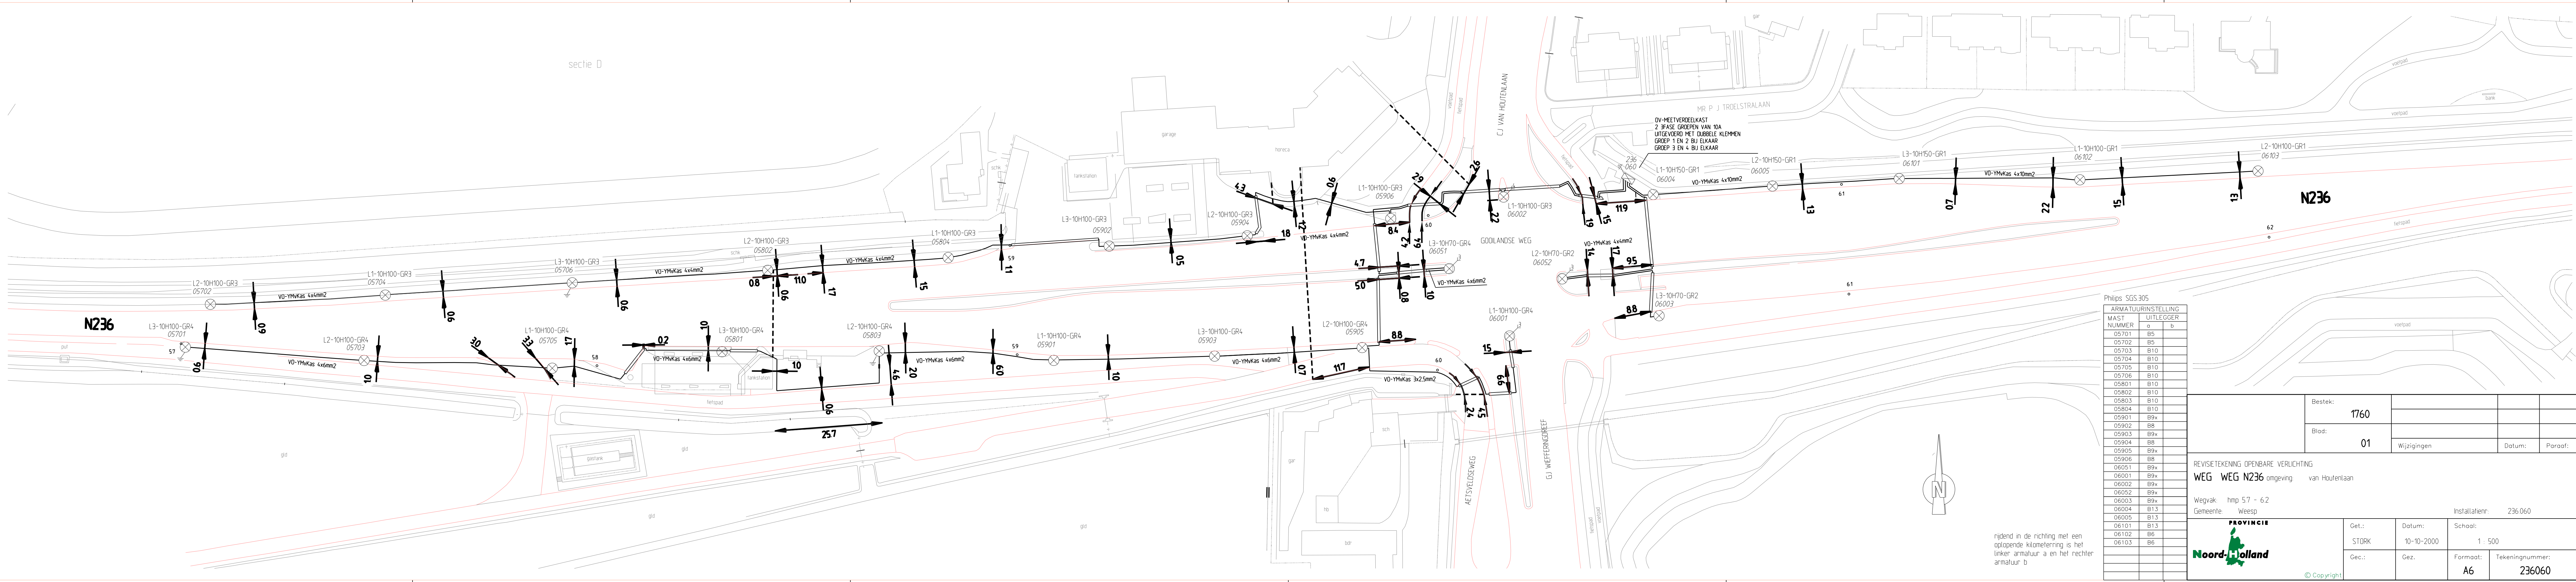

Philips SGS305

ARMATUURINSTELLING		UITLEGGER	
MAST	NUMMER	a	b
05701	B5		
05702	B5		
05703	B10		
05704	B10		
05705	B10		
05706	B10		
05801	B10		
05802	B10		
05803	B10		
05804	B10		
05901	B9x		
05902	B8		
05903	B9x		
05904	B8		
05905	B9x		
05906	B8		
06051	B9x		
06001	B9x		
06002	B9x		
06052	B9x		
06003	B9x		
06004	B13		
06005	B13		
06101	B13		
06102	B6		
06103	B6		

Bestek:	1760			
	Blad:	01		
Wijzigingen		Datum:	Paraaf:	

REVISIETEKENING OPENBARE VERLICHTING			
WEG WEG N236 omgeving: van Houtenlaan			
Wegvak: hmp 57 - 62		Installatienr: 236.060	
Gemeente: Weesp			
	Get.:	Datum:	Schaal:
	STORK	10-10-2000	1 : 500
	Gec.:	Gez.	Formaat:
			A6
		Tekeningnummer:	
		236060	