


Grid model volume computation: omtrek bdhd

Project	Test
Generated	11-12-2017 12:23:17
Grid model	172_20171017_Depot Hollands Diep
Clipping polygon	omtrek bdhd
Area of clipping polygon	517483.54 m ²
Reference	Reference fixed level: -0.50 m
Reference offset	0.00 m
Reference Z Shift	0.00 m
Volume above	0.22 m ³
Volume below	7133036.06 m ³
Volume difference	-7133035.84 m ³
Area above	4.65 m ² (0.00 %)
Area below	516109.65 m ² (99.73 %)
Area without data	1369.24 m ² (0.26 %)
Area without reference	0.00 m ² (0.00 %)
Average layer thickness	-13.82 m

Result:

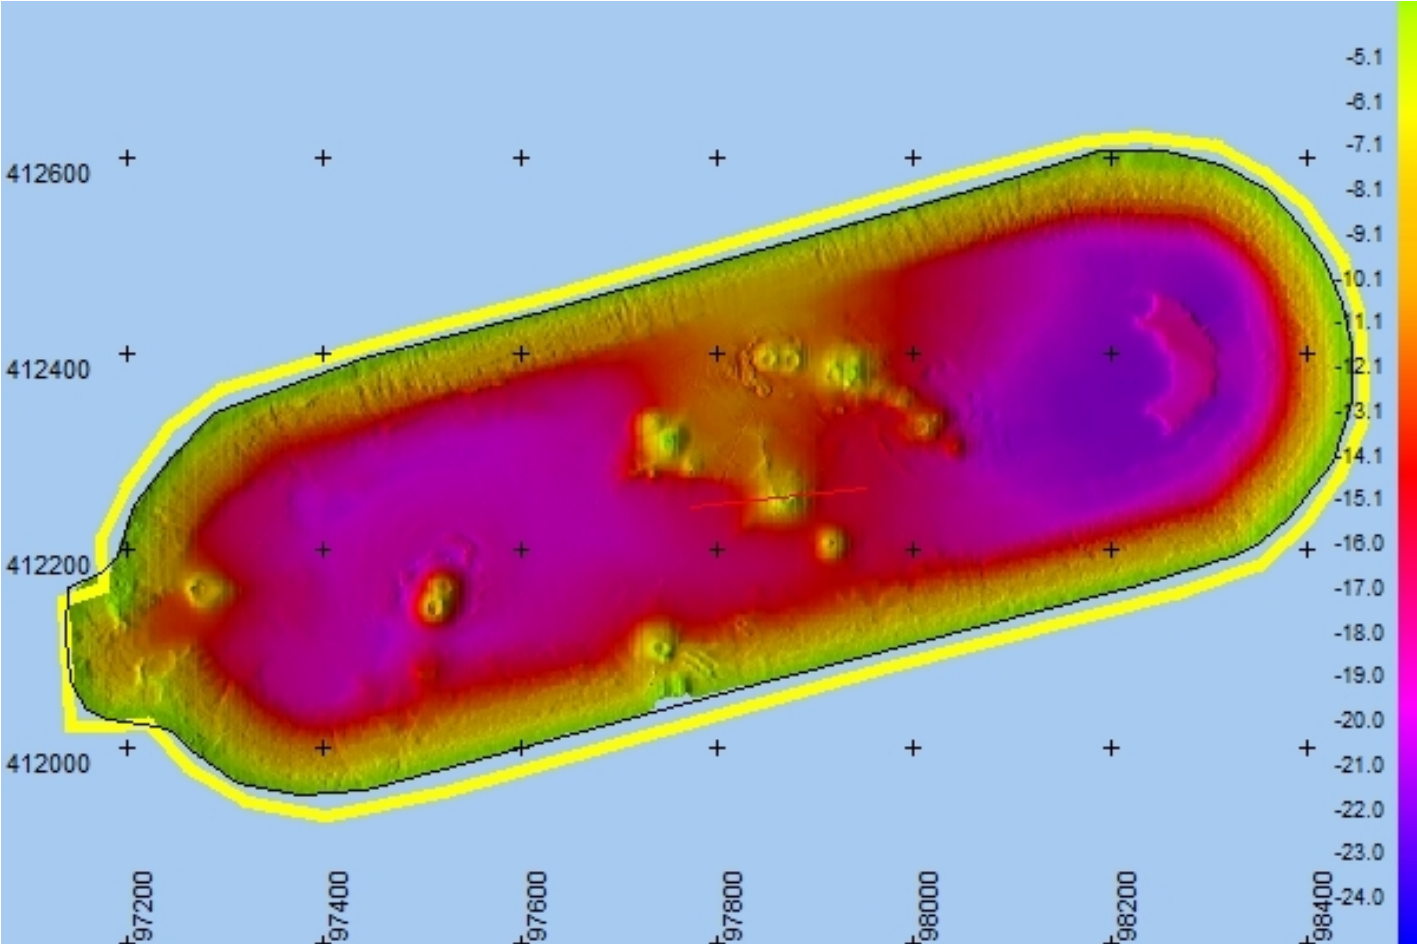

Model:

