


Grid model volume computation: omtrek dhd

Project	Test
Generated	11-12-2017 12:19:26
Grid model	172_20171017_Depot Hollands Diep
Clipping polygon	omtrek dhd
Area of clipping polygon	567512.03 m ²
Reference	Reference Grid Model: 172 20161012_Depot_Moerdijk_MB_1x1 m
Reference offset	0.00 m
Reference Z Shift	0.00 m
Volume above	210978.73 m ³
Volume below	14805.84 m ³
Volume difference	196172.89 m ³
Area above	387198.73 m ² (68.23 %)
Area below	133515.89 m ² (23.53 %)
Area without data	4825.17 m ² (0.85 %)
Area without reference	41972.24 m ² (7.40 %)
Average layer thickness	0.38 m

Result:

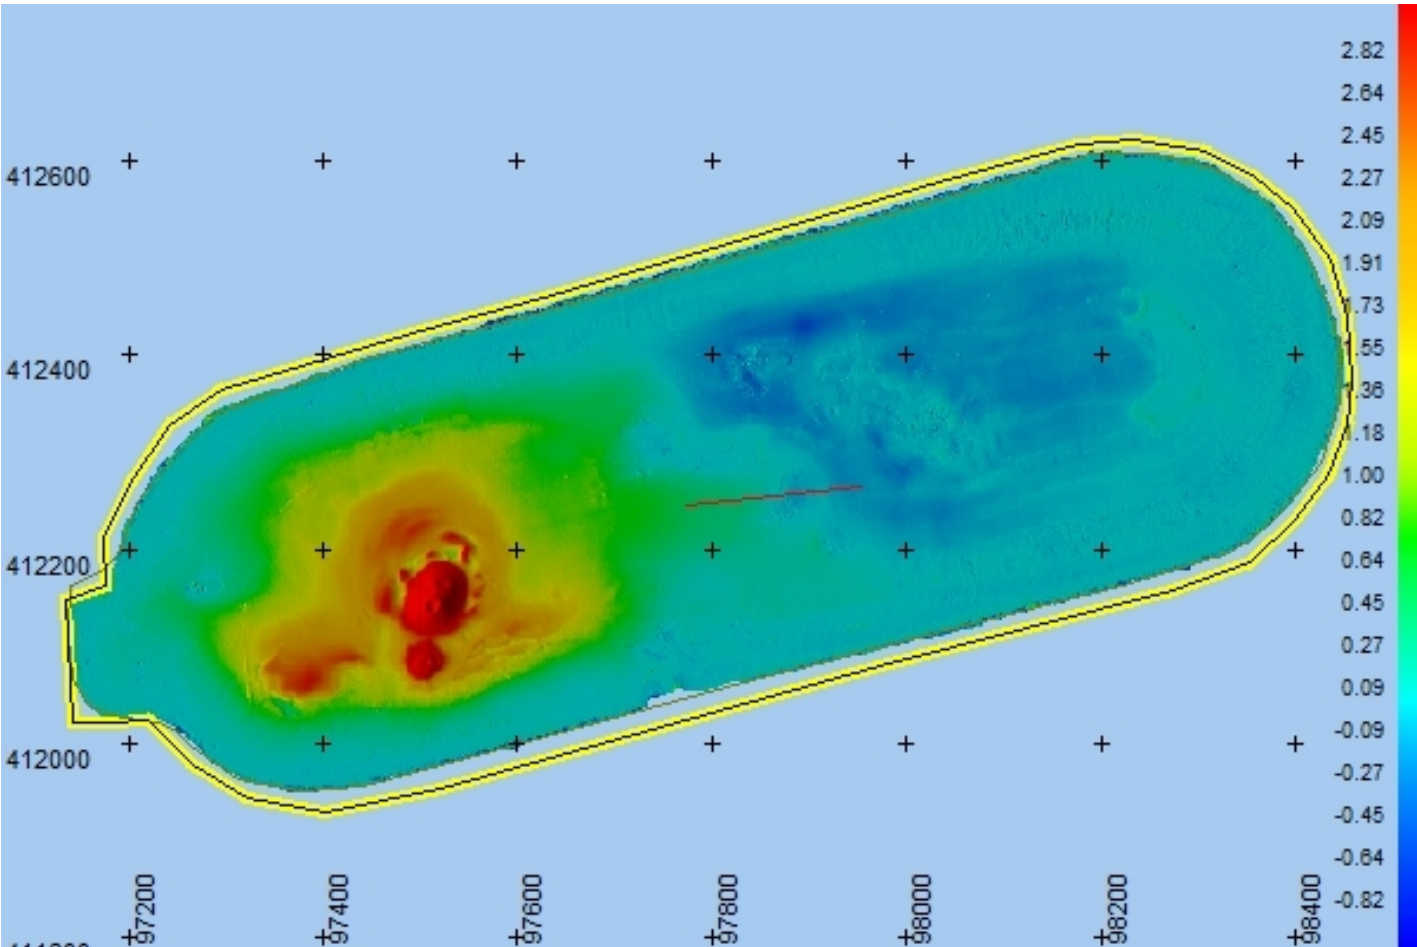

Model:

