


Detailtekening

papierformaat [A3]

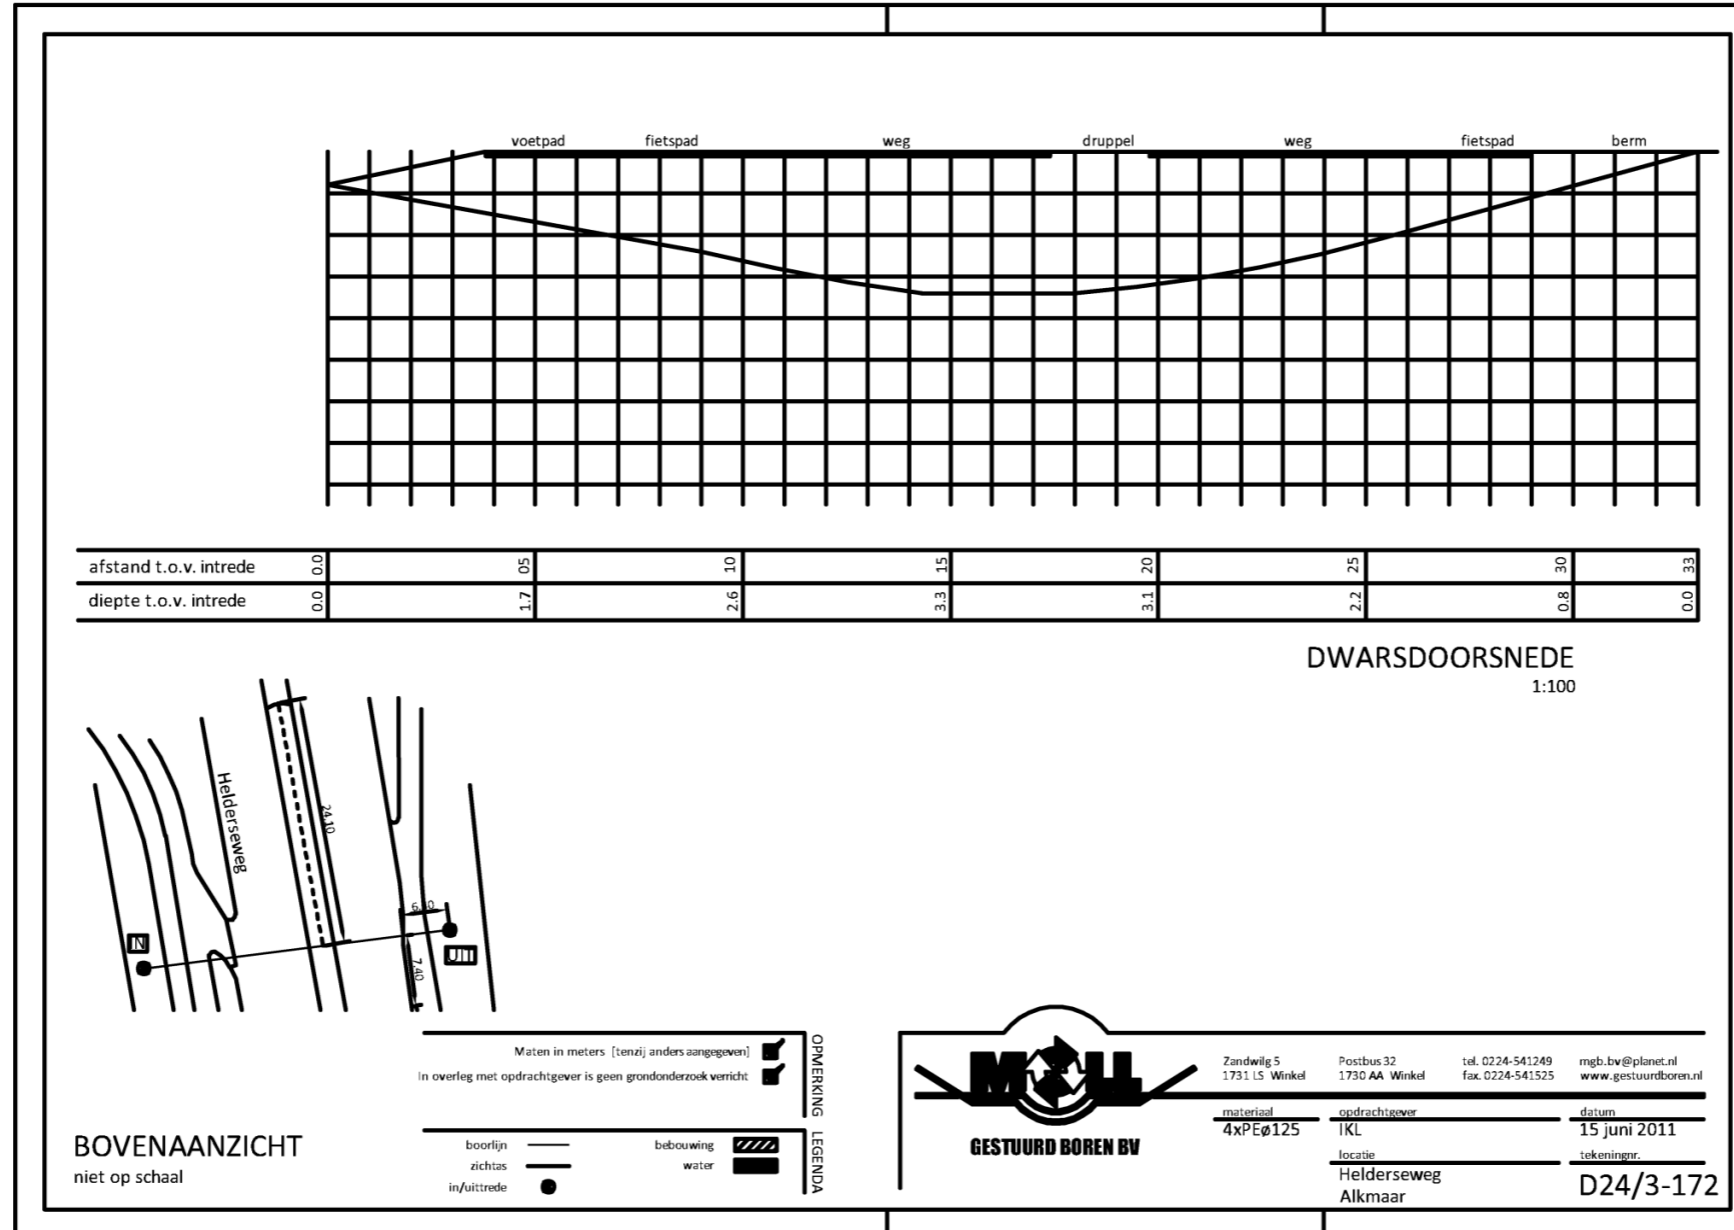

Thema: middenspanning

Tekeningnummer: 502412403