


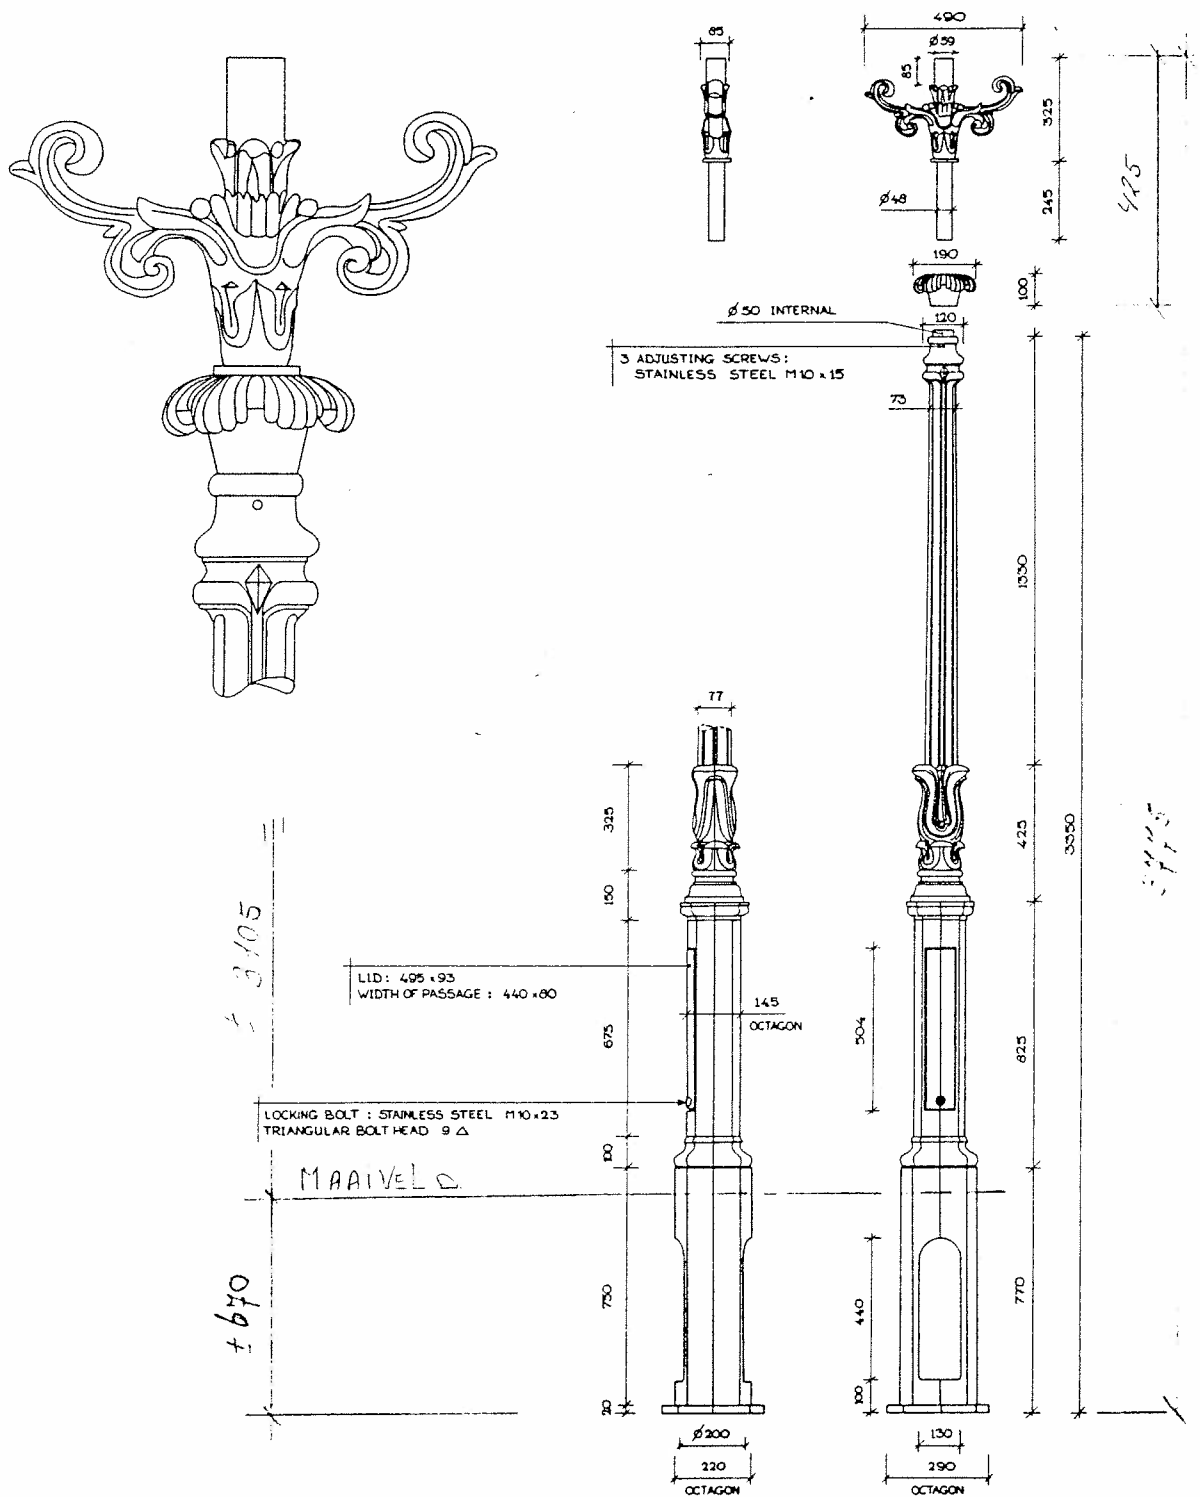

CAST-IRON LAMP POST
FA. JOBSE - MIDDELBURG - HOLLAND

KOPERSLAGERIJ
DE NOOD MIDDELBURG B.V. I.o.
(v.o.s. Koperslagertij, Jobse)
Gaspartij, ag. 3-7, Postbus 182
3300 AD MIDDELBURG
(t. 01180-33405 (6 l. g. 13412)