



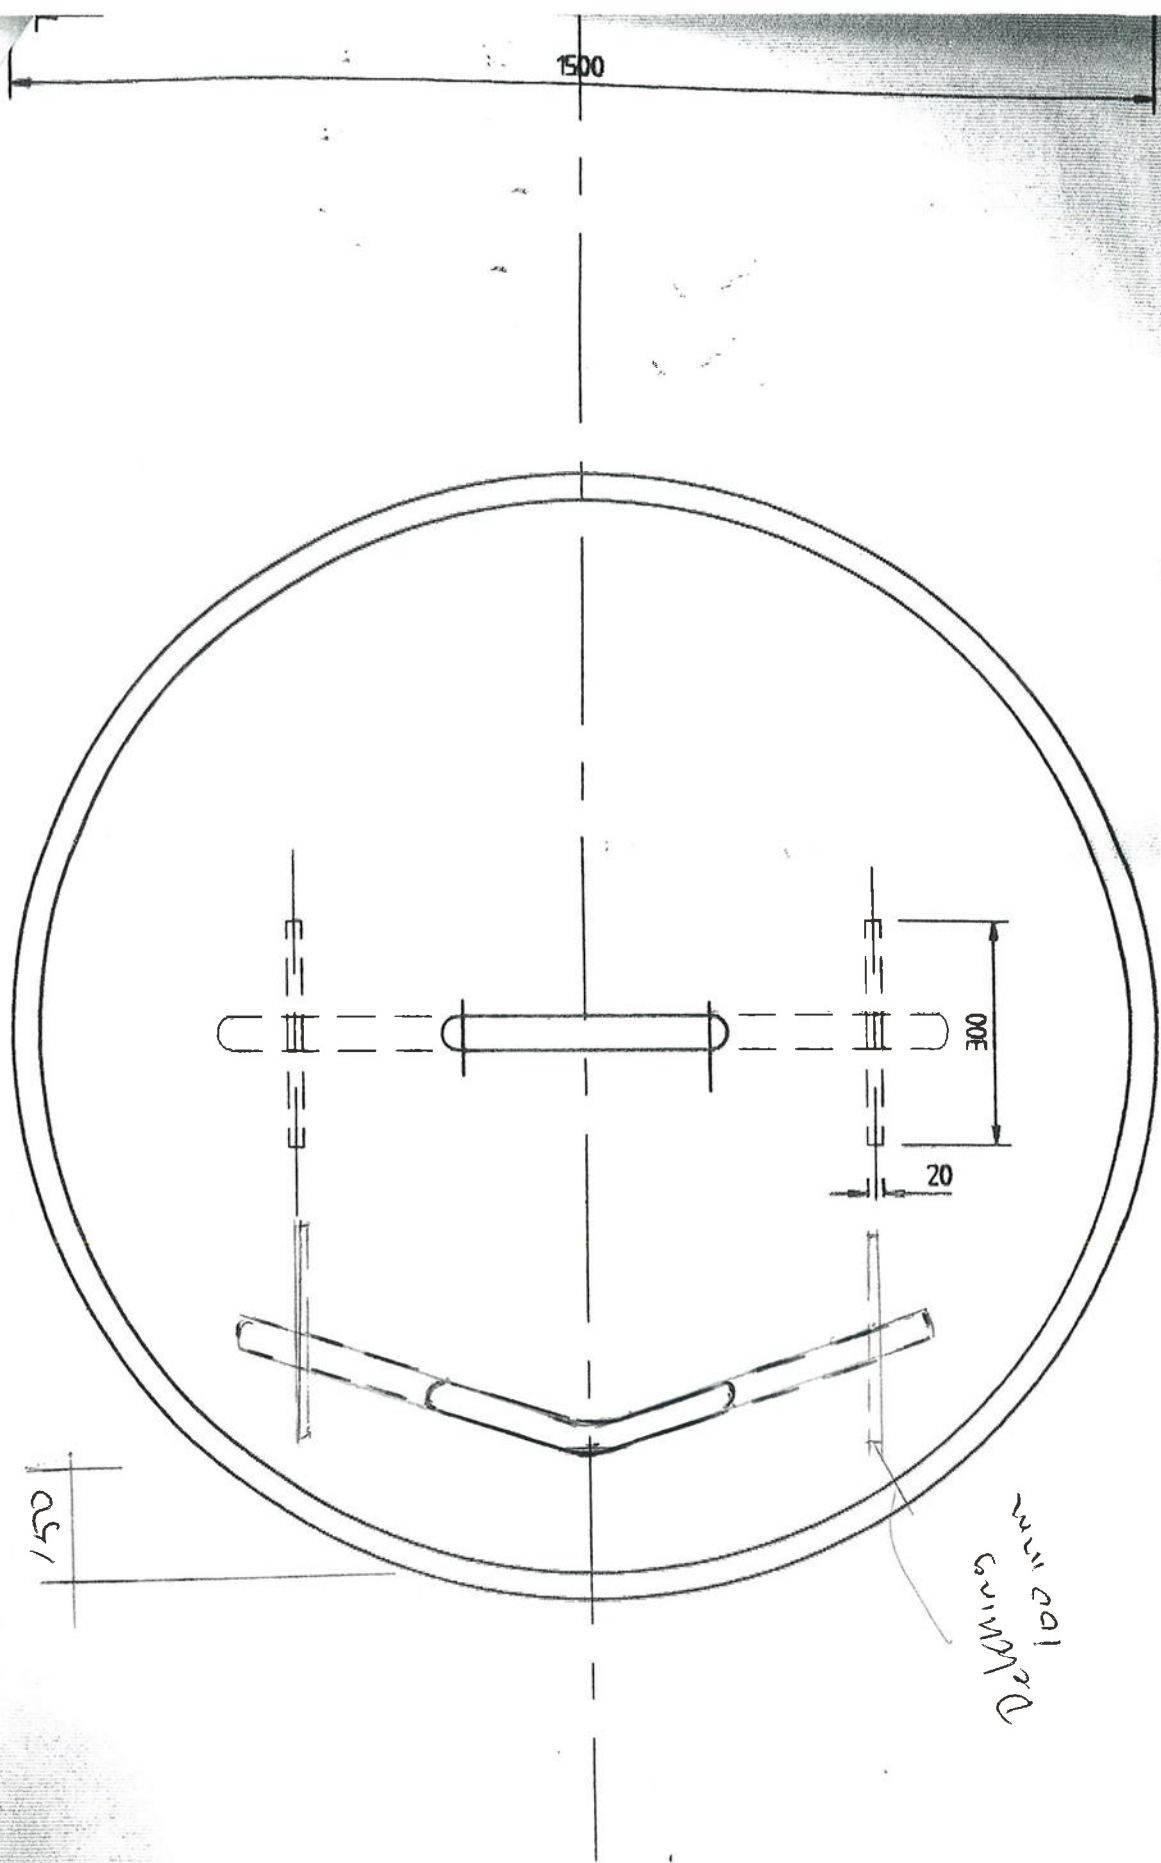

Tonsteen 1e grootte A.

2 ogen.

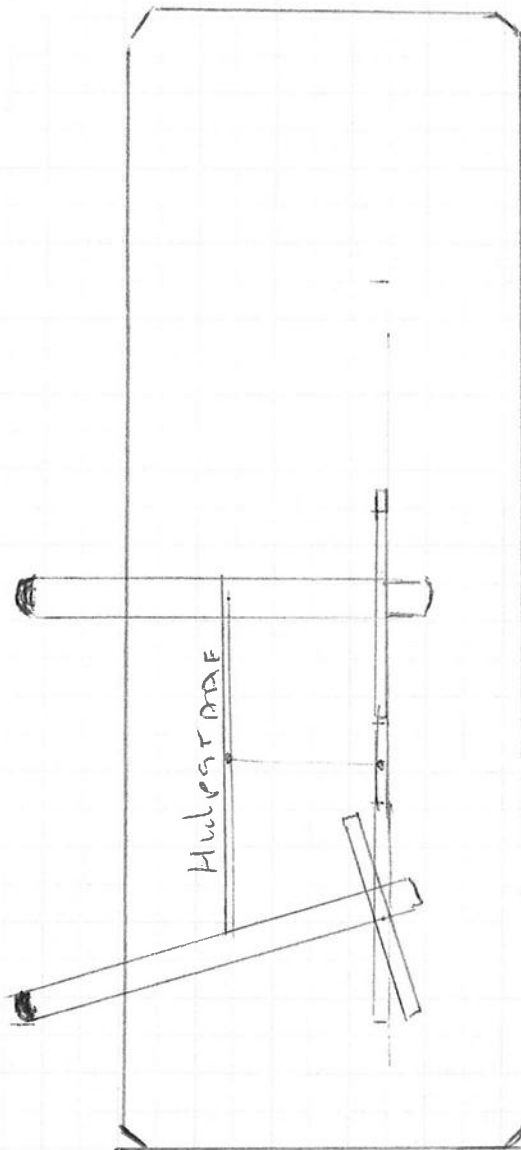

T^e g. A.

| 150 |

15-09-01

D