


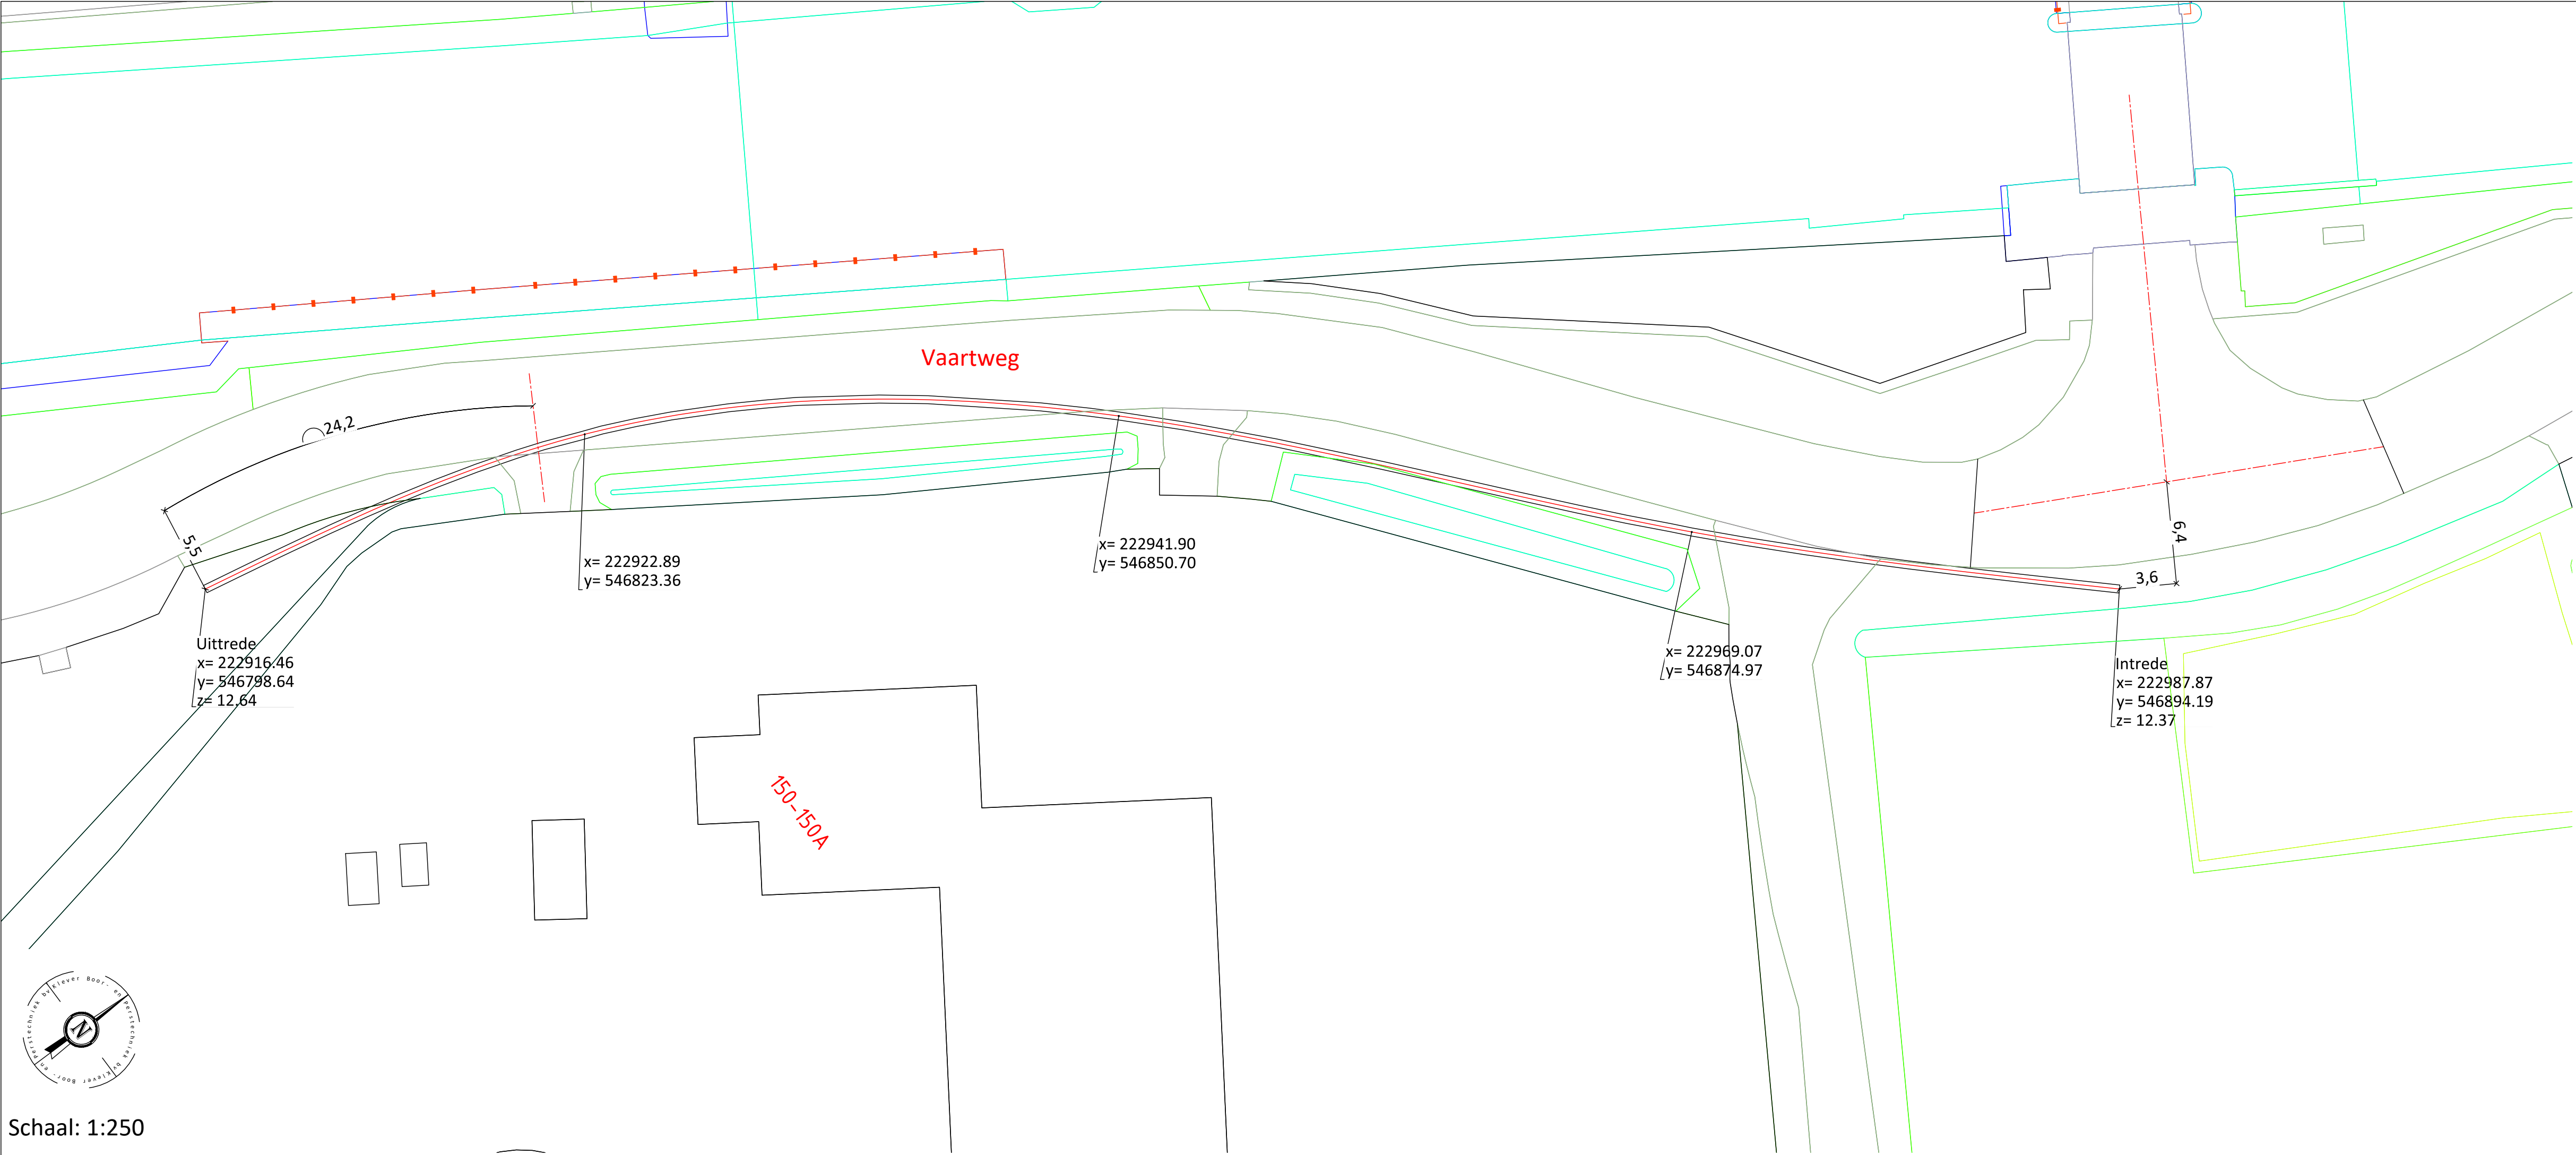

Schaal: 1:250

